



5 cm

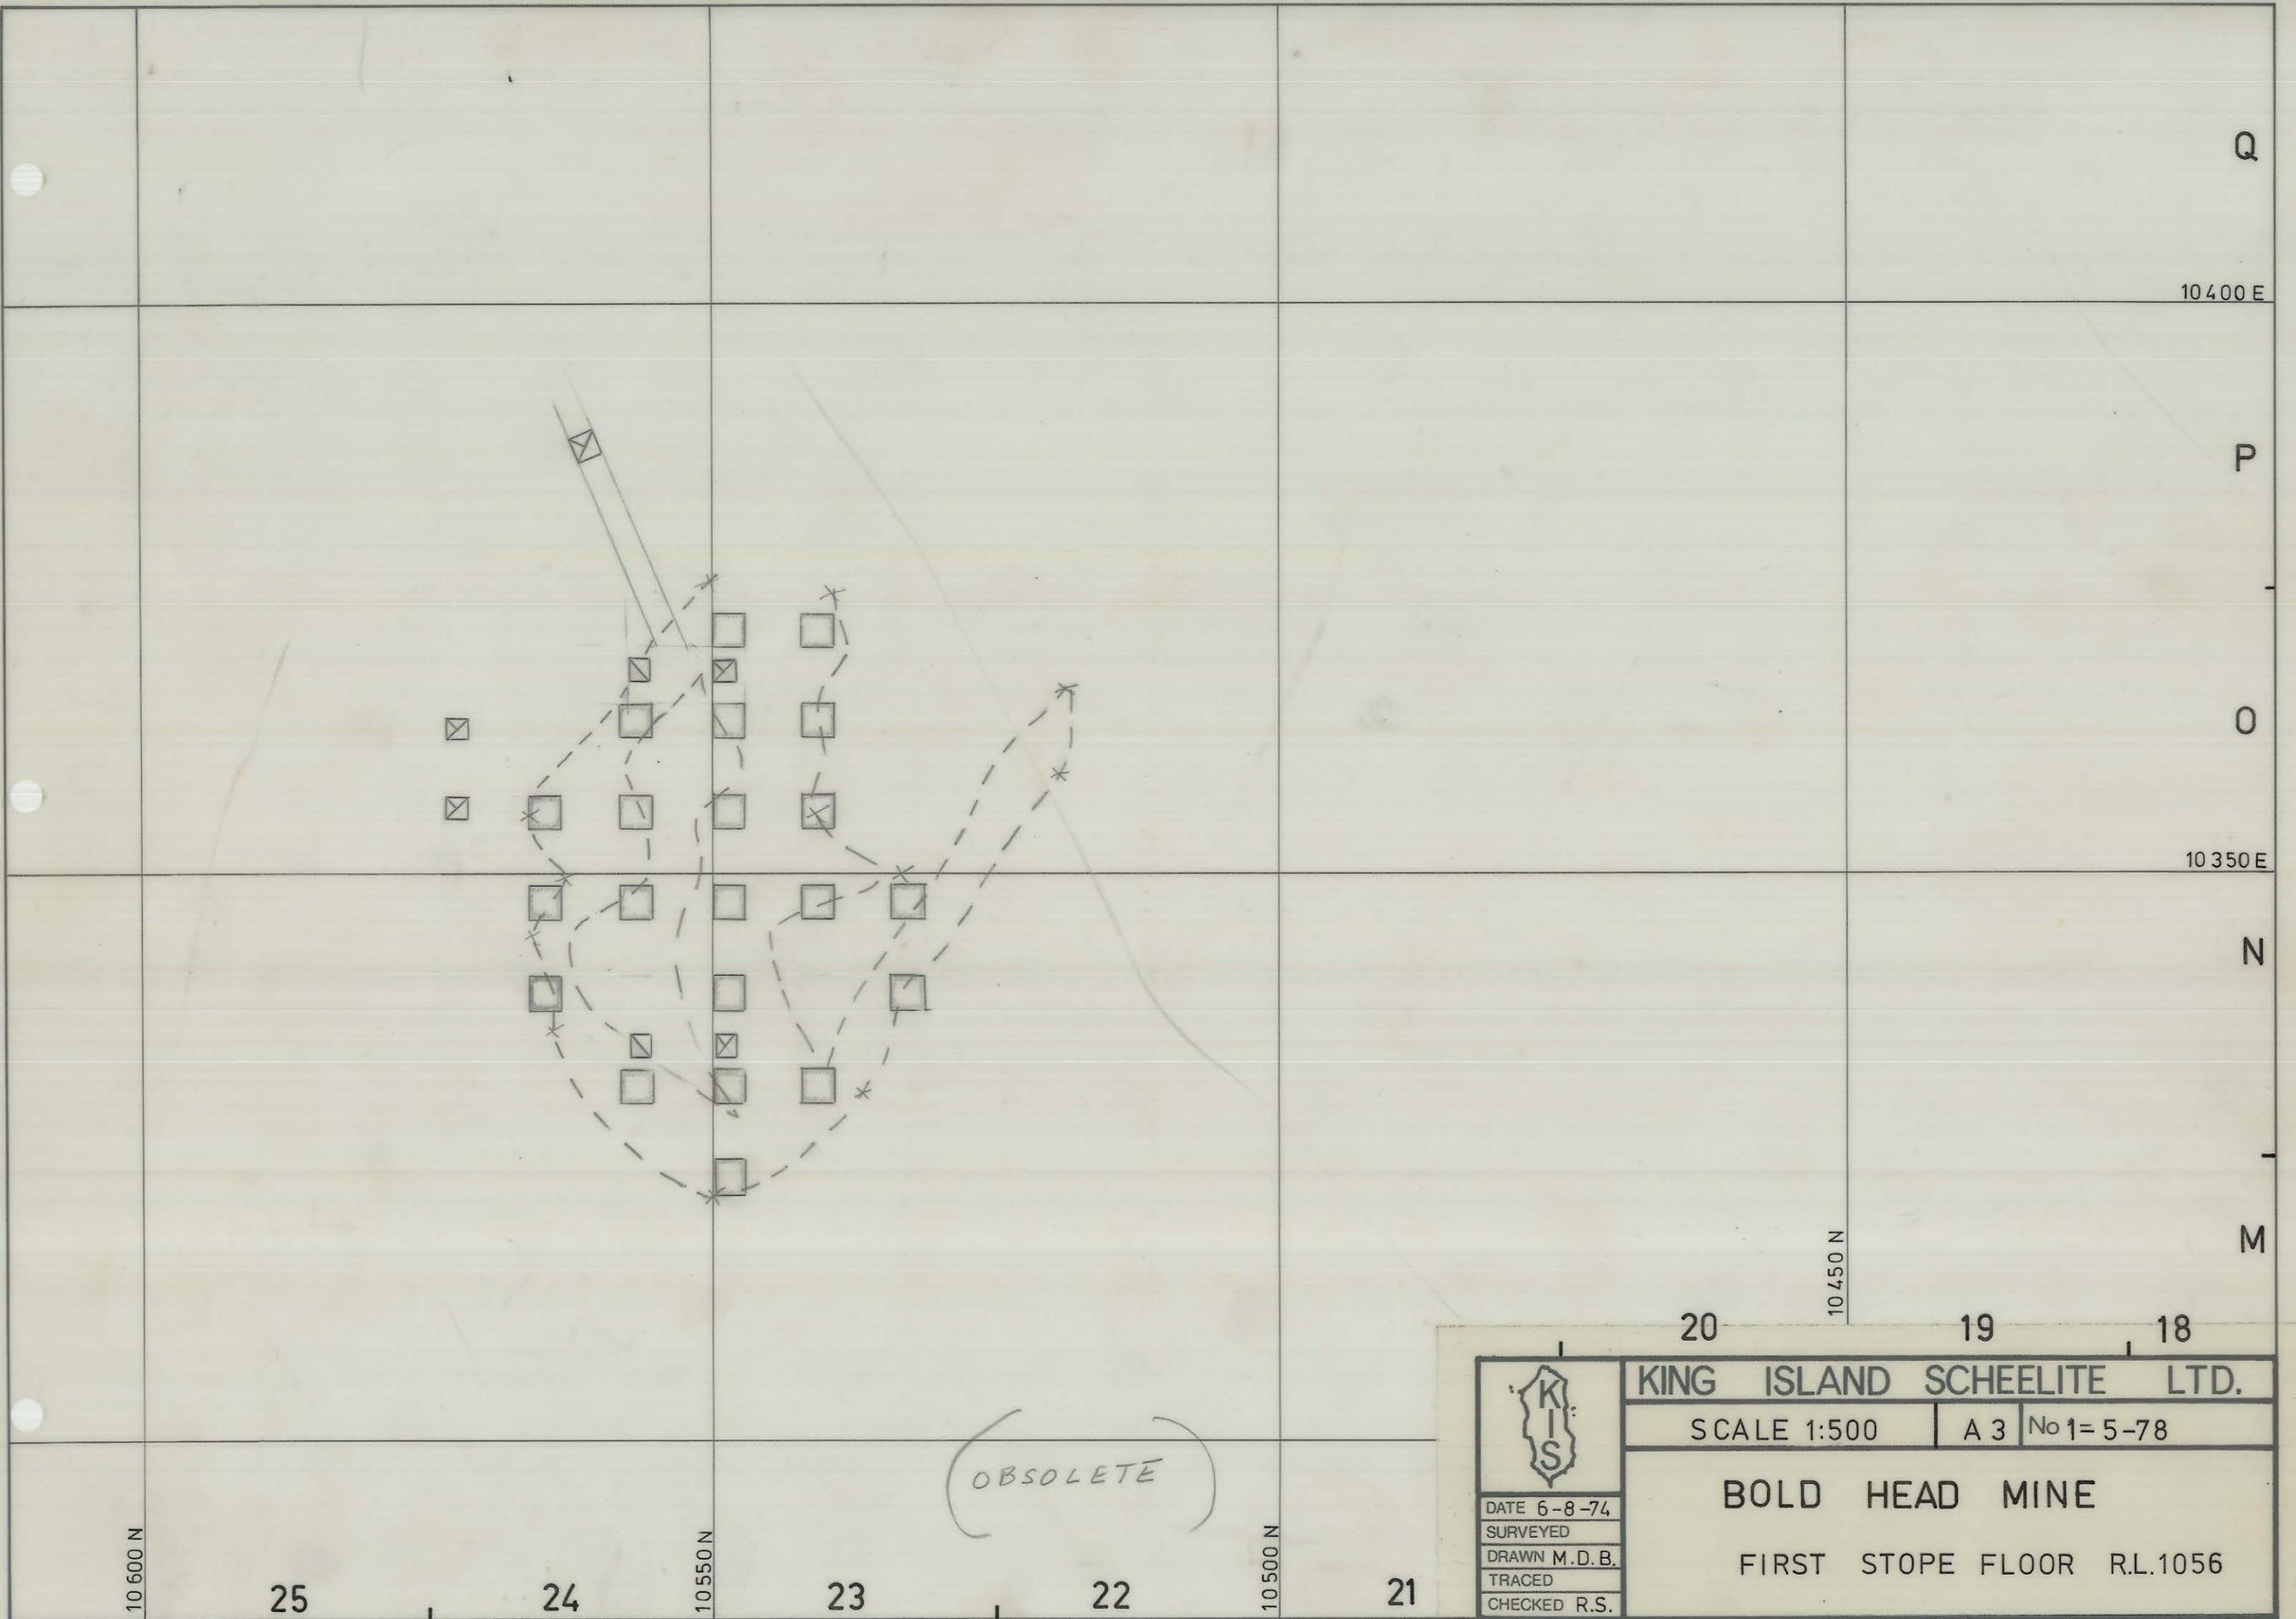

(OBSOLETE)

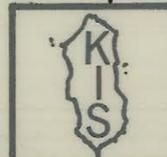

DATE 6-8-74  
 SURVEYED  
 DRAWN M.D.B.  
 TRACED  
 CHECKED R.S.

KING ISLAND SCHEELITE LTD.

SCALE 1:500 | A 3 | No 1=5-78

BOLD HEAD MINE

FIRST STOPE FLOOR R.L.1056

20 19 18

10450 N

10600 N

25

24

10550 N

23

22

10500 N

21

Q

10400 E

P

O

10350 E

N

M