


0374_3787

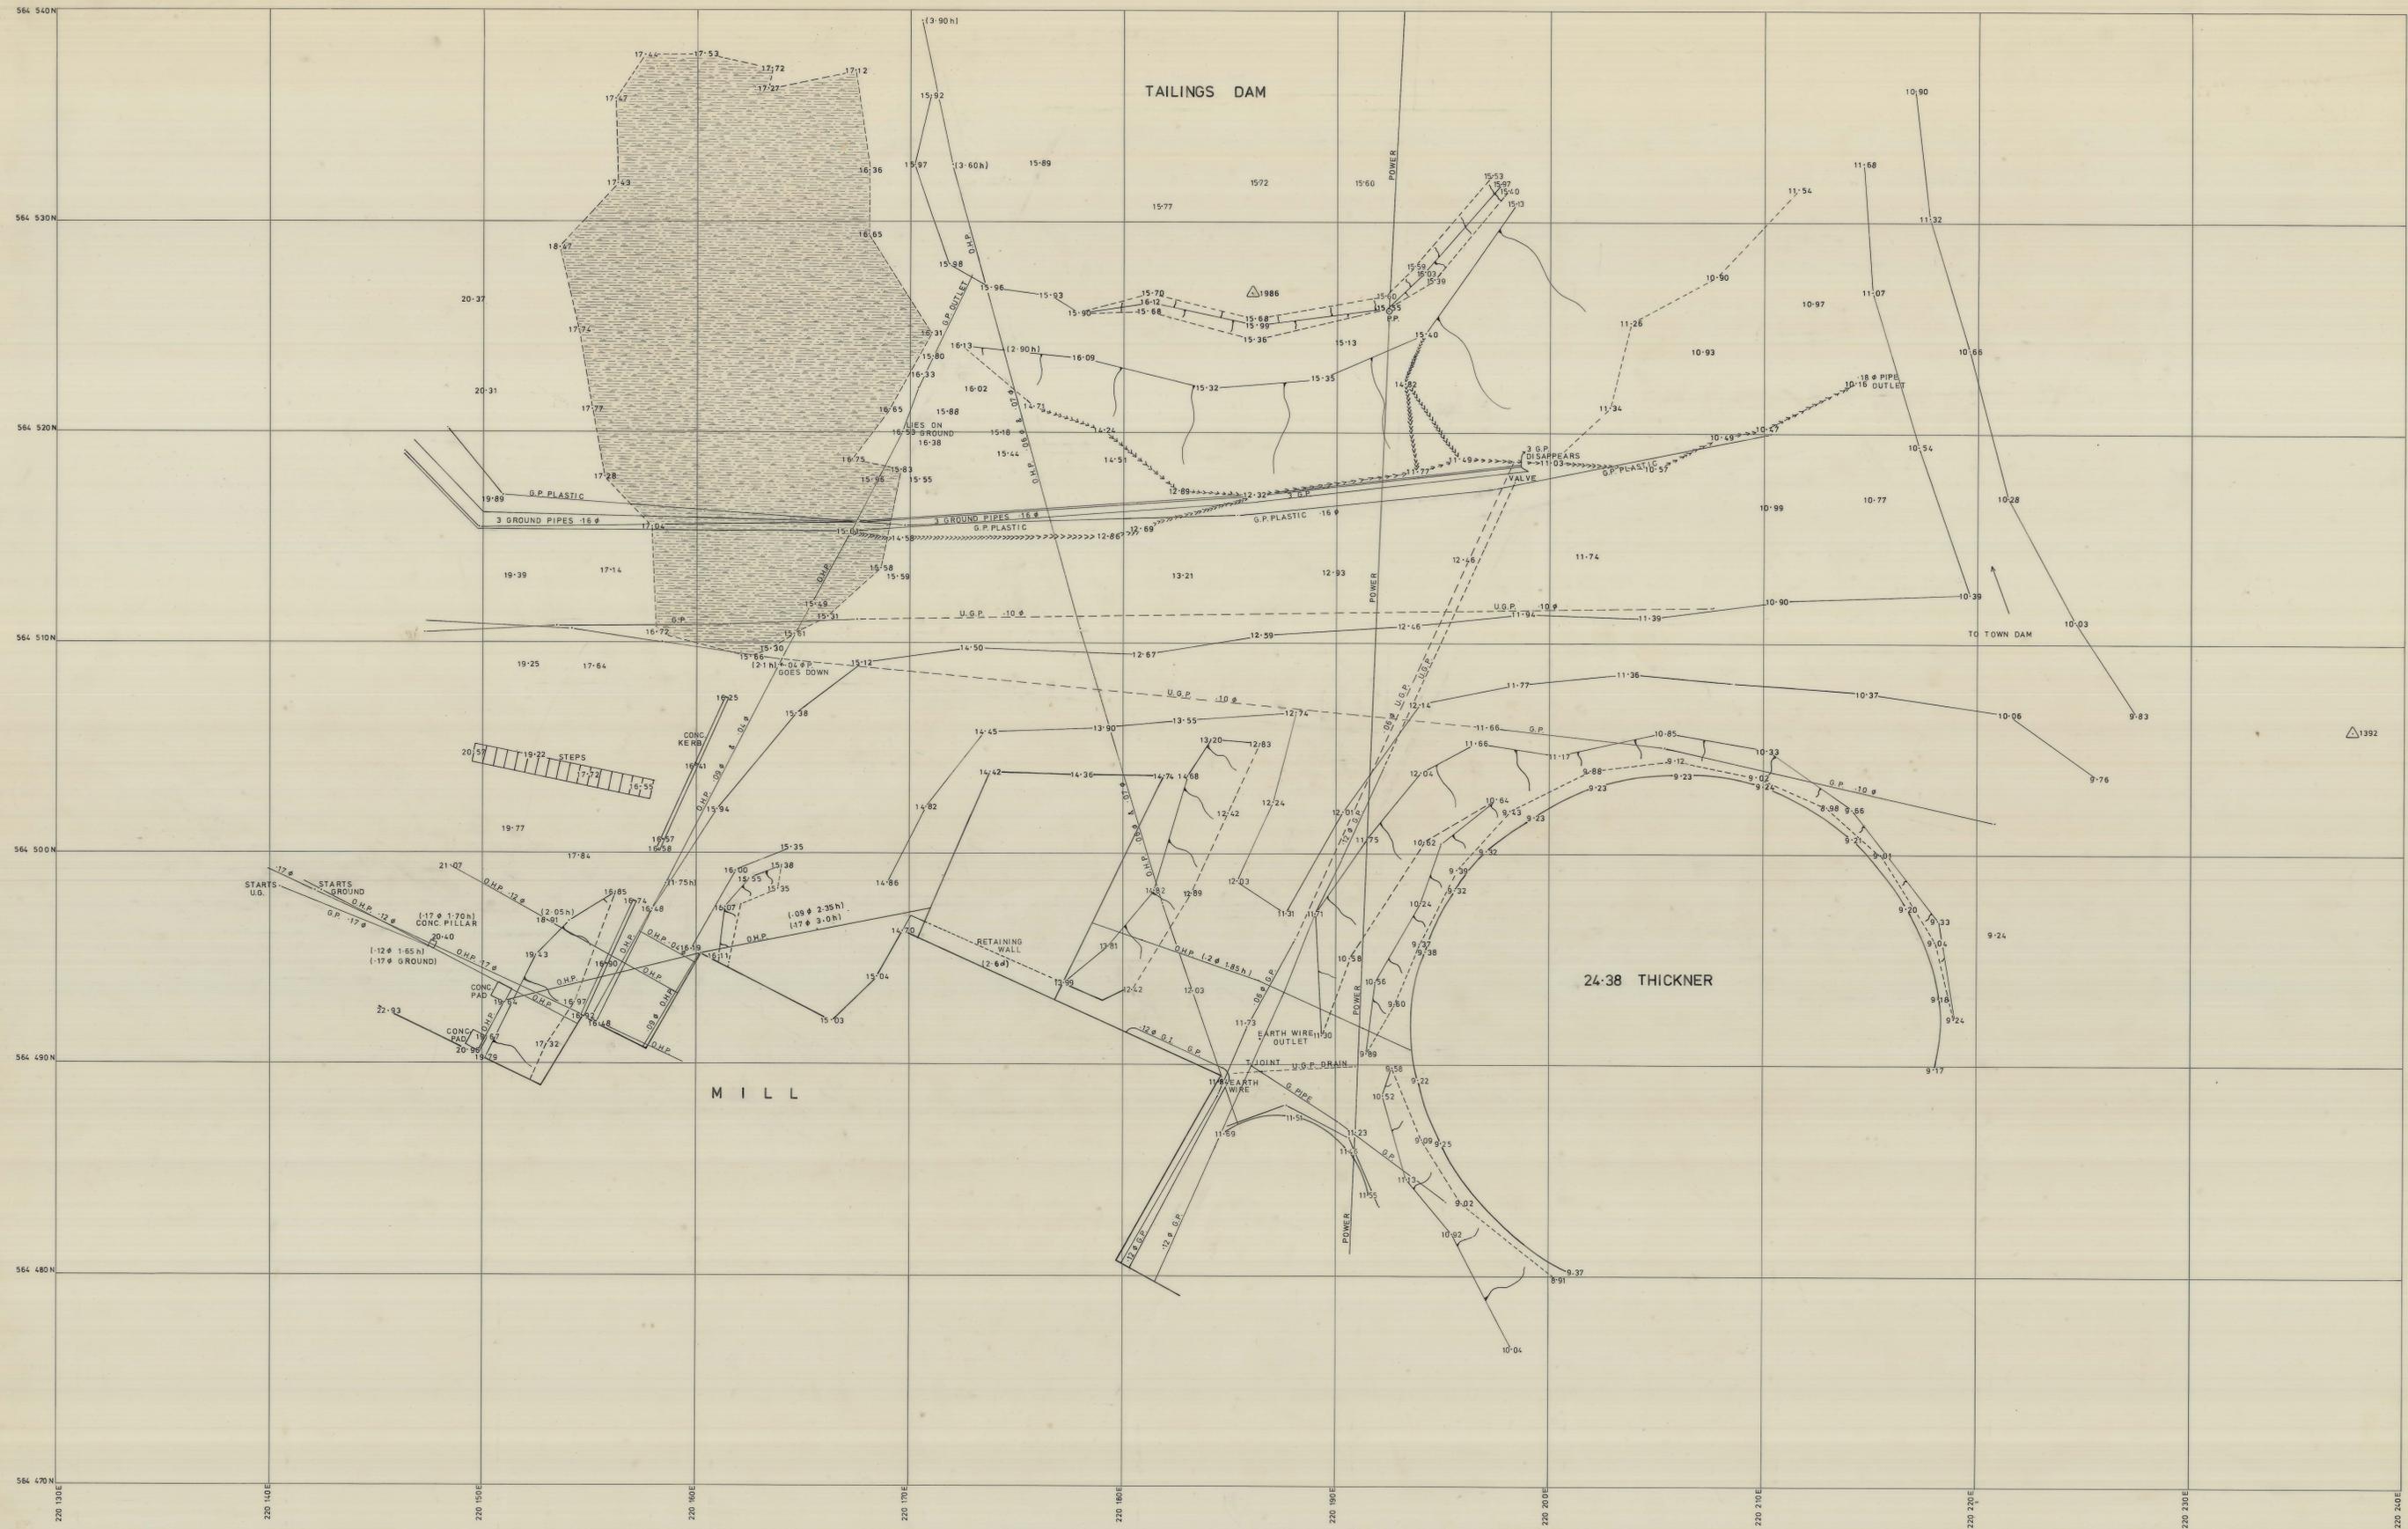

O.H.P. - OVER HEAD PIPE
 G.P. - PIPE ON GROUND
 U.G.P. - UNDER GROUND PIPE
 h - HEIGHT
 d - DEPTH
 φ - DIAMETER

NOTE
 ALL LEVELS BEING ON
 TALLAROOK DATUM

	KING ISLAND SCHEELITE LTD.	
	Scale: 1:100	No 1-
PROPOSED SITE OF BENEFICIATED SCHEELITE PLANT		
DATE: 10-4-1973	SURVEYED: R.M.H.	
DRAWN: J.S.W.	TRACED: J.S.W.	
CHECKED: R.M.H.		

