




0374_3815

1-22-51
DOLPHIN MINE
LOCATION OF SERVICES
1"=50'

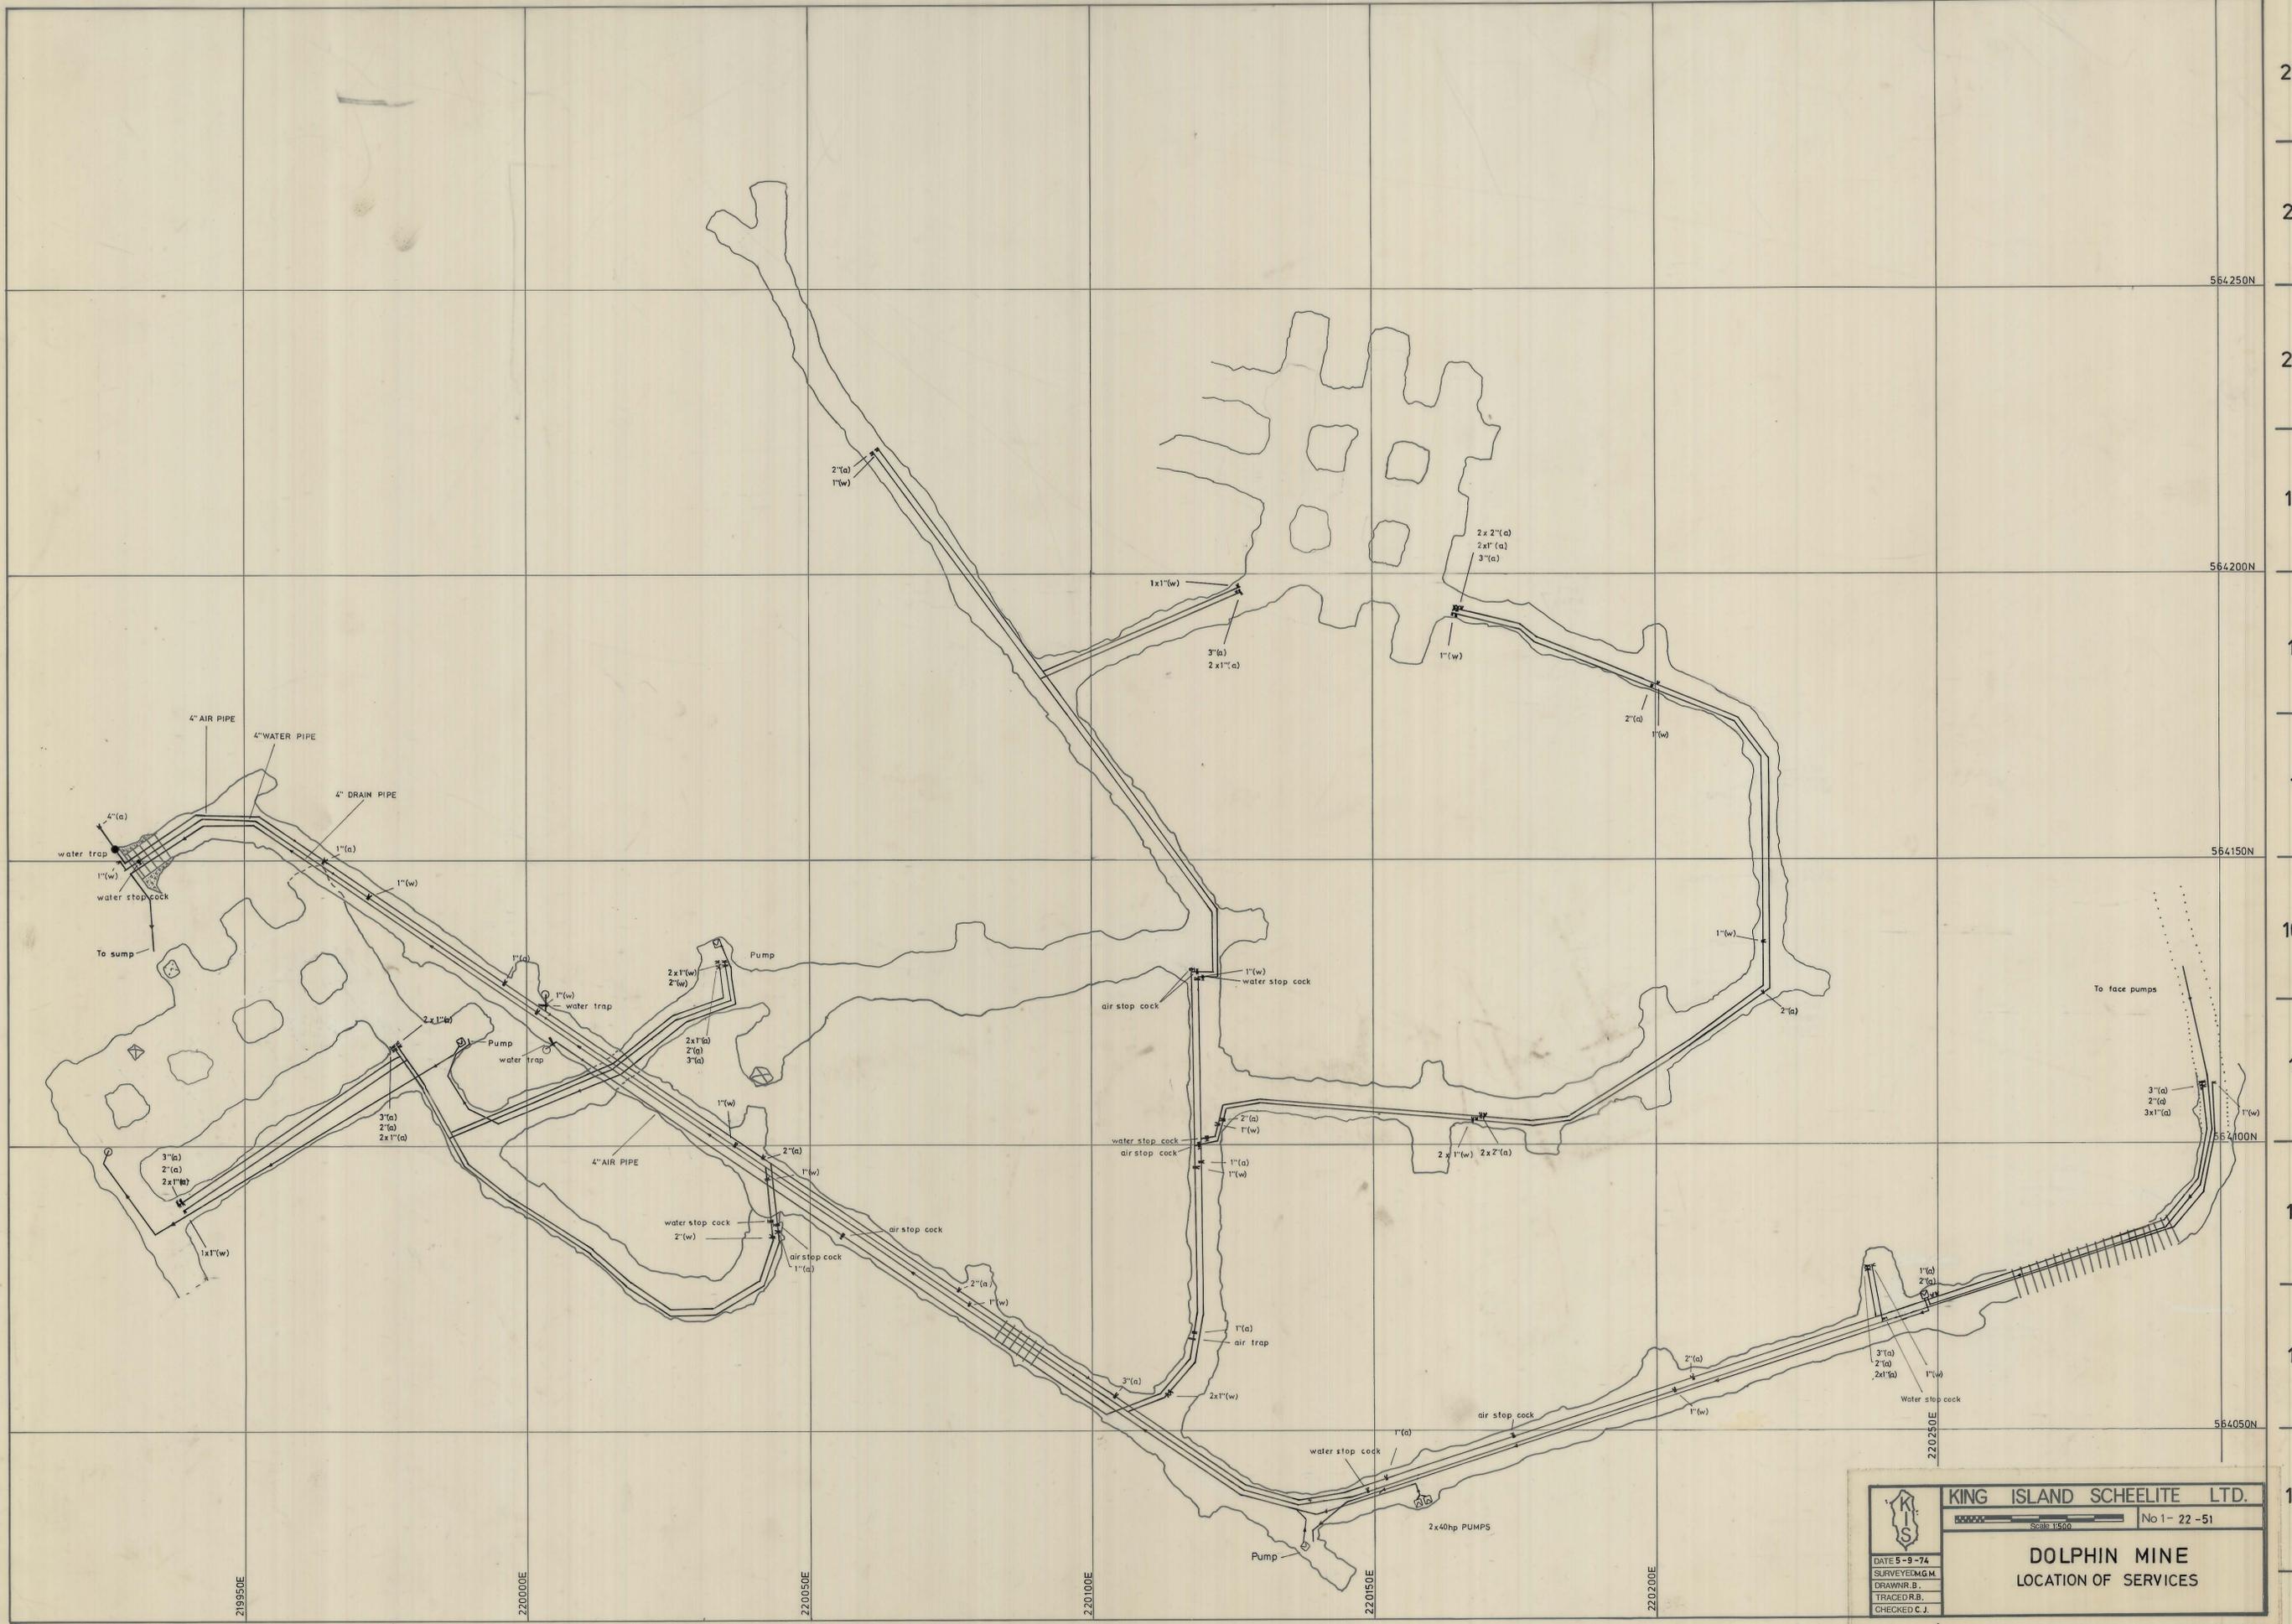

22
21
20
19
18
17
16
15
14
13
12

D | E | F | G | H | I | J | K | L | M | N | O | P | Q | R | S

	KING ISLAND SCHEELITE LTD.	
	No 1-22-51	
	DOLPHIN MINE LOCATION OF SERVICES	
	DATE 5-9-74 SURVEYED M.G.M. DRAWN B.S. TRACED R.B. CHECKED C.J.	