


0374\_3822

DOLPHIN MINE  
1:250  
UNRECYCLED  
PAPER

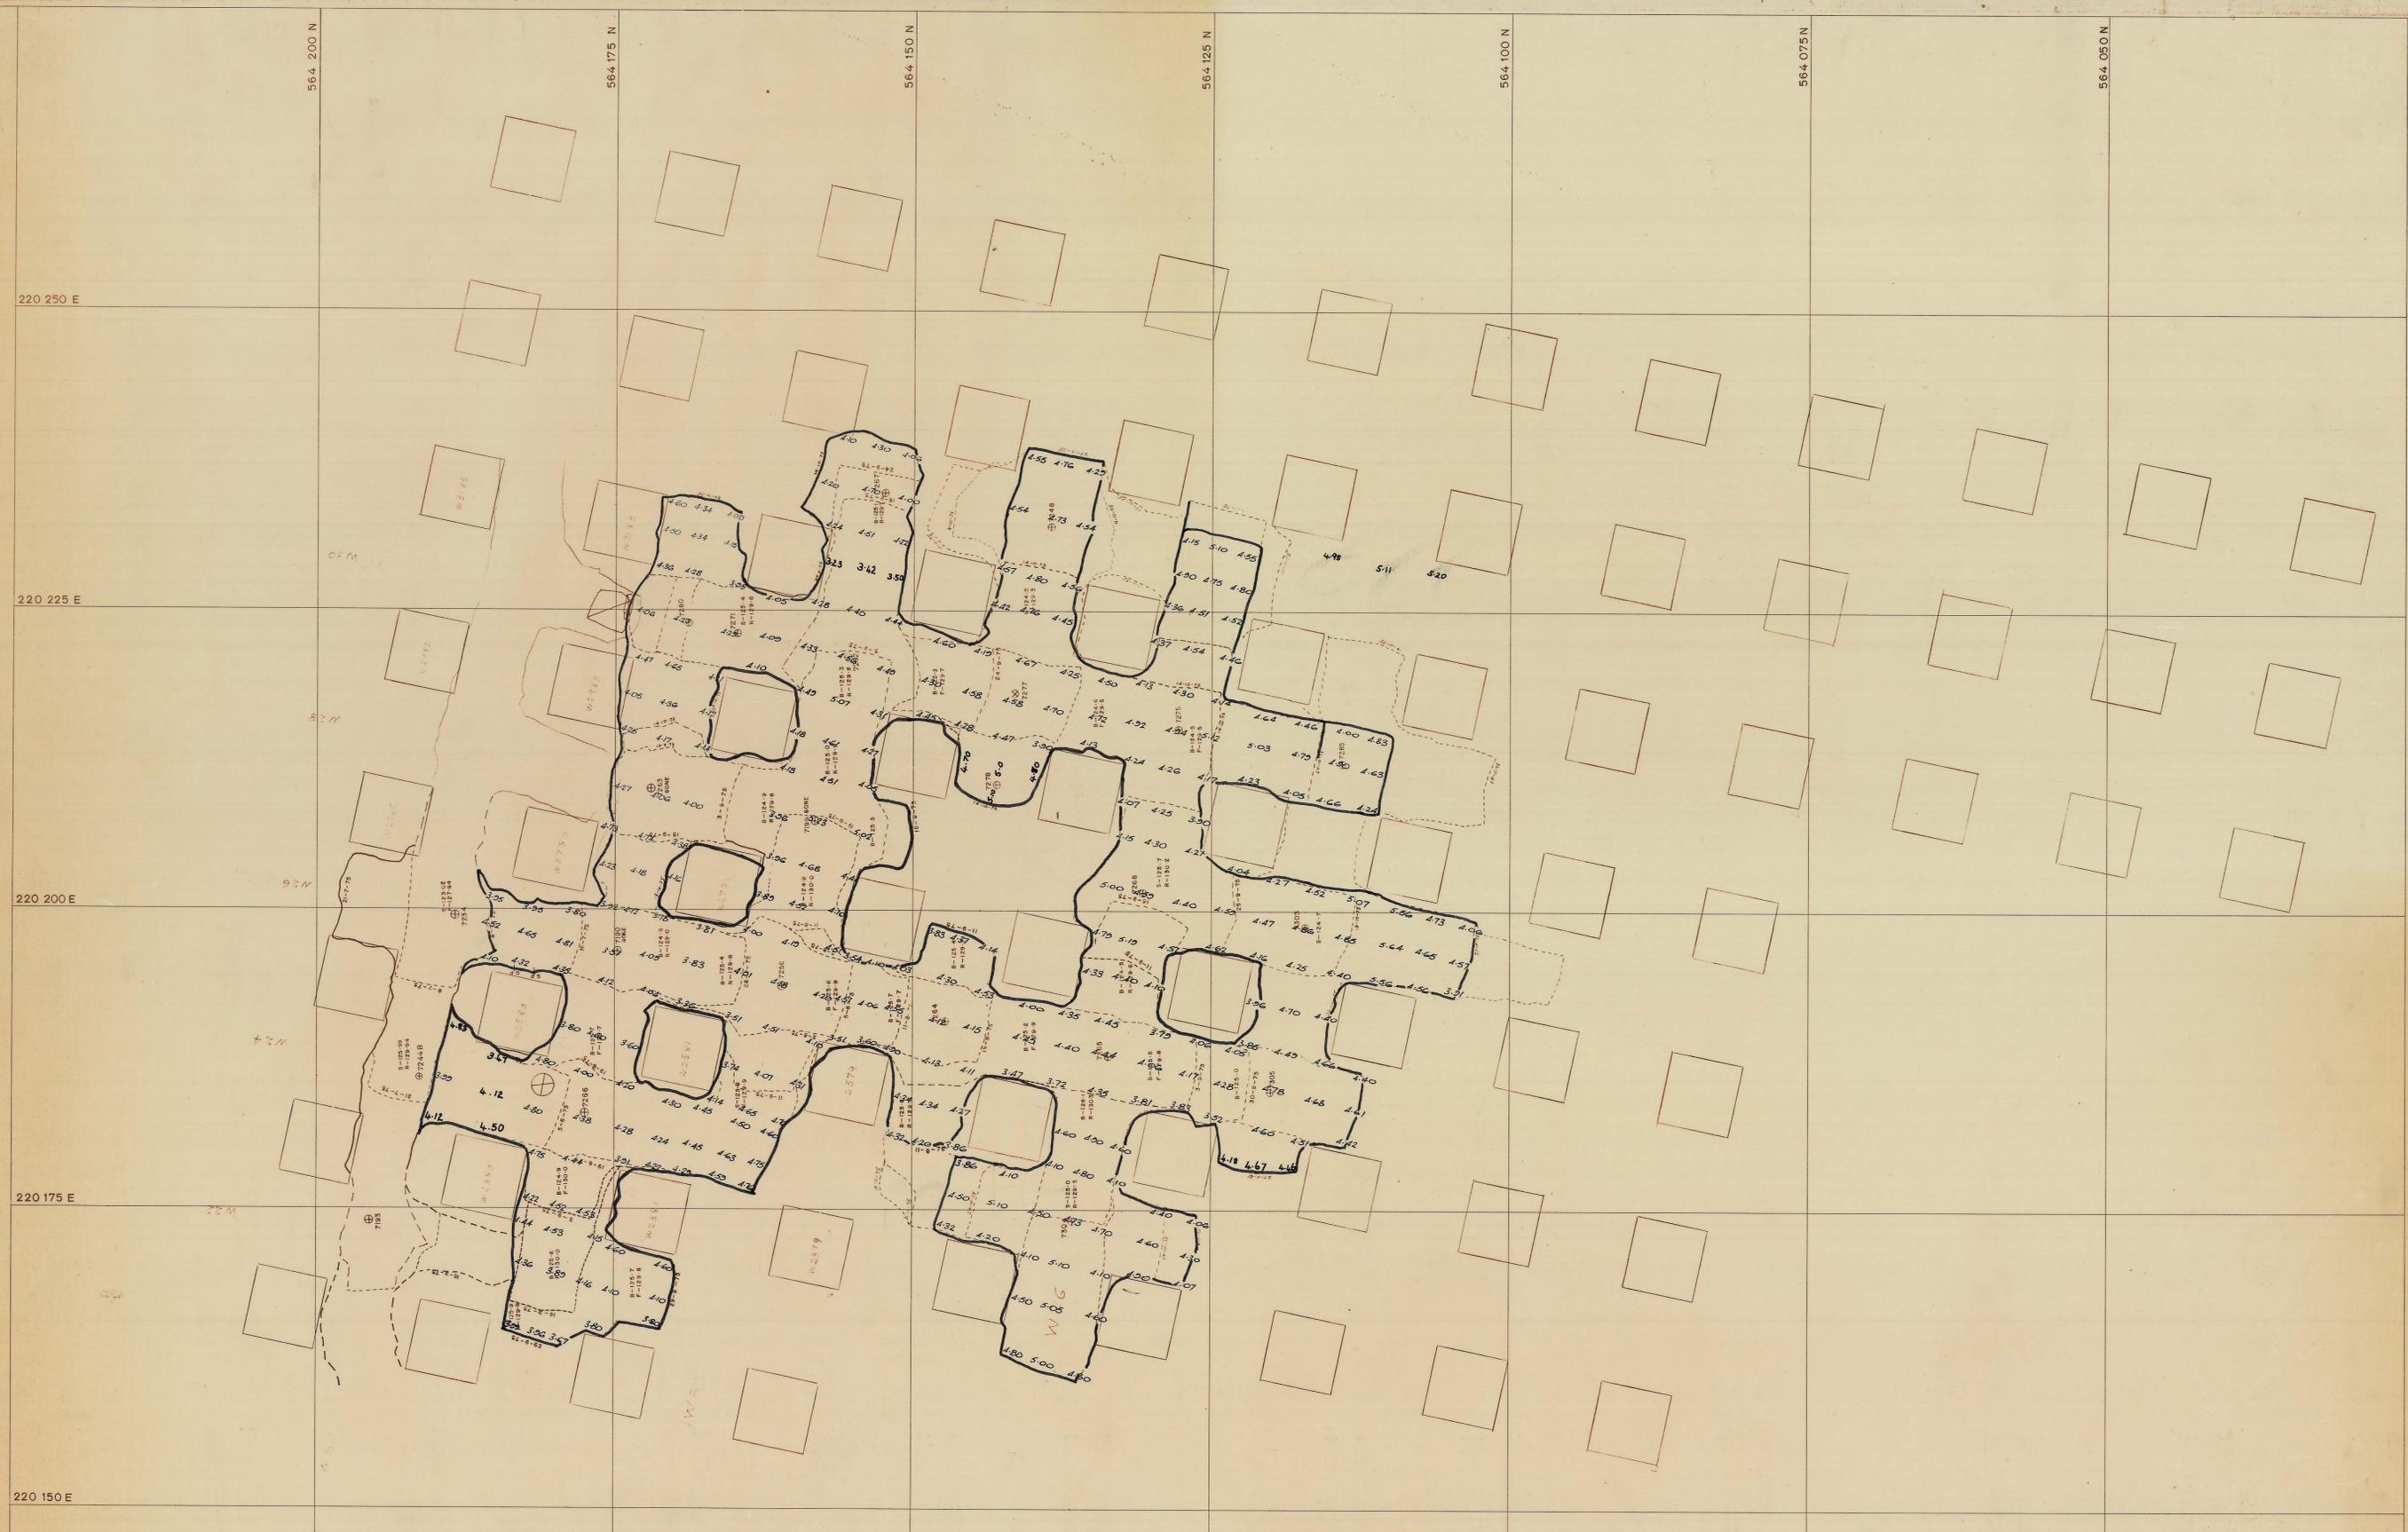

——— OUTLINE AT END OF PERIOD 4.  
 12,626 m<sup>3</sup> = ACTUAL VOLUME  
 16,076 m<sup>3</sup> = VOLUME IF DRINES WERE 8m x 5m.

	KING ISLAND SCHEELITE		
	SCALE 1:250	A1	No 1-
	DOLPHIN MINE		
	CONTOUR PLAN		
DATE	C LENS WEDGE -126 m contour		
SURVEYED			
DRAWN			
TRACED			
CHECKED			