

DIAGRAM FROM ACTUAL SURVEY



KING ISLAND PARISH OF KITTAWA

No. OF APPLICATION

Part of 483²/₁₂. The Perpetual Trustee & T. McCormack Pur.


D.W. Bowling Ownr. C/T. 474-86

Scale 100 feet to an inch

REFERENCE TO CORNERS

COR.	BEARING	DISTANCE IN LINKS	FROM

205 / 39
 3850
 9th FEB 1949
 Gam

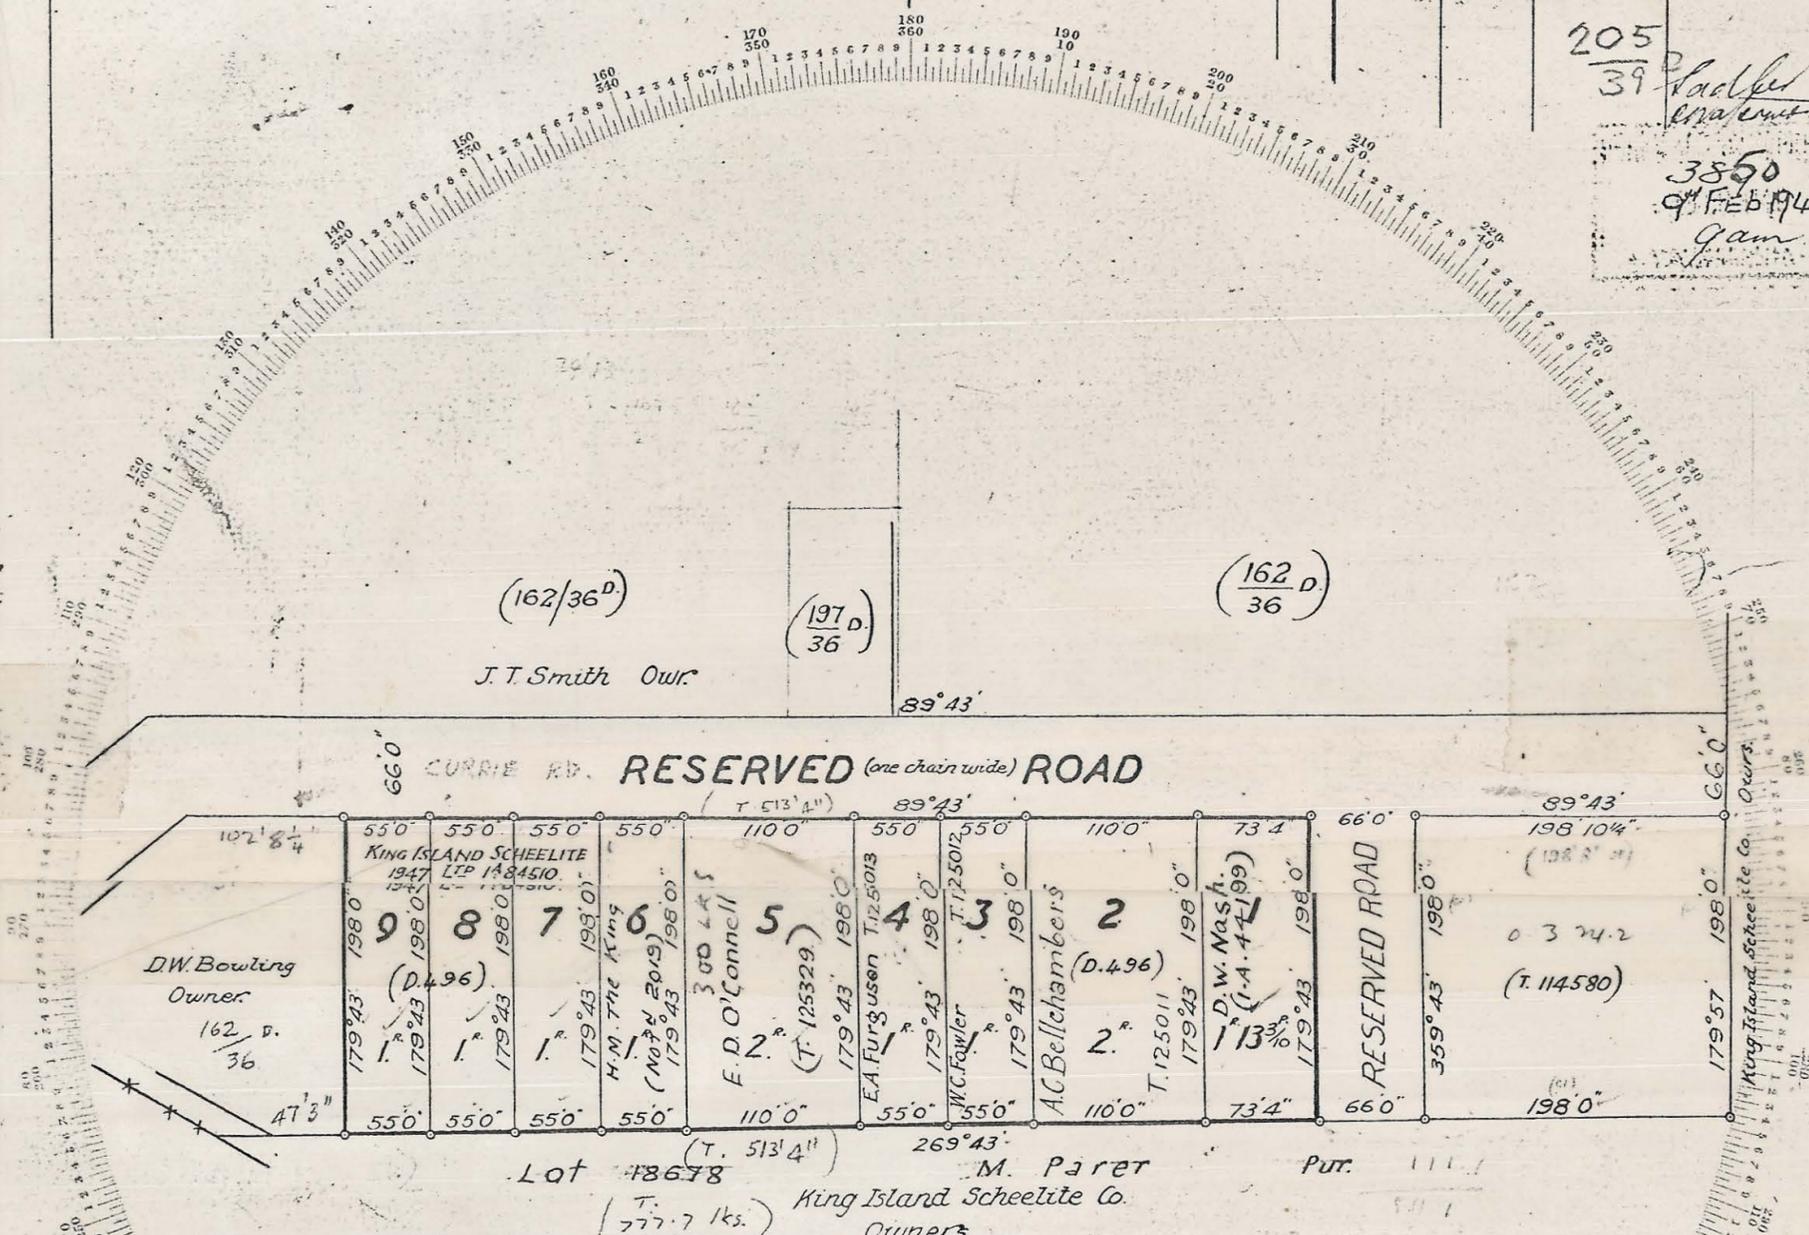

D.W. Bowling
Owner
162^D/₃₆

J.T. Smith Ownr.

CURRIE RD. RESERVED (one chain wide) ROAD

Lot 48678
(T. 513' 4")
(T. 777.7 lks.)

M. Parer
King Island Scheelite Co.
Owners

Put. 111.1

Note... All boundaries open

This subdivision does not require the approval of the Municipality of King Island as it is outside the area covered by the Towns Act & the Town & Country Planning Act.

To be filled in by Surveyor:

- Date of Instructions
- Survey commenced 4.5.48.
- Survey finished 8.5.48.
- Error of close 1 in

Office examination:

- Plotted by M.R.H.
- Examined as to boundaries M.R.H.
- Mathematically checked M.R.H.
- Entered on Card by M.R.H.

I, John Walter Cohen of Launceston Registered Surveyor, of Tasmania, do hereby certify that this plan has been made from surveys executed by me or under my own personal supervision, inspection, and field check, and that both plan and survey are correct, and have been made in accordance with the Land Surveyors' By-Law No. 2, dated 3rd July, 1946.

Dated this 12th day of May, 1948.

J.W. Cohen
Authorised Surveyor.

