


CORRES. 400/16
Photostat and at 400/16 18/51

DIAGRAM FROM ACTUAL SURVEY KING ISLAND PARISH OF KITTAWA

156D03 - X001

0374_3830
5 cm

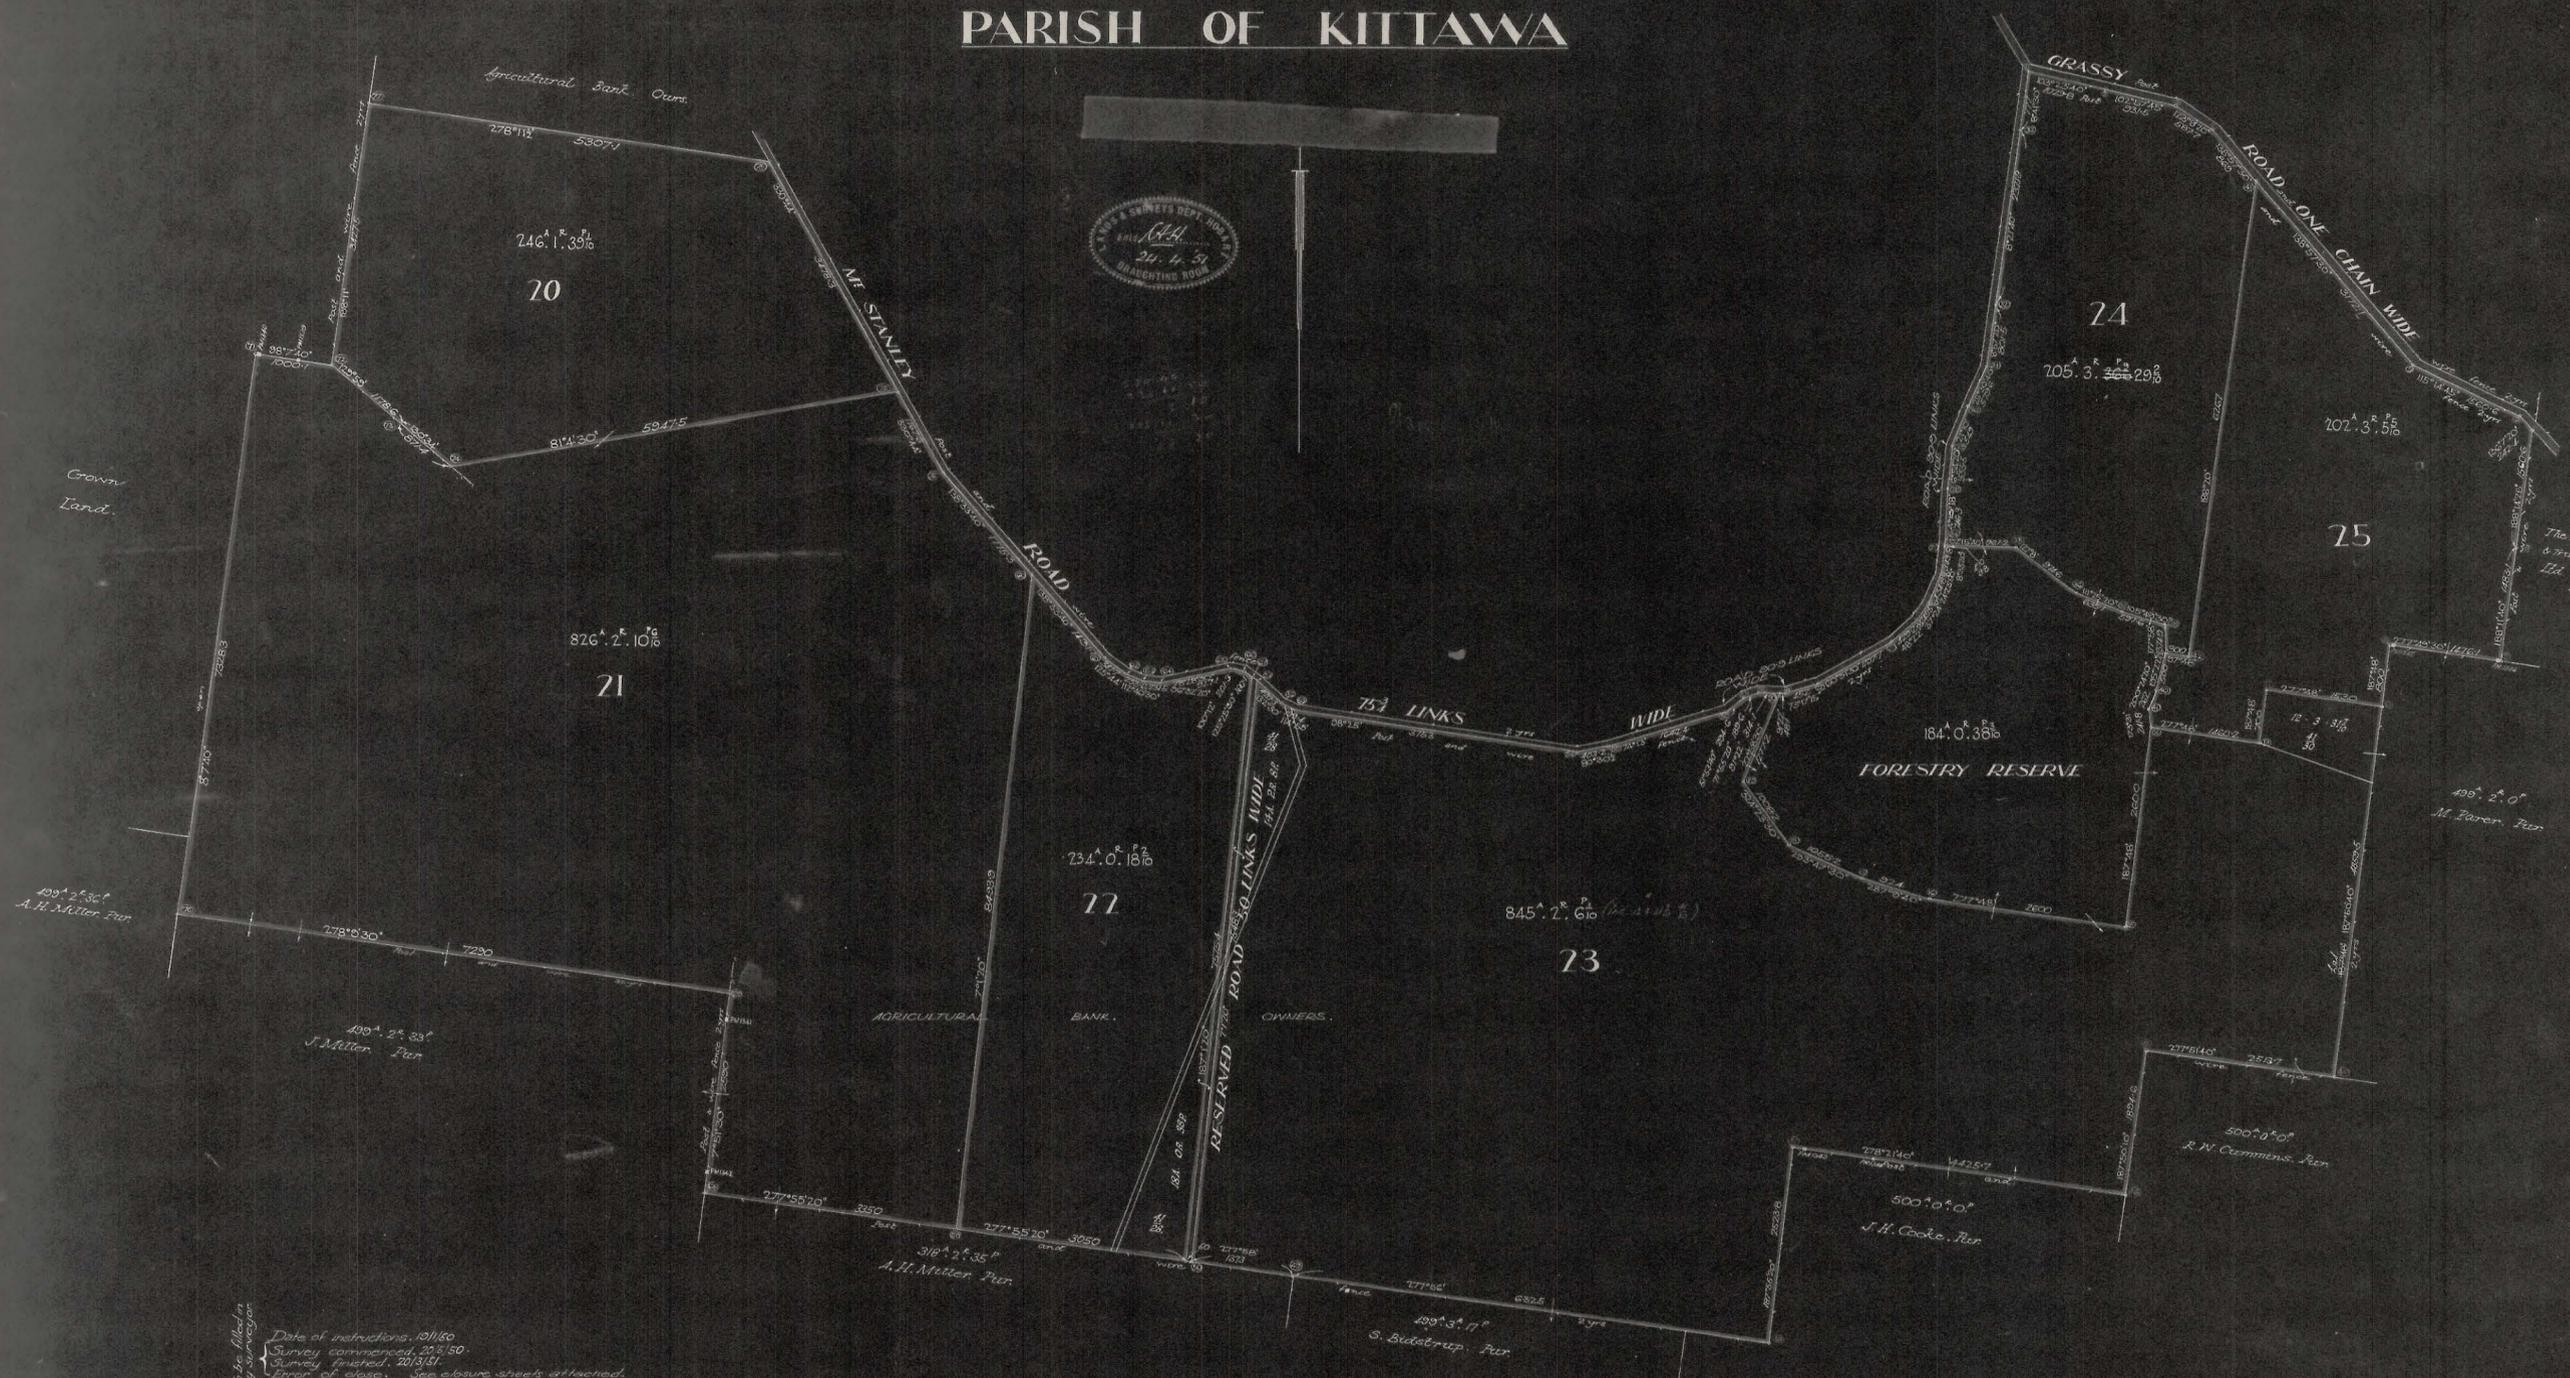

Office to be filled in
by surveyor

Date of instructions 1916
Survey commenced 20/5/50
Survey finished 20/5/51
Error of close. See closure sheets attached.

Checked by
Examined as to bearings and
Mathematically checked, at 22.5.51
Entered on plan by 20.4.51
Plans
General Plan 20.4.51
State Permanent Marks 20.5.51
Finally Examined 20.5.51

Dated this 5th day of April 1951
Lalimpon
Authorised Surveyor