


5 cm

12 KING ISD.

DIAGRAM FROM ACTUAL SURVEY

KING ISLAND - Parish of Kittawa

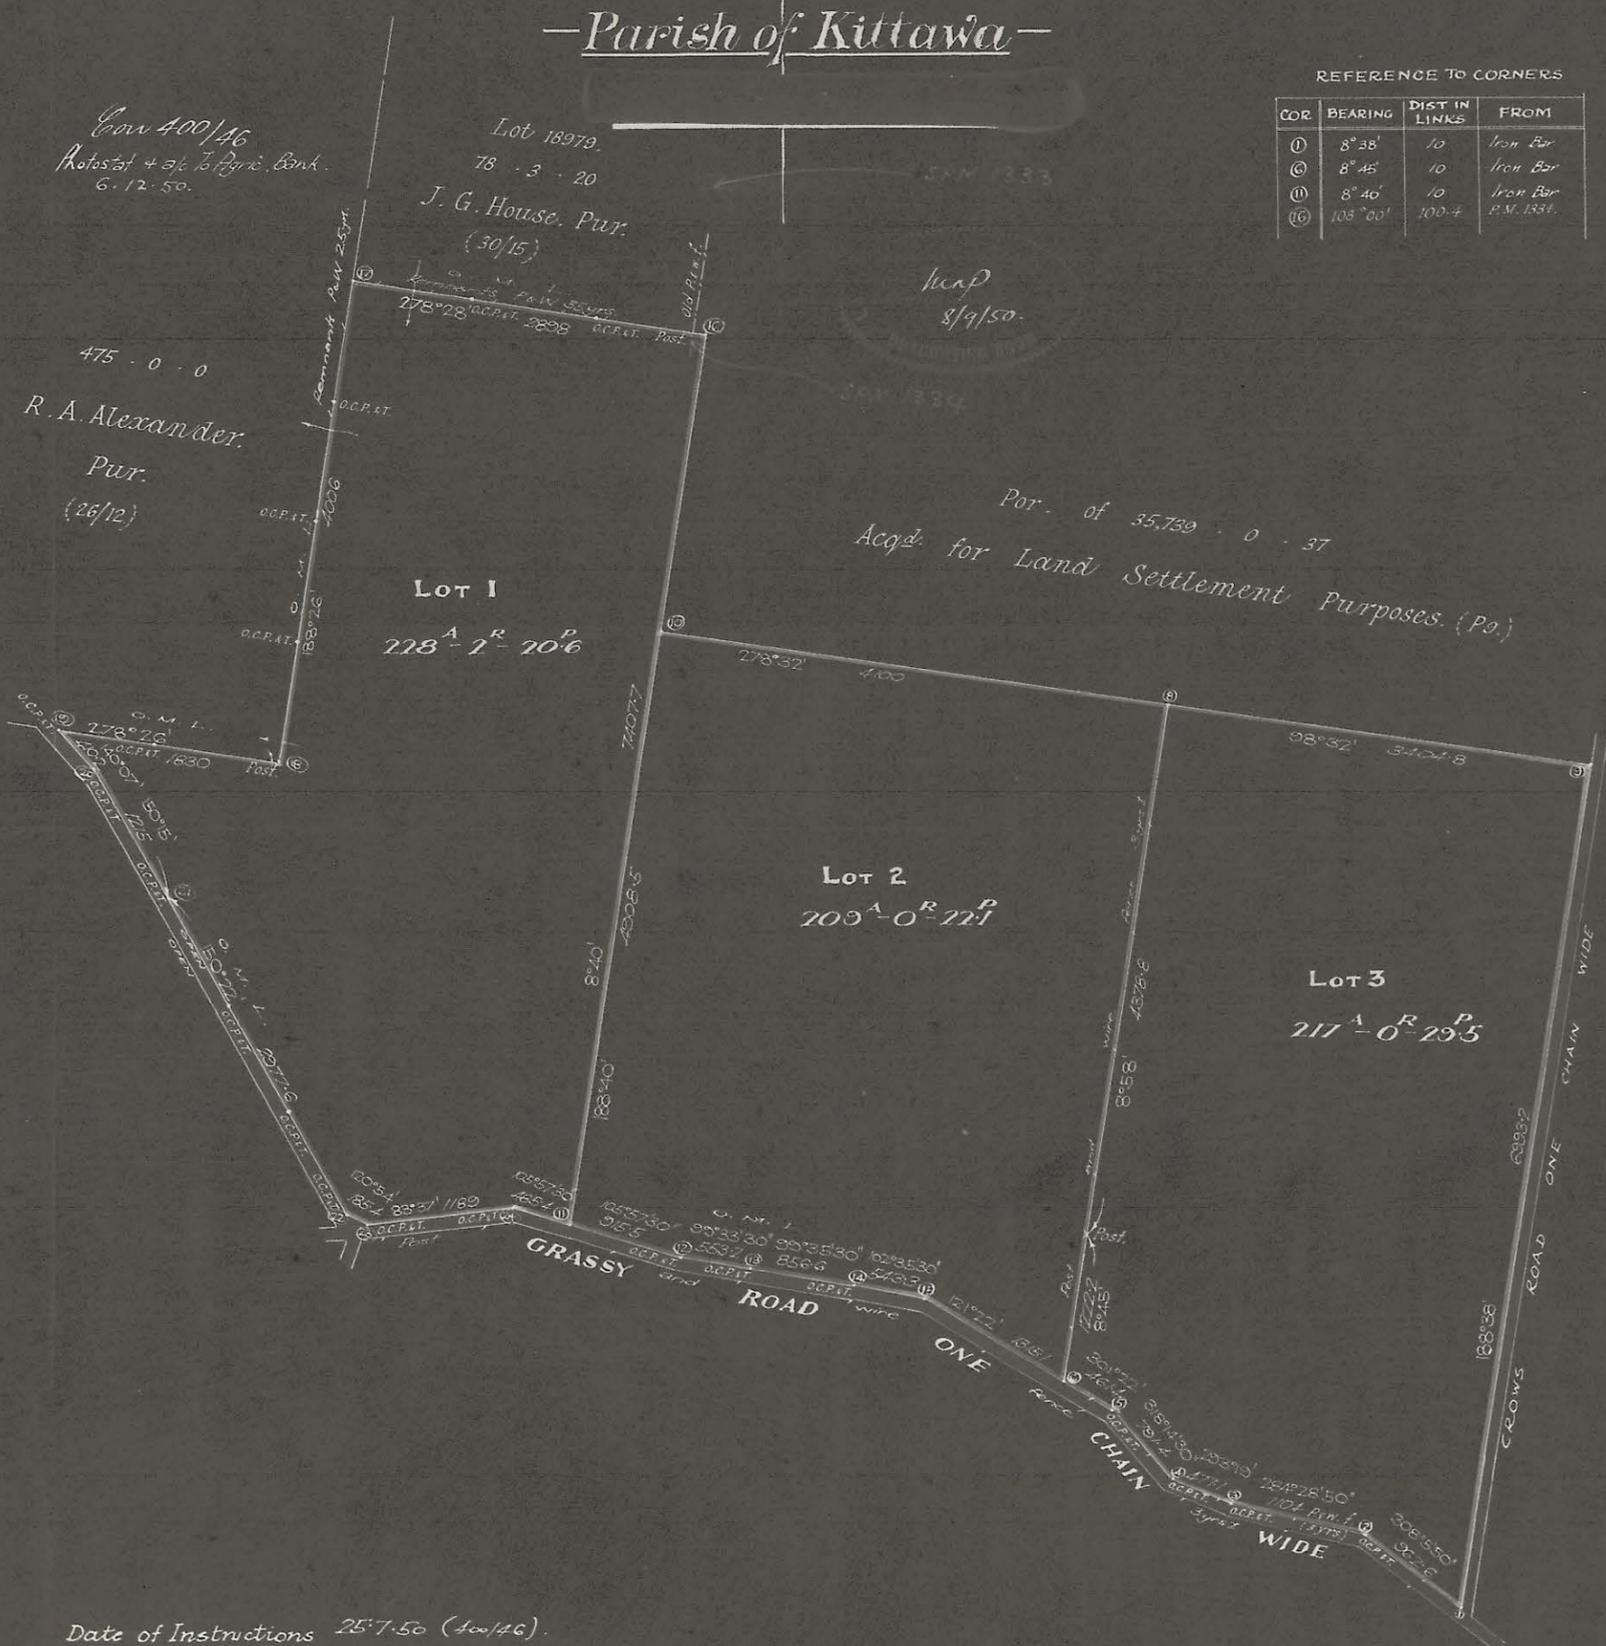

Date of Instructions 25.7.50 (400/46).
 Survey Commenced 7.2.50
 Survey Finished 2.6.50
 Error of Close 1 in (See closure sheets).
 Computations Checked 17/9/50
 Examined as to boundaries :- *[Signature]*
 Regulations Checked. *[Signature]*
 Entered on Diagrams. Plans *[Signature]*
 Entered on General Plan. *[Signature]*
 State Permanent Marks. *[Signature]* 6.12.50
 Finally examined. *[Signature]* 7.12.1950.

L. Simpson
 Authorised Surveyor
 1st Sept. 1950.

a/c 131.14.0 for 6/12/50.