


5 cm

Corr. No. 400/46  
L.C. 10/10/46

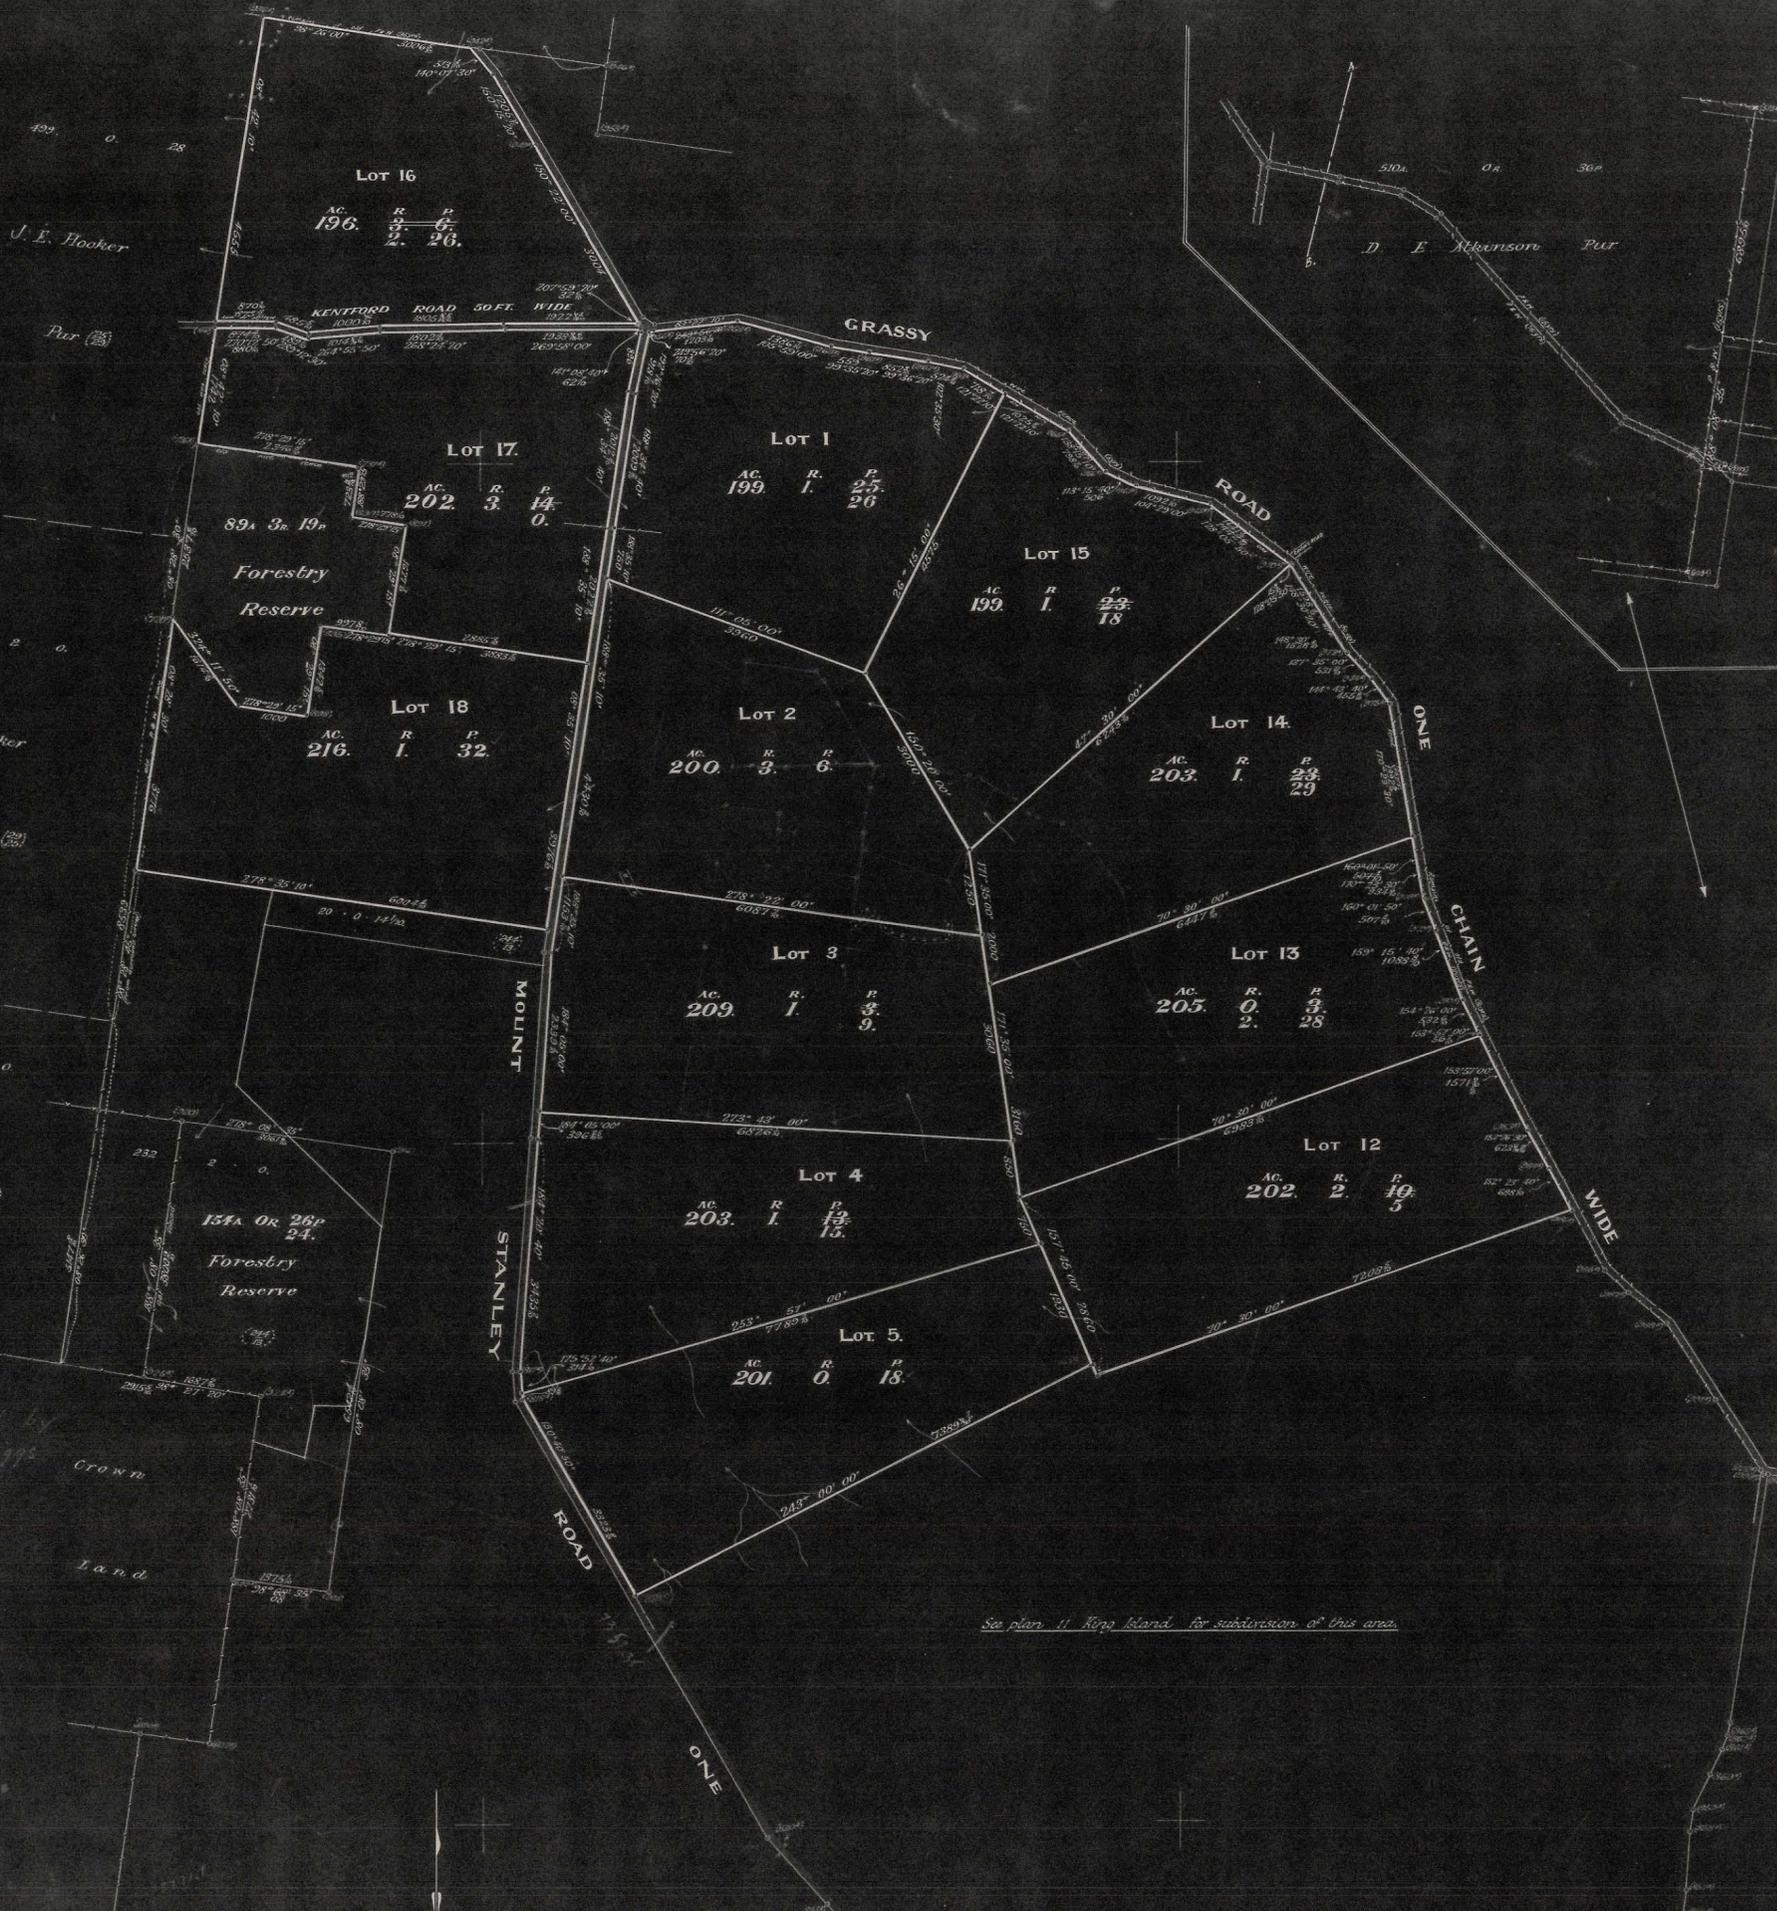

# MOUNT STANLEY AREA KING ISLAND

PARISH OF KITTAWA

Scale



156D03-X005

Date of Instructions 4.4.48  
 Survey Commenced 20.4.48  
 Survey Finished 10.11.48  
 Plotted by [Signature]  
 Error in close [Signature]  
 Computations checked [Signature]  
 Examined as to [Signature]  
 Examined as to [Signature]  
 Entered on this Plan [Signature]  
 Entered on diagrams [Signature]  
 Finally Examined by [Signature]



[Signature]  
Surveyor