

5 cm

162/36

# DIAGRAM FROM ACTUAL SURVEY

## COUNTY OF KING ISLAND

### PARISH OF KITTAWA

C.T. 412/16  
Graph




REFERENCE TO CORNERS

COR.	BEARING	DISTANCE IN LINKS	FROM

Scale - 3 Chains - to an inch.  
Subdivision of Part of Originally Lot 22726 G<sup>th</sup> in The Perpetual Executors & Trustees Ass<sup>ts</sup> of Australia Ltd & A<sup>os</sup>  
Now Max. Alicia Oliphant ON C.T. 412-16

162/36

162/36 (332/32<sup>nd</sup>)

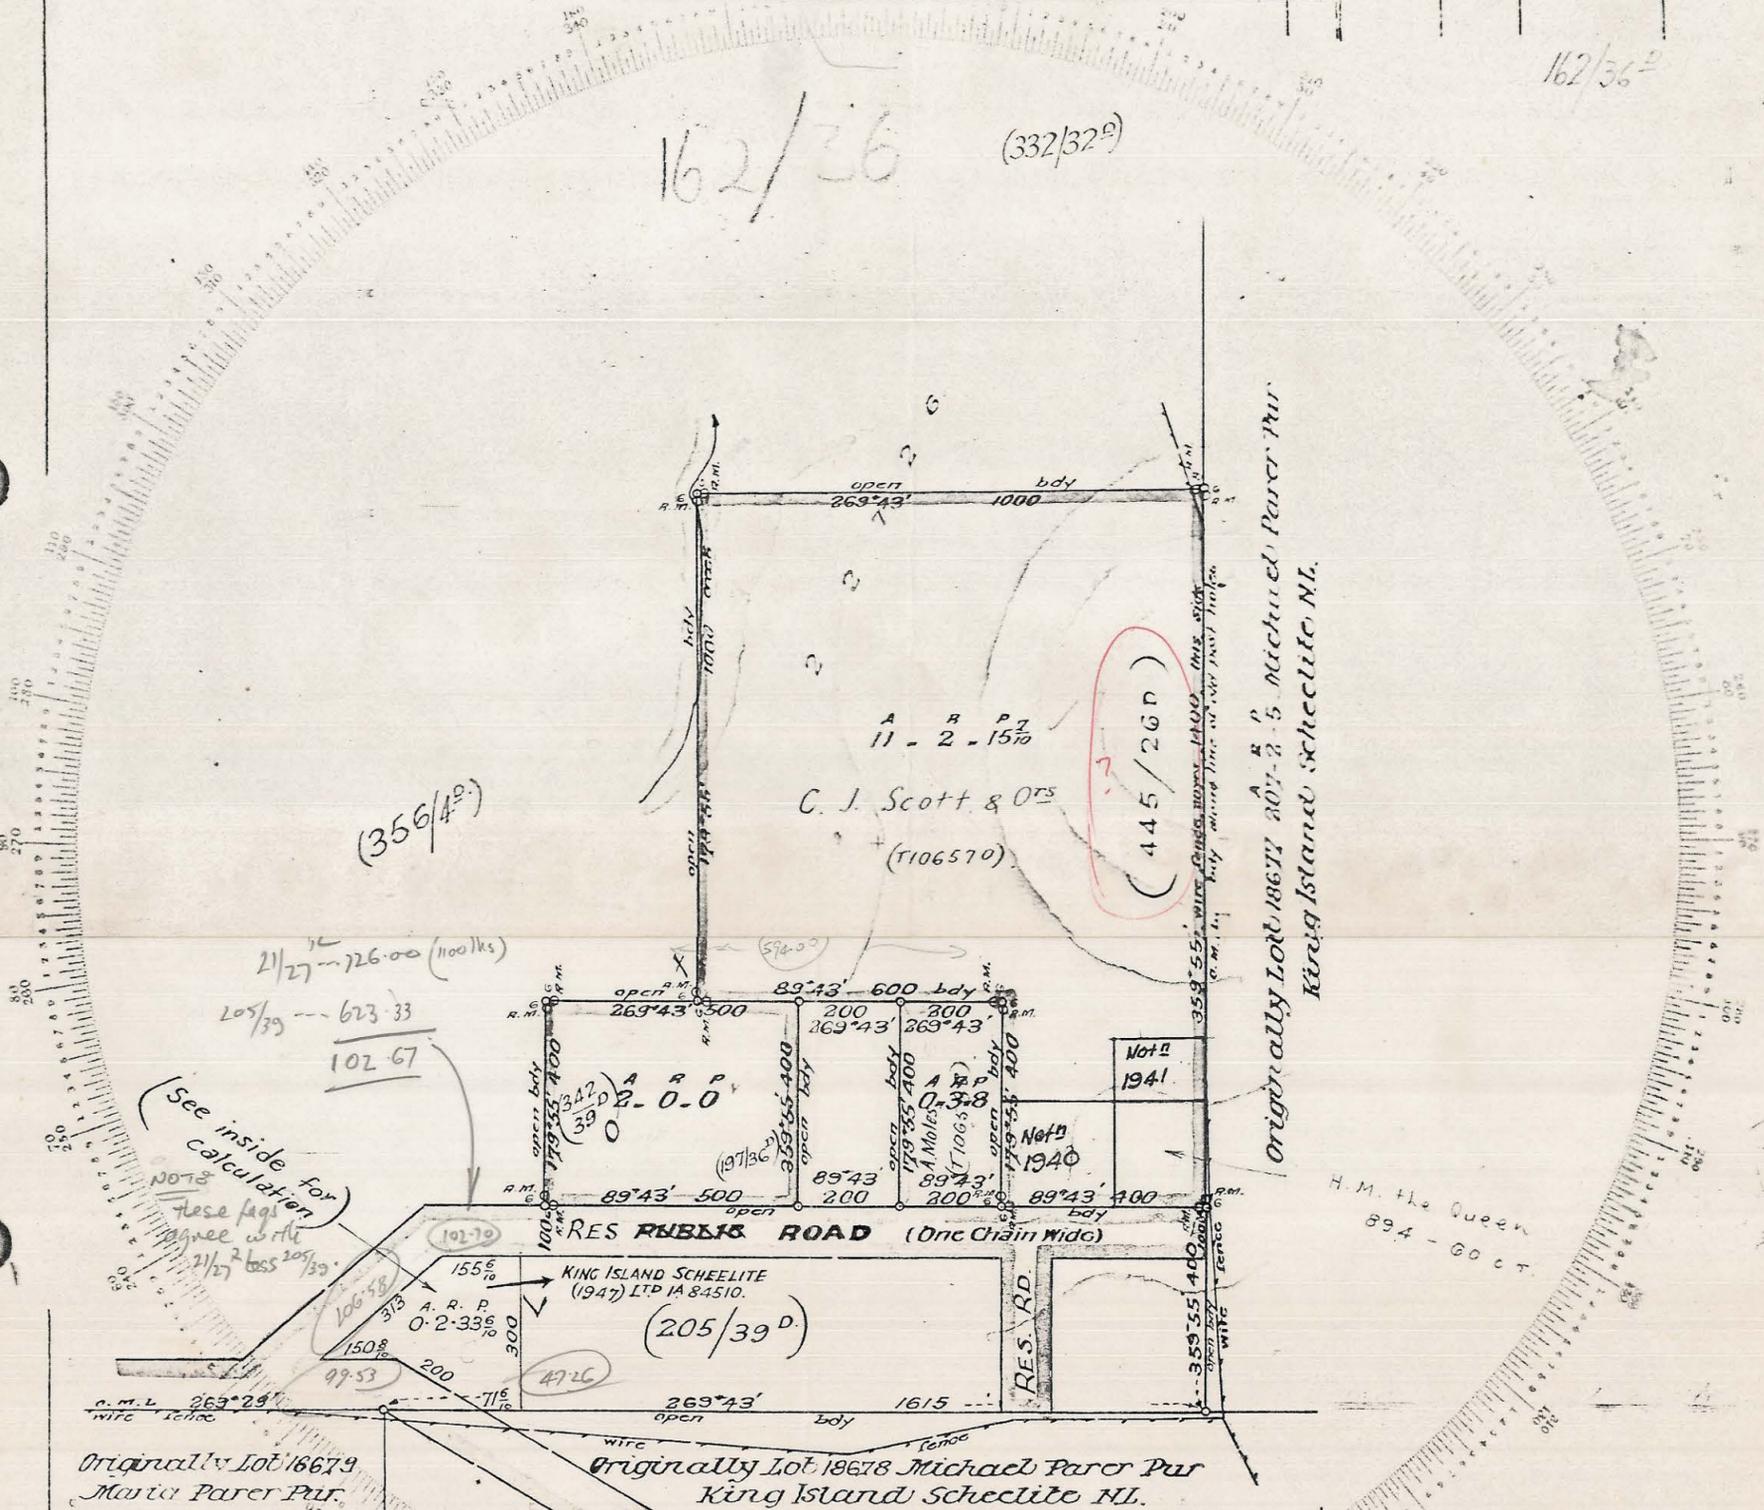

(See inside for calculation these pages agree with 21/27 2<sup>nd</sup> 205/39)

Originally Lot 18679 Maria Parer Par

### CONNECTION

Scale 10 Chains to an inch



Originally Lot 19118 T. Bayley Par Originally Lot 18679 Maria Parer Par Originally Lot 18678 Michael Parer Par King Island Scheelite N.L.

To be filled in by Surveyor.

- Date of Instructions
- Survey commenced 28. 6. 44.
- Survey finished 7. 7. 44.
- Error of close 1 in Nil

Office examination.

- Plotted by *[Signature]*
- Examined as to boundaries *[Signature]*
- Mathematically checked *[Signature]*
- Entered on Card by *[Signature]*

I, Alfred William Martin Brewer of Launceston, Authorised Surveyor, of Tasmania, do hereby certify that this plan has been made from surveys executed by me or under my own personal supervision, inspection, and field check, and that both plan and survey are correct, and have been made in accordance with the by-laws of the Surveyors' Board, dated 1st May, 1913.

*[Signature]*  
Authorised Surveyor.

Dated this 25<sup>th</sup> day of September, 1944.