

DIAGRAM FROM ACTUAL SURVEY

COUNTY OF KING ISLAND PARISH OF KITTAWA



C.T. 412/16
J. T. SMITH


REFERENCE TO CORNERS

COR.	BEARING	DISTANCE IN LINKS	FROM
1	179° 55'	6	Iron Spike
2	89° 29'	6	"
3	179° 55'	6	"
4	269° 29'	6	"
5	269° 55'	6	"
6	89° 55'	6	"
7	359° 55'	6	"

162
34 D

Scale - 8 Chains - to an inch.

Part of Lot 22726 G^W to Perpetual Executors & Trustees of *Wills of Australia Ltd & T. McCormack*
Now *Mrs Alicia Oliphant OW. C.T. 412-16.*

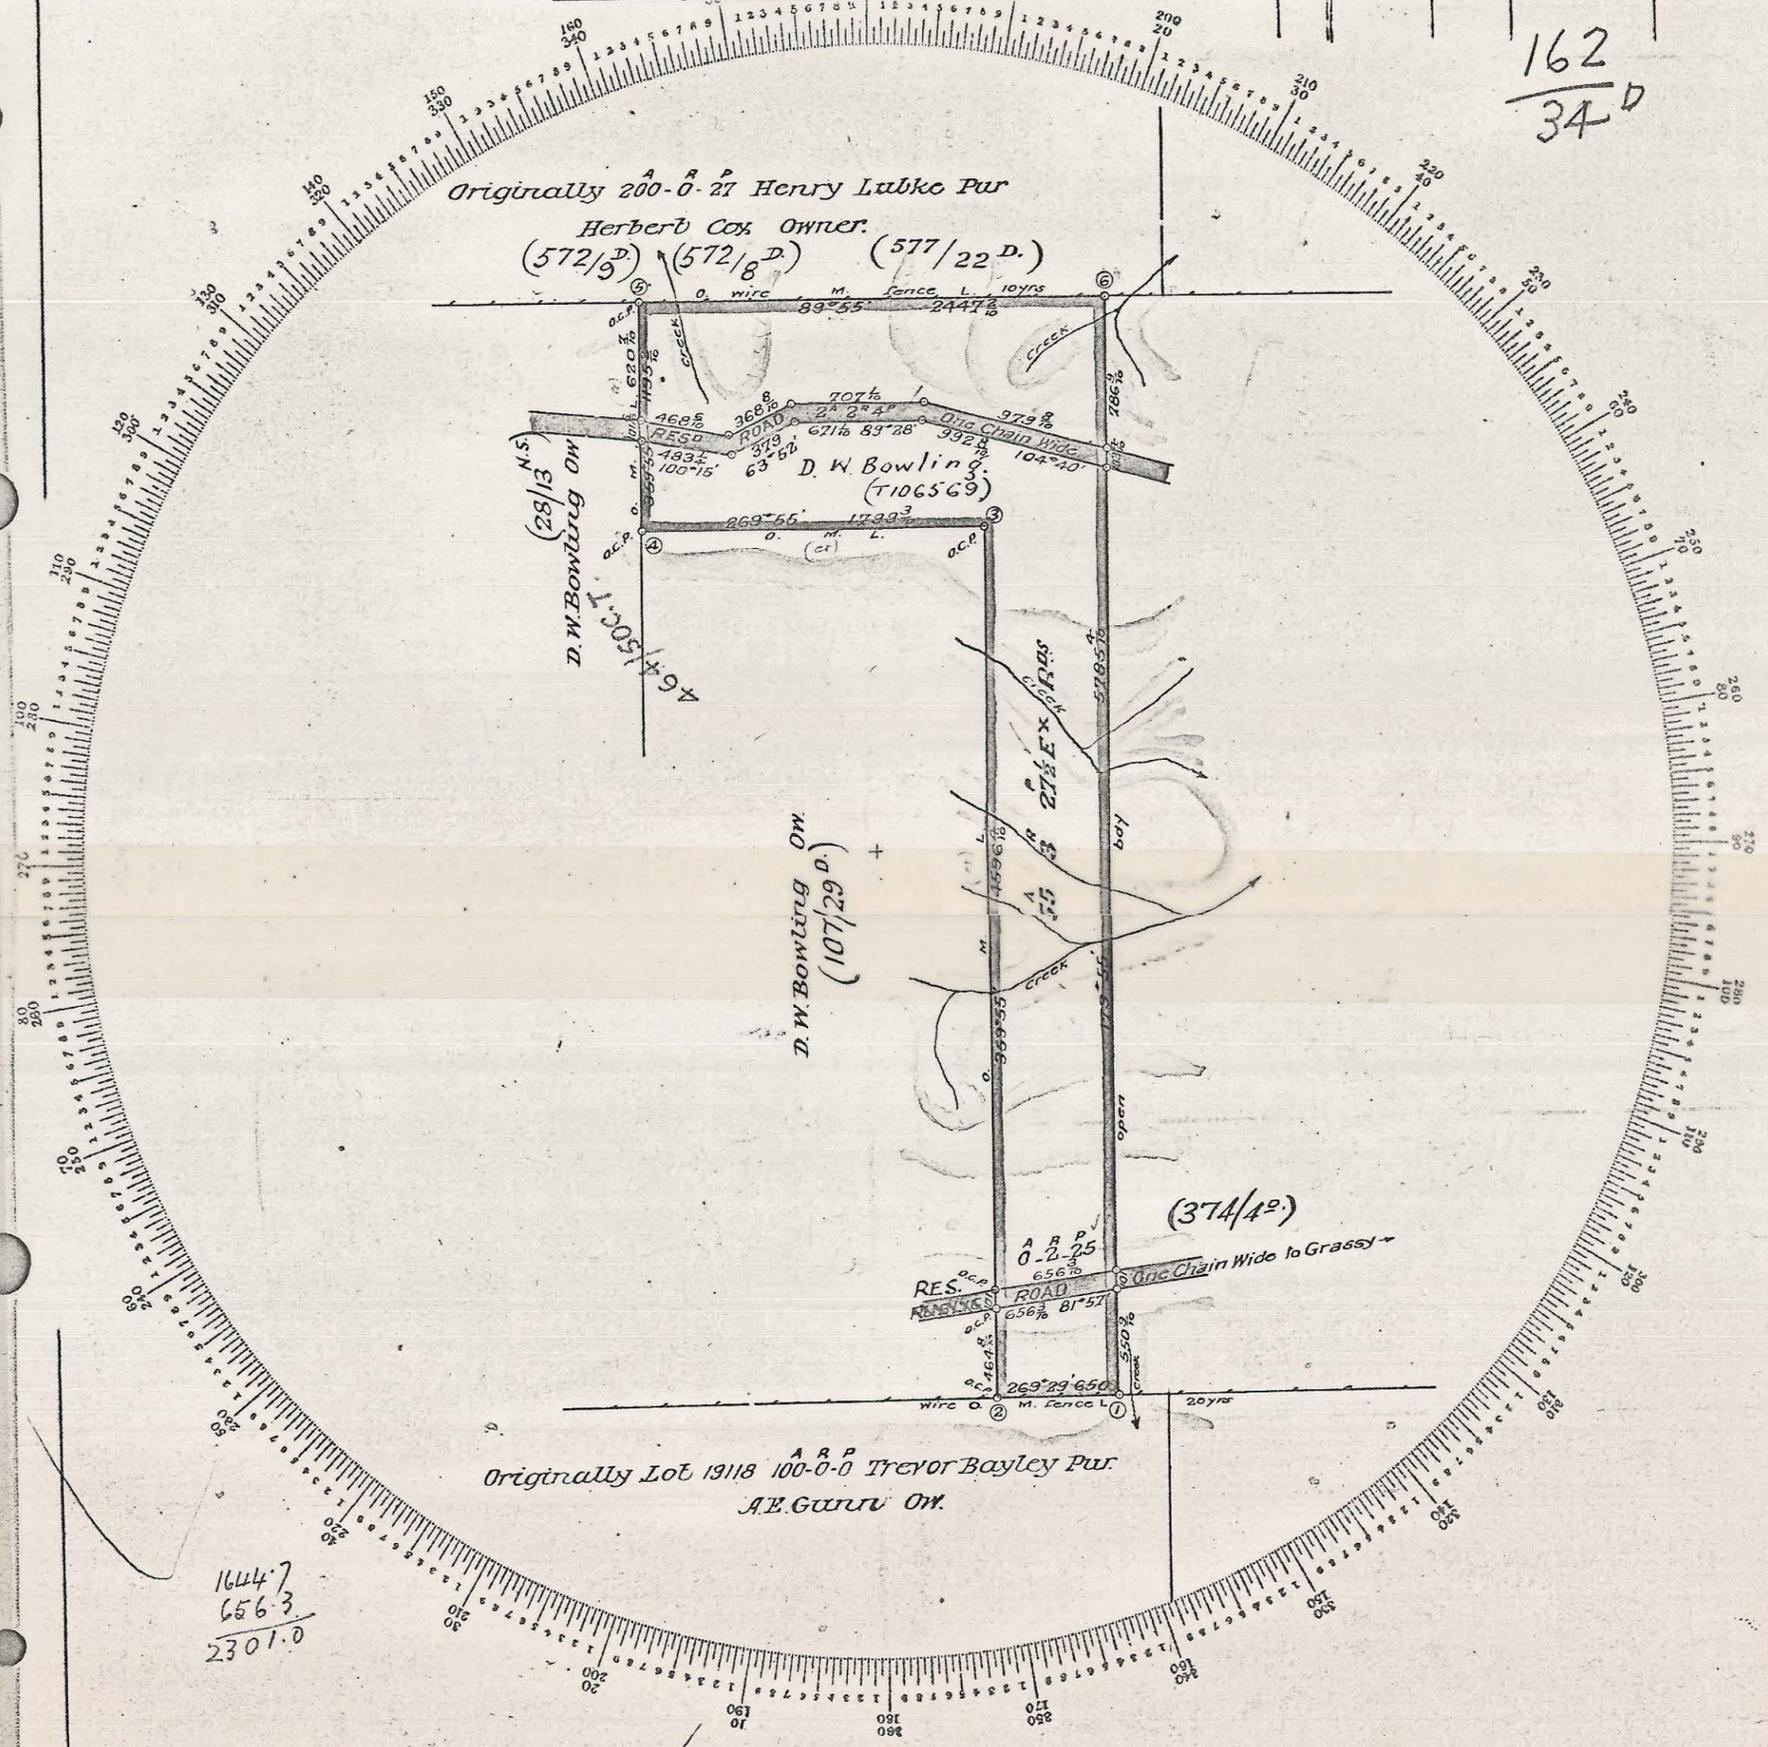

0374_3843

5 cm

1644.7
656.3
2301.0

To be filed in by Surveyor.

- Date of Instructions
- Survey commenced 10. 7. 44.
- Survey finished 15. 7. 44
- Error of close 1 in 6922

Office examination.

- Plotted by *AWM*
- Examined as to boundaries *AWM*
- Mathematically checked *AWM*
- Entered on Card by *AWM*

I, *Alfred William Martin Brewer* of *Launceston*,
Authorised Surveyor, of Tasmania, do hereby certify that this plan has been made from surveys executed by me or under my own personal supervision, inspection, and field check, and that both plan and survey are correct, and have been made in accordance with the by-laws of the Surveyors' Board, dated 1st May, 1913.

AWM Brewer
Authorised Surveyor.

Dated this 27th day of September, 1944.