

M.A. Olyphant
318-105

107/29

DIAGRAM FROM ACTUAL SURVEY


COUNTY OF KING ISLAND
PARISH OF KITTAWA



REFERENCE TO CORNERS

COR.	BEARING	DISTANCE IN LINKS	FROM
1	359° 55'	5.0	Spike
3	269° 30'	11.7	"
	89° 55'	6.0	"
4	359° 55'	16.2	"
	89° 55'	13.0	"
5	359° 55'	13.0	"
	179° 55'	11.0	"
	89° 30'	10.0	"

Scale 6 Chains to an inch.

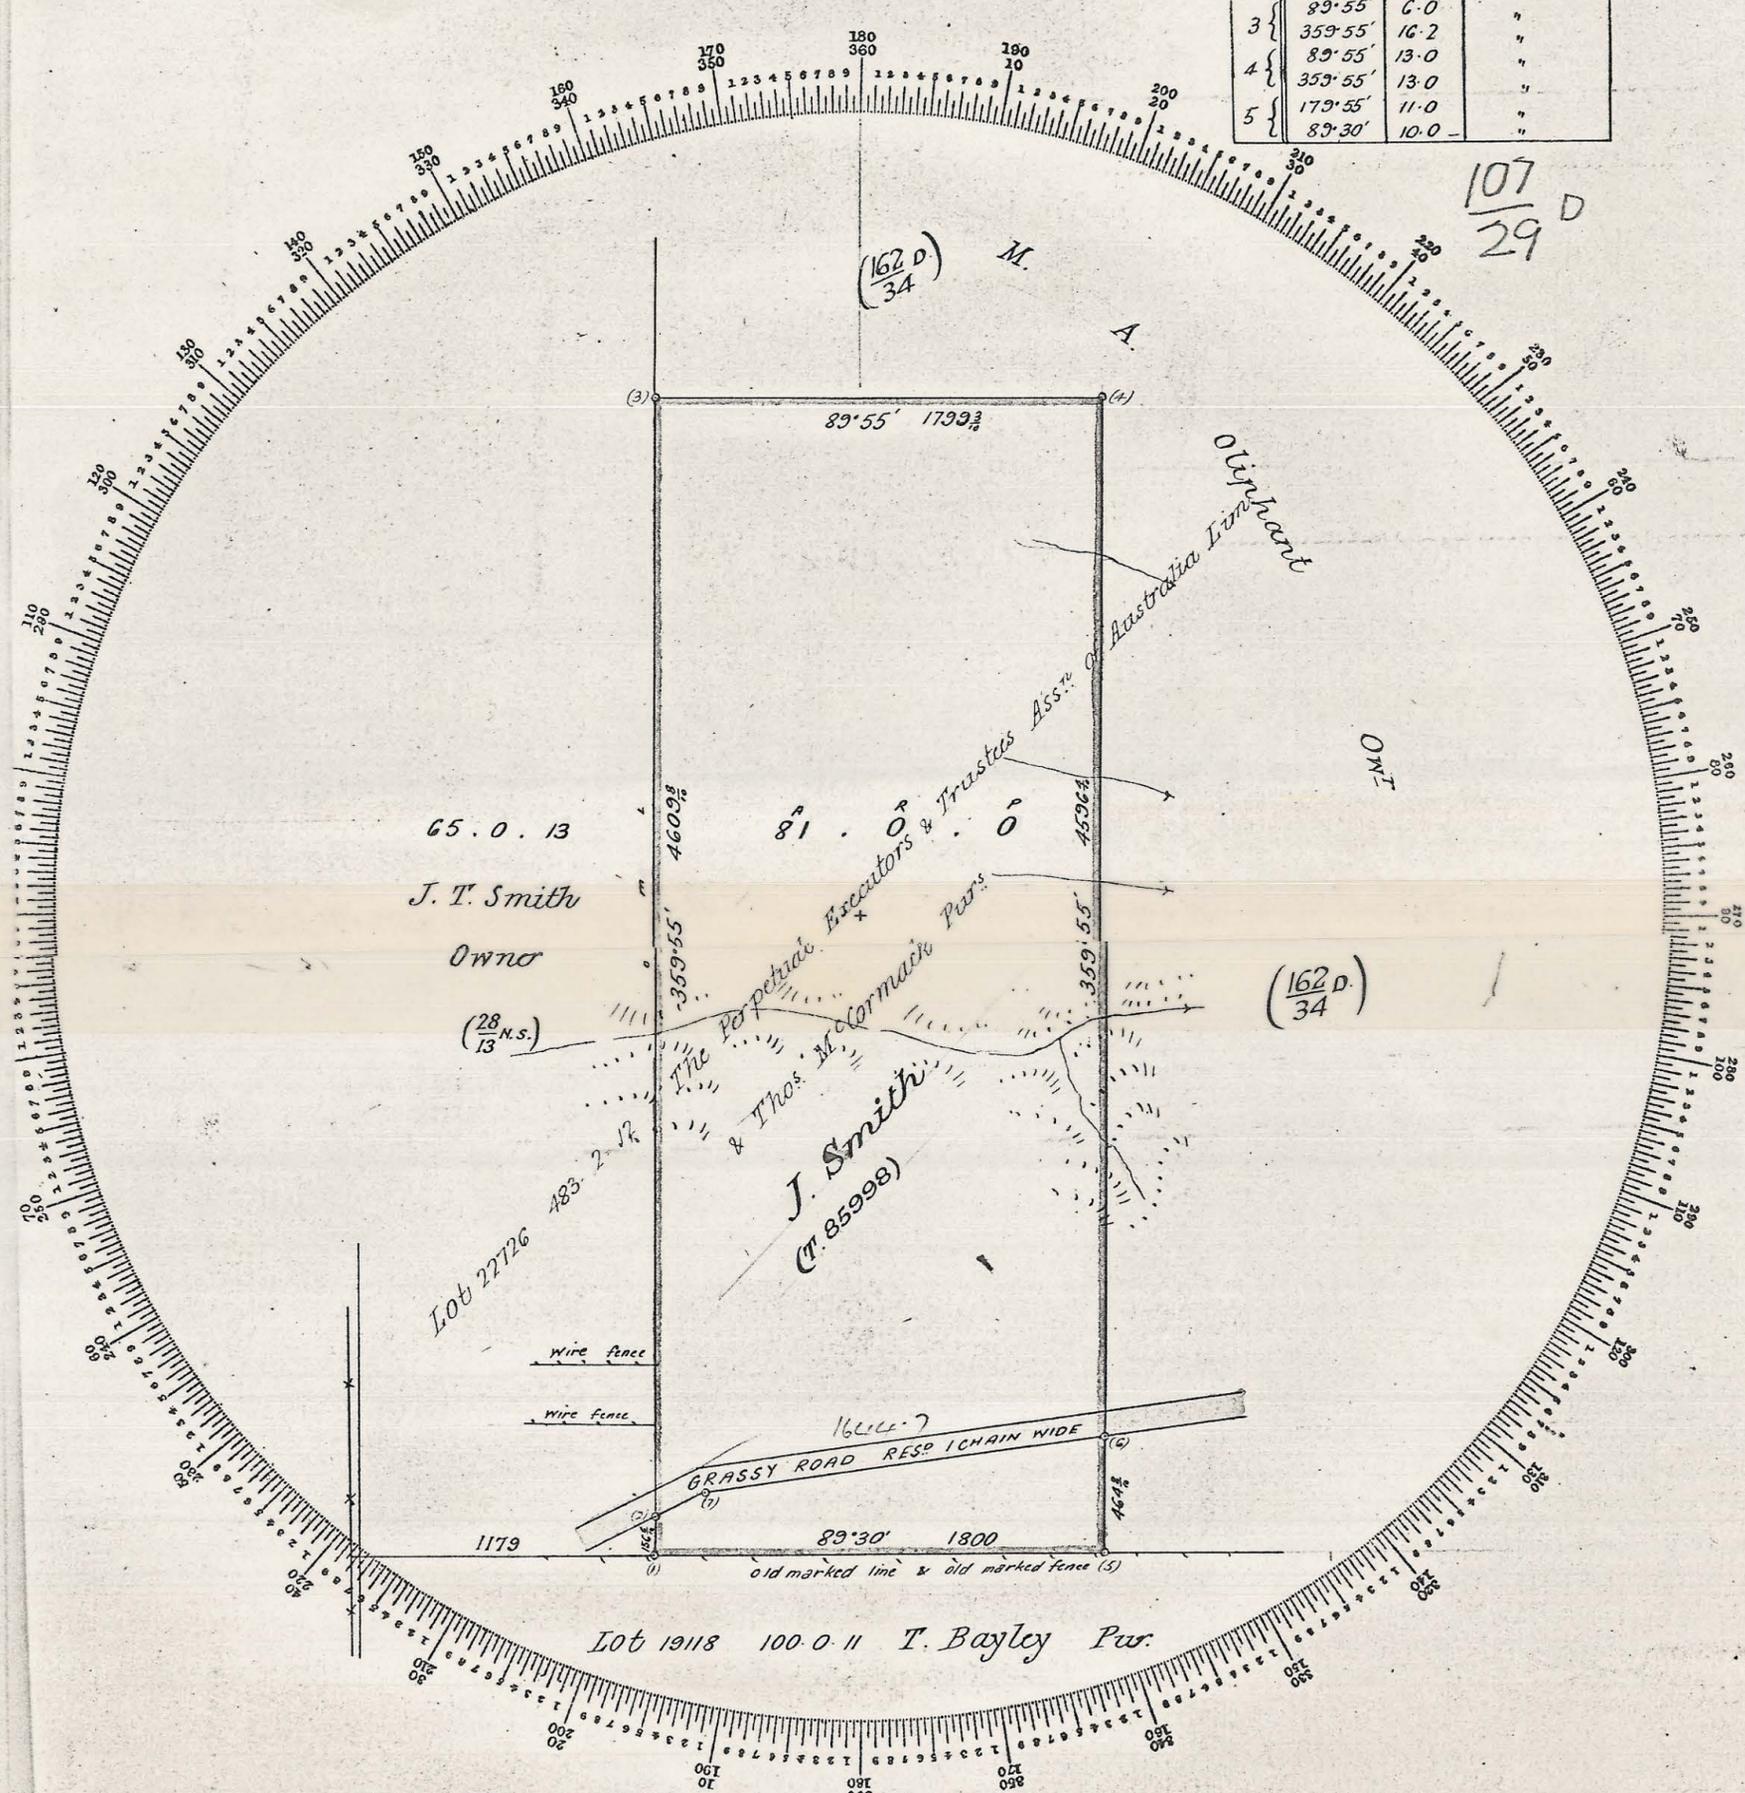

0374_3848

To be filled in by Surveyor.

- Date of Instructions
- Survey commenced 1. 5. 36
- Survey finished 5. 5. 36
- Error of close 1 in 16007

Office examination.

- Plotted by
- Examined as to boundaries } CAH
- Mathematically checked
- Entered on Card by CAH.

I, *Kenneth Montague Harrison* of *Smithton*,
 Authorised Surveyor, of Tasmania, do hereby certify that this plan has been made from surveys executed by me or under my own personal supervision, inspection, and field check, and that both plan and survey are correct, and have been made in accordance with the by-laws of the Surveyors' Board, dated 1st May, 1913.

K. M. Harrison
 Authorised Surveyor.

Dated this 14th day of September, 1936