

15GDO2-X007

0374\_3854



97. 1. 0.

M. Parer Pur.

$\frac{18}{26}$


Vol. 479 Fol. 5

207. 2. 5  
Michael Parer Pur.  
 $\frac{20}{7}$

499. 2. 0  
Marie Parer Pur.  
 $\frac{23}{9}$

37a. 2r. Op.

12a. 1r. Op.

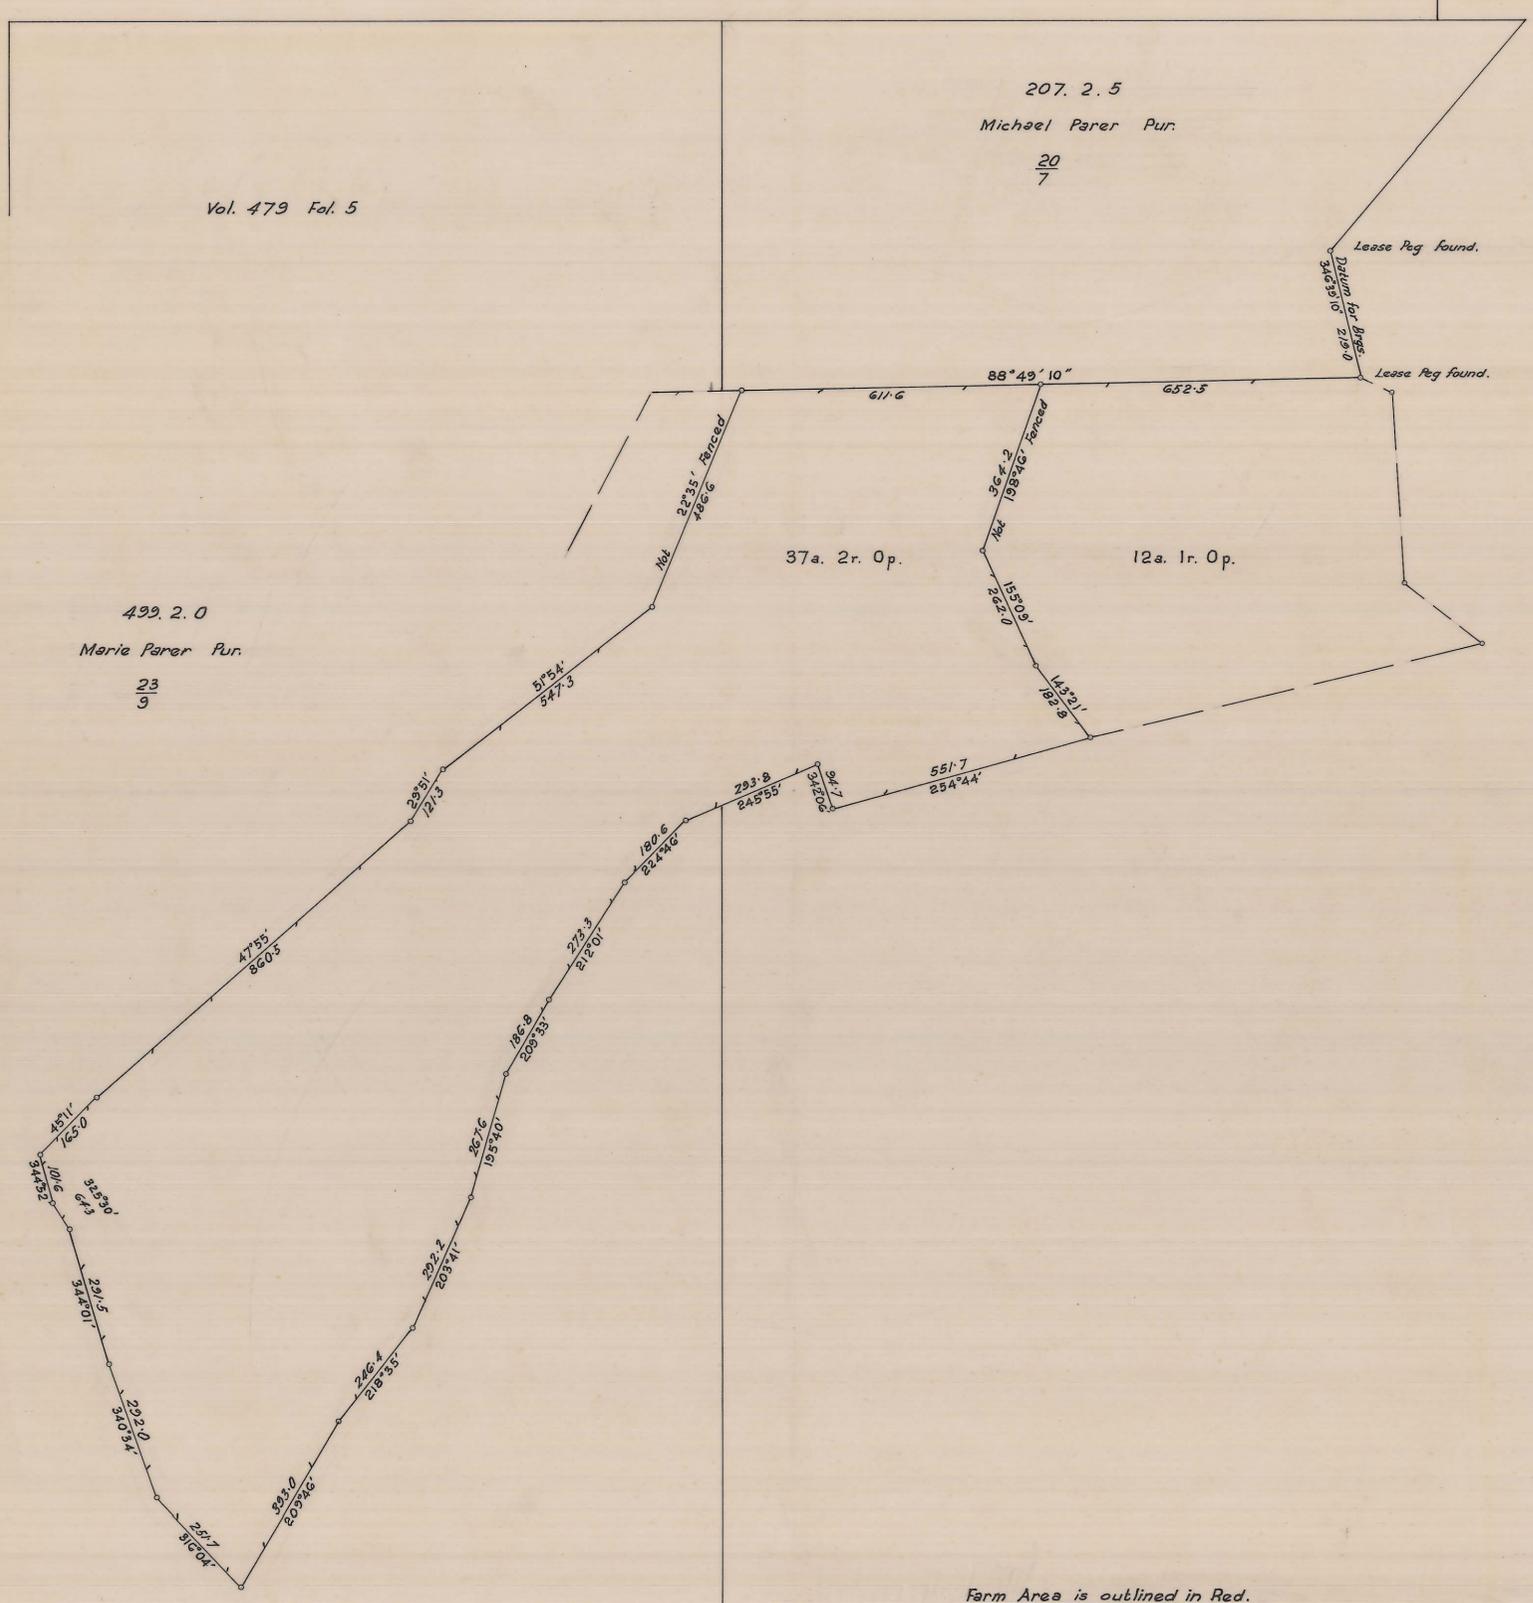

Farm Area is outlined in Red.

K.I.S. DRAWING No.	
1121	
SCALE	DATE OF RECEIPT

49. 3. 29  
M. Parer Pur.  
 $\frac{18}{24}$

KING ISLAND SCHEELITE 1947 LTD		
AMENDED FARM LEASE FOR AGREEMENT WITH C. VAN DER DOES		
SCALE :- 200 FEET TO ONE INCH		
SURVEYED	P.J.R.	L-62
DRAWN	P.J.R.	
DATE		

L-62

Measurements are shown in feet and are from Stadia survey



1-8-26