


27 JUN 1981

03BH04-3008

0374\_3869

5 cm

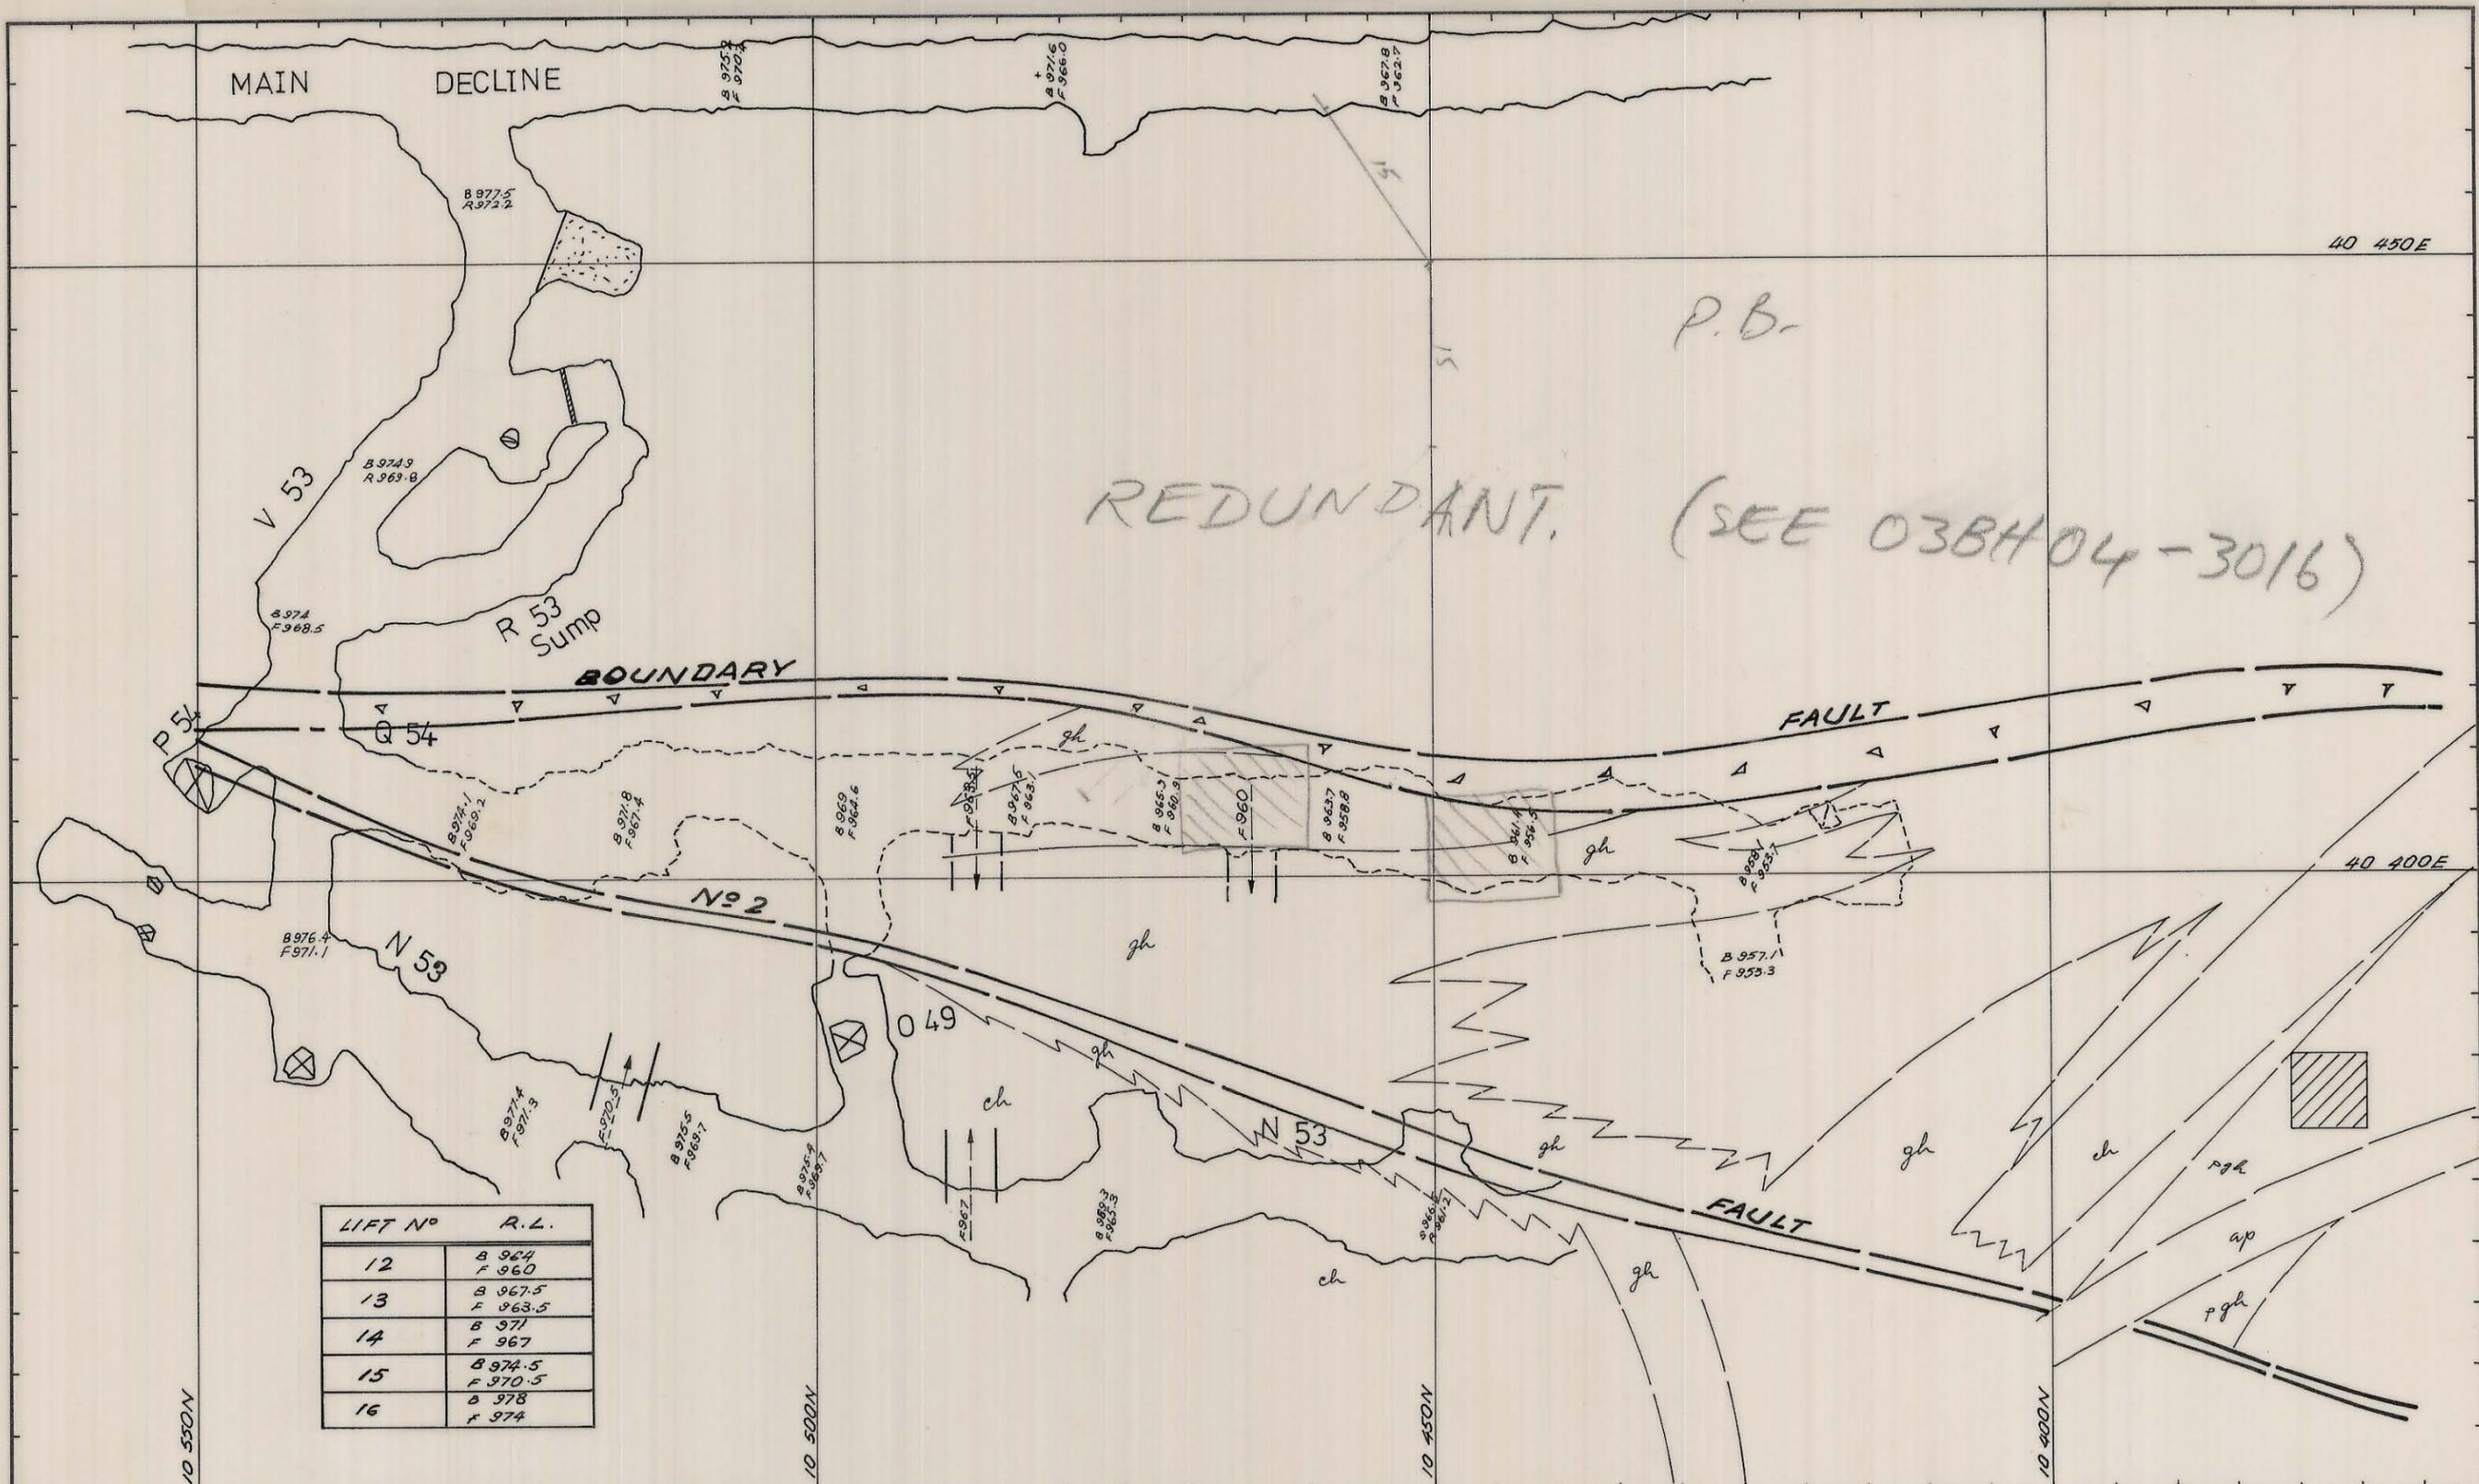

LIFT N°	R.L.
12	B 964 F 960
13	B 967.5 F 963.5
14	B 971 F 967
15	B 974.5 F 970.5
16	B 978 F 974

GEOLOGY AT 950 M.R.L.

REF PLAN DABH14-1008.

GEOLOGY	
SURVEY	
PLANNING	P.B. 29-8-80
ROCK MEC.	
MINE SUPP.	
GENERAL MINING SUPP.	
T.S.S.	

SCALE 1:500

KS KING ISLAND SCHEELITE GRASSY KING ISLAND

BOLD HEAD MINE ACCESS TO BF<sub>2</sub> FOR LIFTS 12,13,14,15,16.

DRAWING NUMBER

03BH04-3008