


5 cm

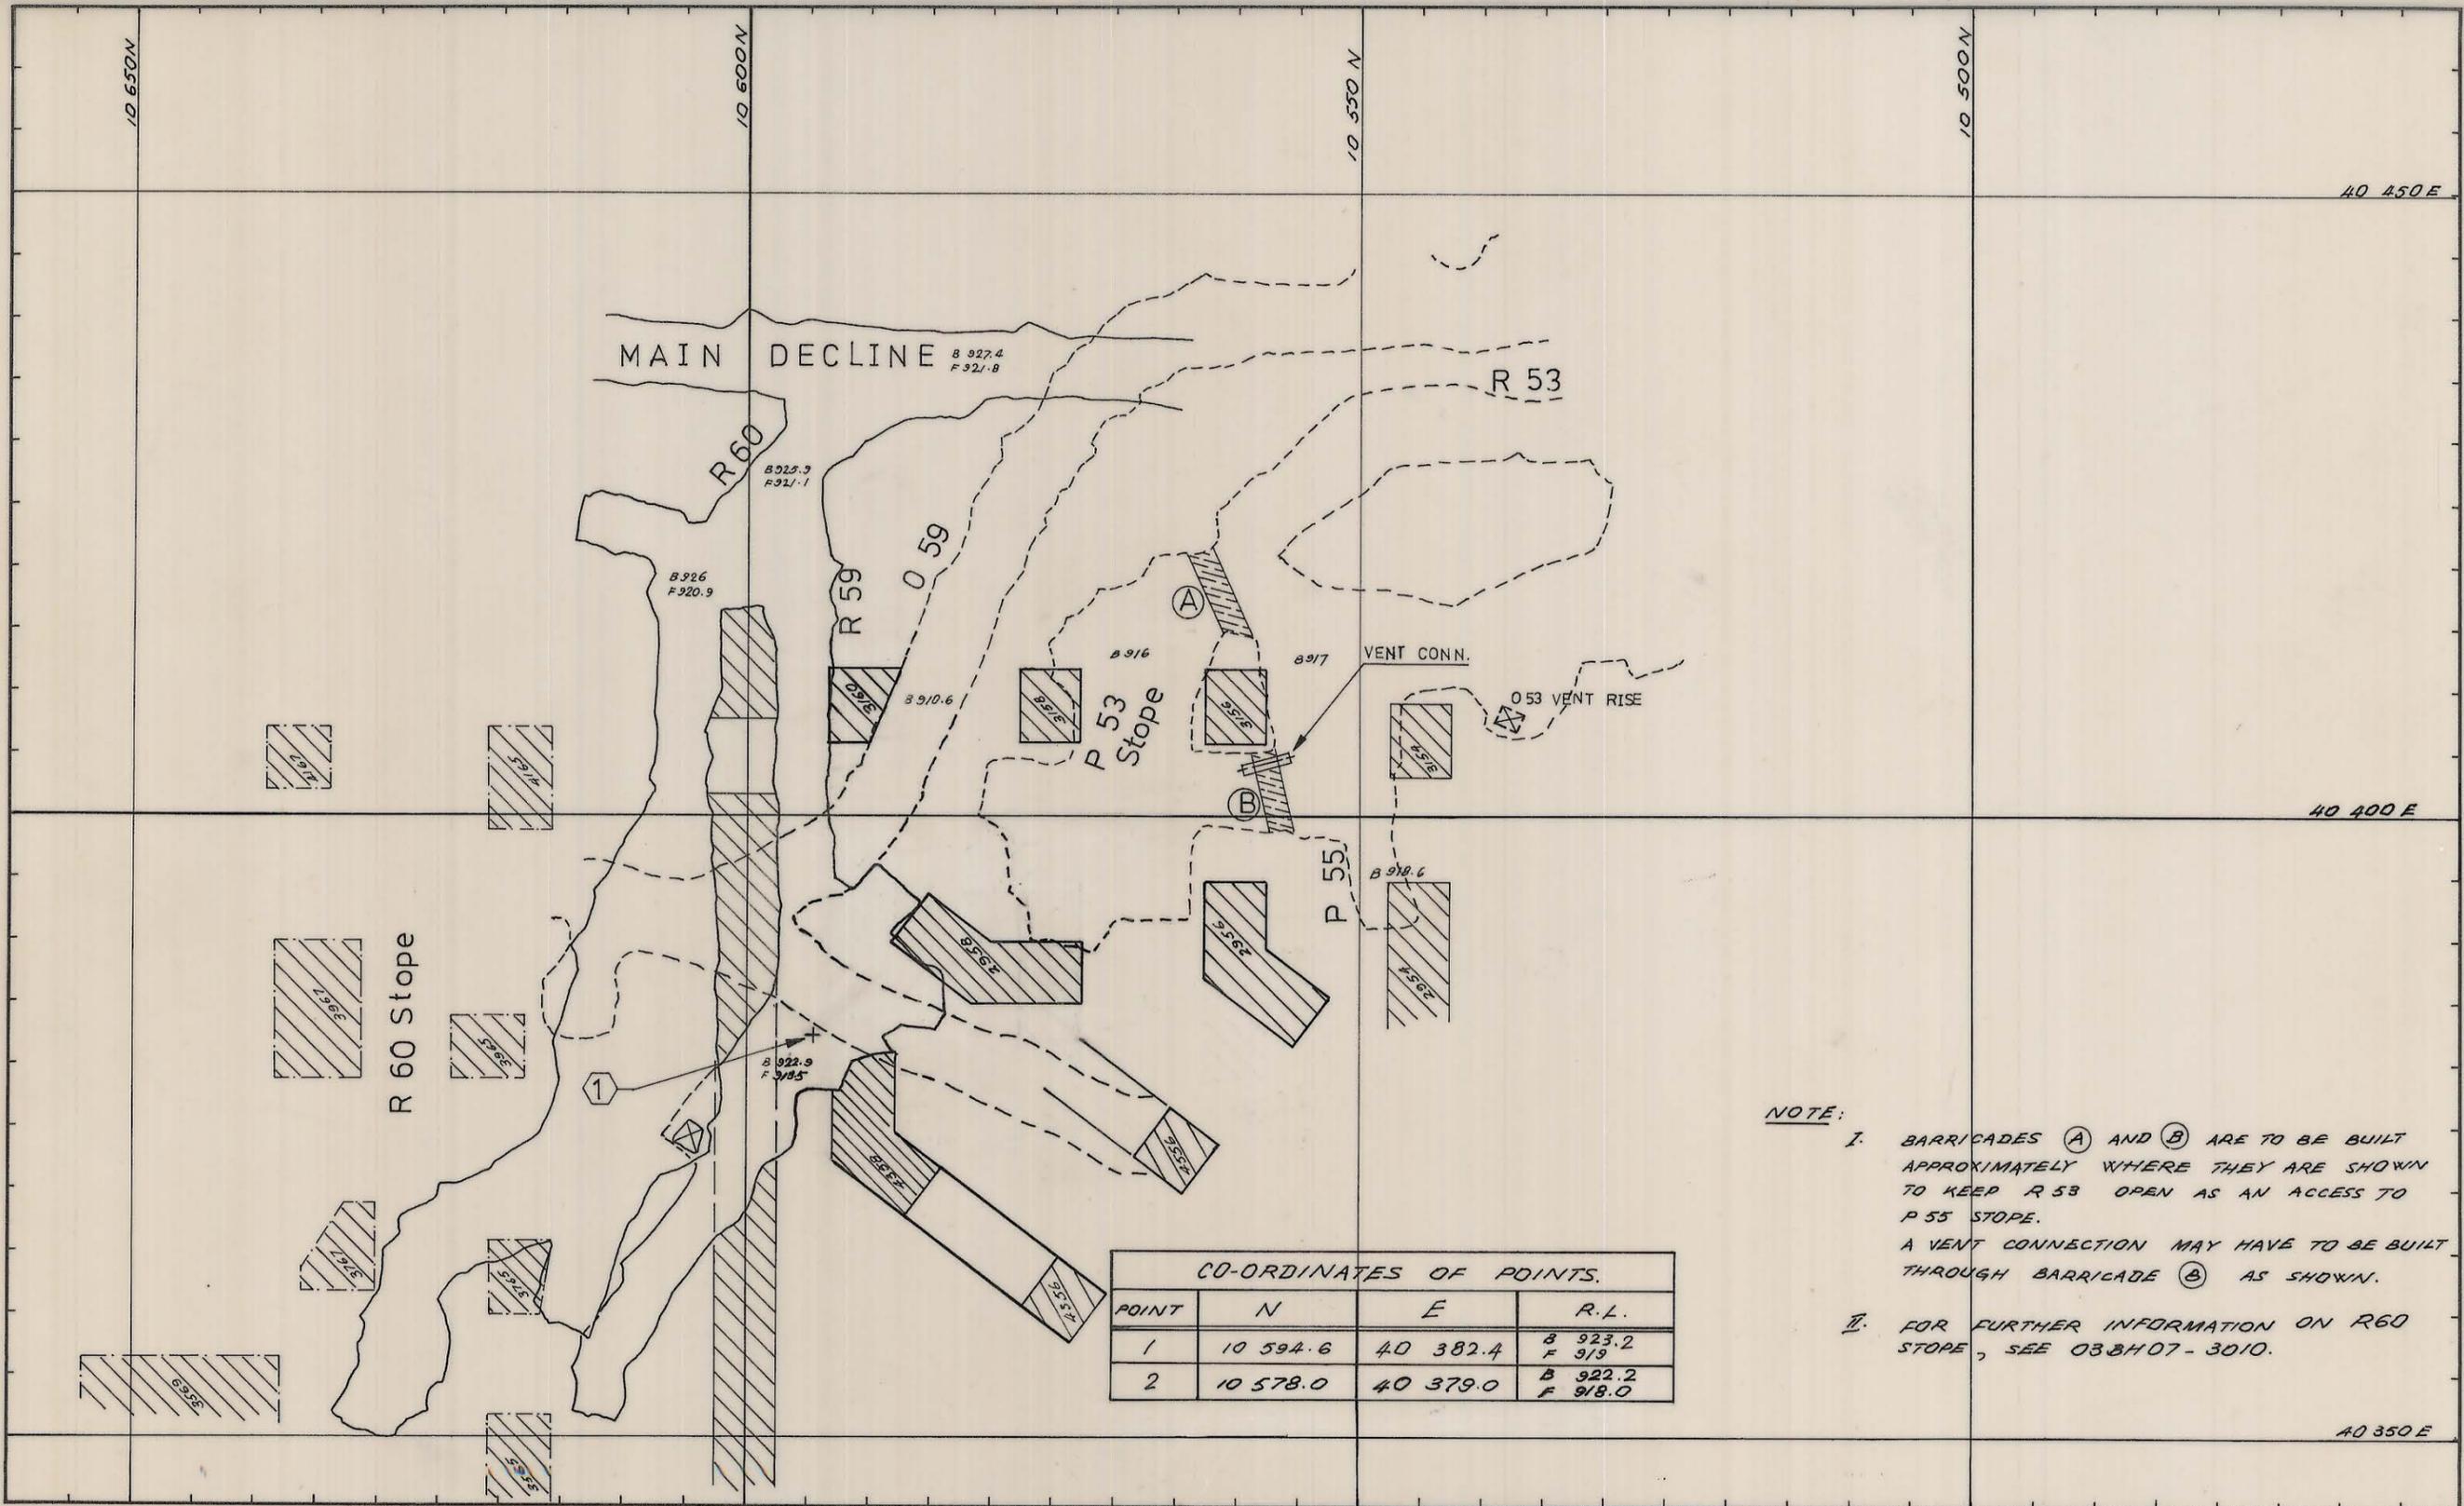

CO-ORDINATES OF POINTS.

POINT	N	E	R.L.
1	10 594.6	40 382.4	B 923.2 F 919
2	10 578.0	40 379.0	B 922.2 F 918.0

NOTE:

- I. BARRICADES (A) AND (B) ARE TO BE BUILT APPROXIMATELY WHERE THEY ARE SHOWN TO KEEP R 53 OPEN AS AN ACCESS TO P 55 STOPE. A VENT CONNECTION MAY HAVE TO BE BUILT THROUGH BARRICADE (B) AS SHOWN.
- II. FOR FURTHER INFORMATION ON R 60 STOPE, SEE 03BH07-3010.

REVISION 2:
N 59 IS EXTENDED.

G. Boumambally 17-12-80.


REVISION 1

GEOLOGY	<i>Terry P. Potter</i>	10-10-80
SURVEY		
PLANNING	<i>G. Boumambally</i>	10-10-80
ROCK MECHANICS		
MINE SUPT.		
GENERAL MINING SUPT.		
T.S.S.	<i>AGC</i>	10/00/80

REF PLAN 03BH11A-1012, 03BH11A-1013.

GEOLOGY	<i>L. G. G.</i>	10/9/80
SURVEY	<i>J. G. G.</i>	10/9/80
PLANNING	<i>P. B.</i>	8-9-80
ROCK MEC.	<i>AGC</i>	10-9-80
MINE SUPT.	<i>WJC</i>	12-9-80
GENERAL MINING SUPT.	<i>J. G. G.</i>	10-9-80
T.S.S.	<i>AGC</i>	9/9/80

SCALE 1: 500

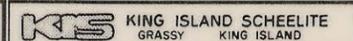

BOLD HEAD MINE.
ACCESS TO P53 STOPE
FOR LIFTS 4 & 5.

DRAWING NUMBER 03BH04-3011