


03 BH 04-4008

5 cm

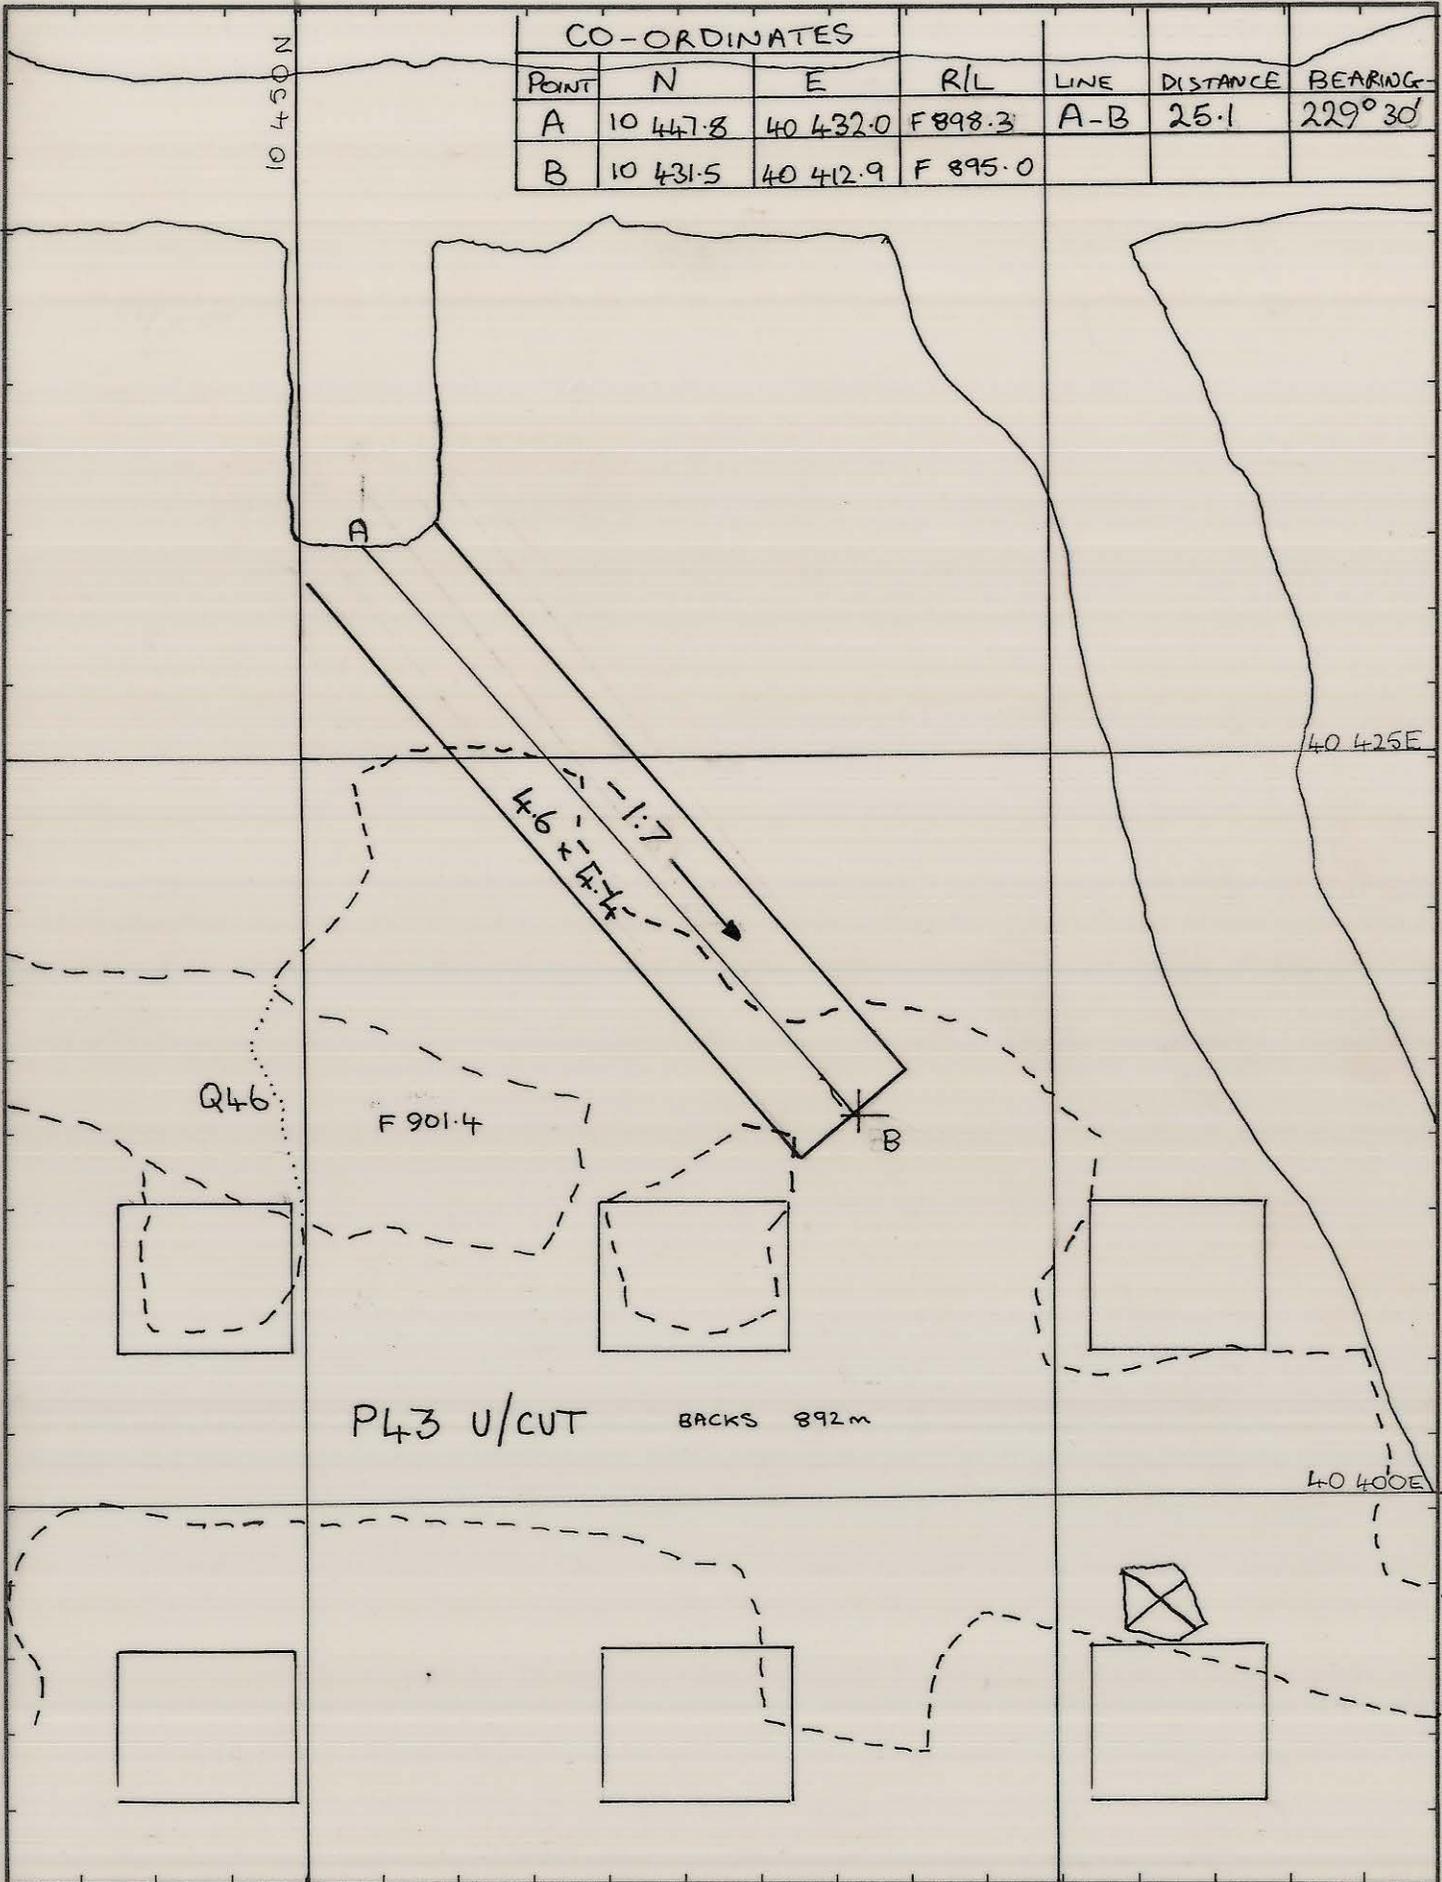

CO-ORDINATES						
POINT	N	E	R/L	LINE	DISTANCE	BEARING
A	10 447.8	40 432.0	F 898.3	A-B	25.1	229° 30'
B	10 431.5	40 412.9	F 895.0			

Q46

F 901.4

P43 U/CUT

BACKS 892 m

40 425 E

40 400 E

REF PLAN 04 BH 12 - 156 252S	GEOLOGY	CTK	3/4/82	1:250	KIS KING ISLAND SCHEELITE GRASSY KING ISLAND
	SURVEY	BAL	3/4/82	SCALE	
	PLANNING	ADT	3-5-82	REVISION TO T44	
	ROCK.MEC.	JKW	3.5.82		
	Min Sup			DRAWING NUMBER	
	GMS				
	T.S.S.	24B	3/5/82	03 BH 04 - 4008	

0374_3881