


03BH04-4010

0374_3883

5 cm

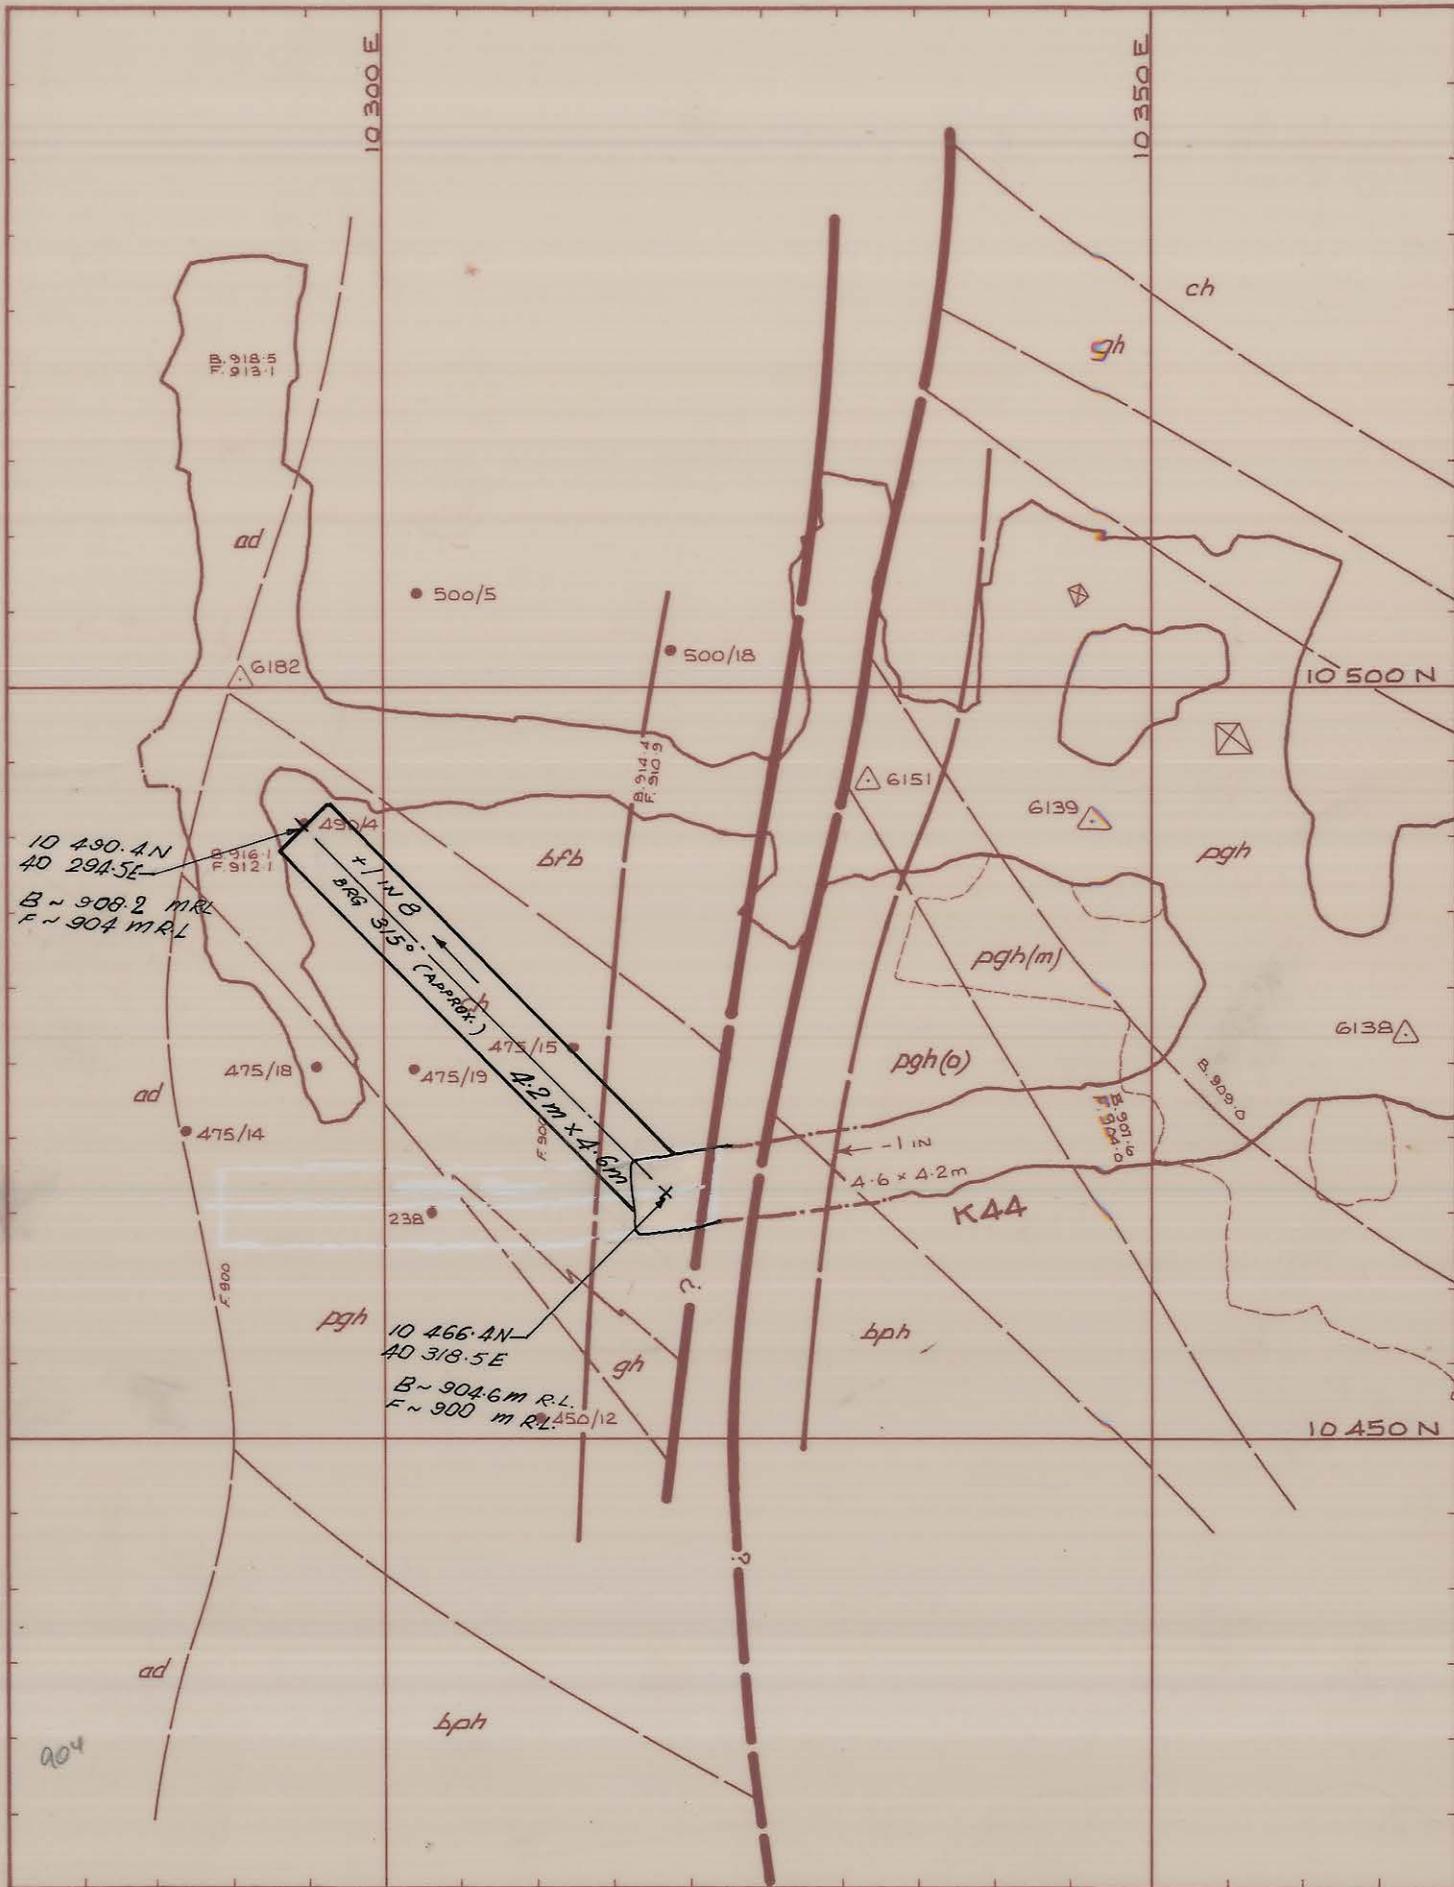

REF. PLAN 03BH04-3022

GEOLOGY *1/45 3/9/02*

1:500 SCALE

KIS KING ISLAND SCHEELITE GRASSY KING ISLAND

N.B. THIS PLAN SUPERSEEDS PLAN 03BH04-3022.

SURVEY

PLANNING *P.B. 3-8-82*

ROCK MEC. *7/ 3 8 82*

MINE SUPT.

G.M.S.

T.S.S.

BOLD HEAD MINE
K44 - C WEST STOPE ACCESS
GEOLOGY at 900mRL.

DRAWING NUMBER

03BH04-4010