
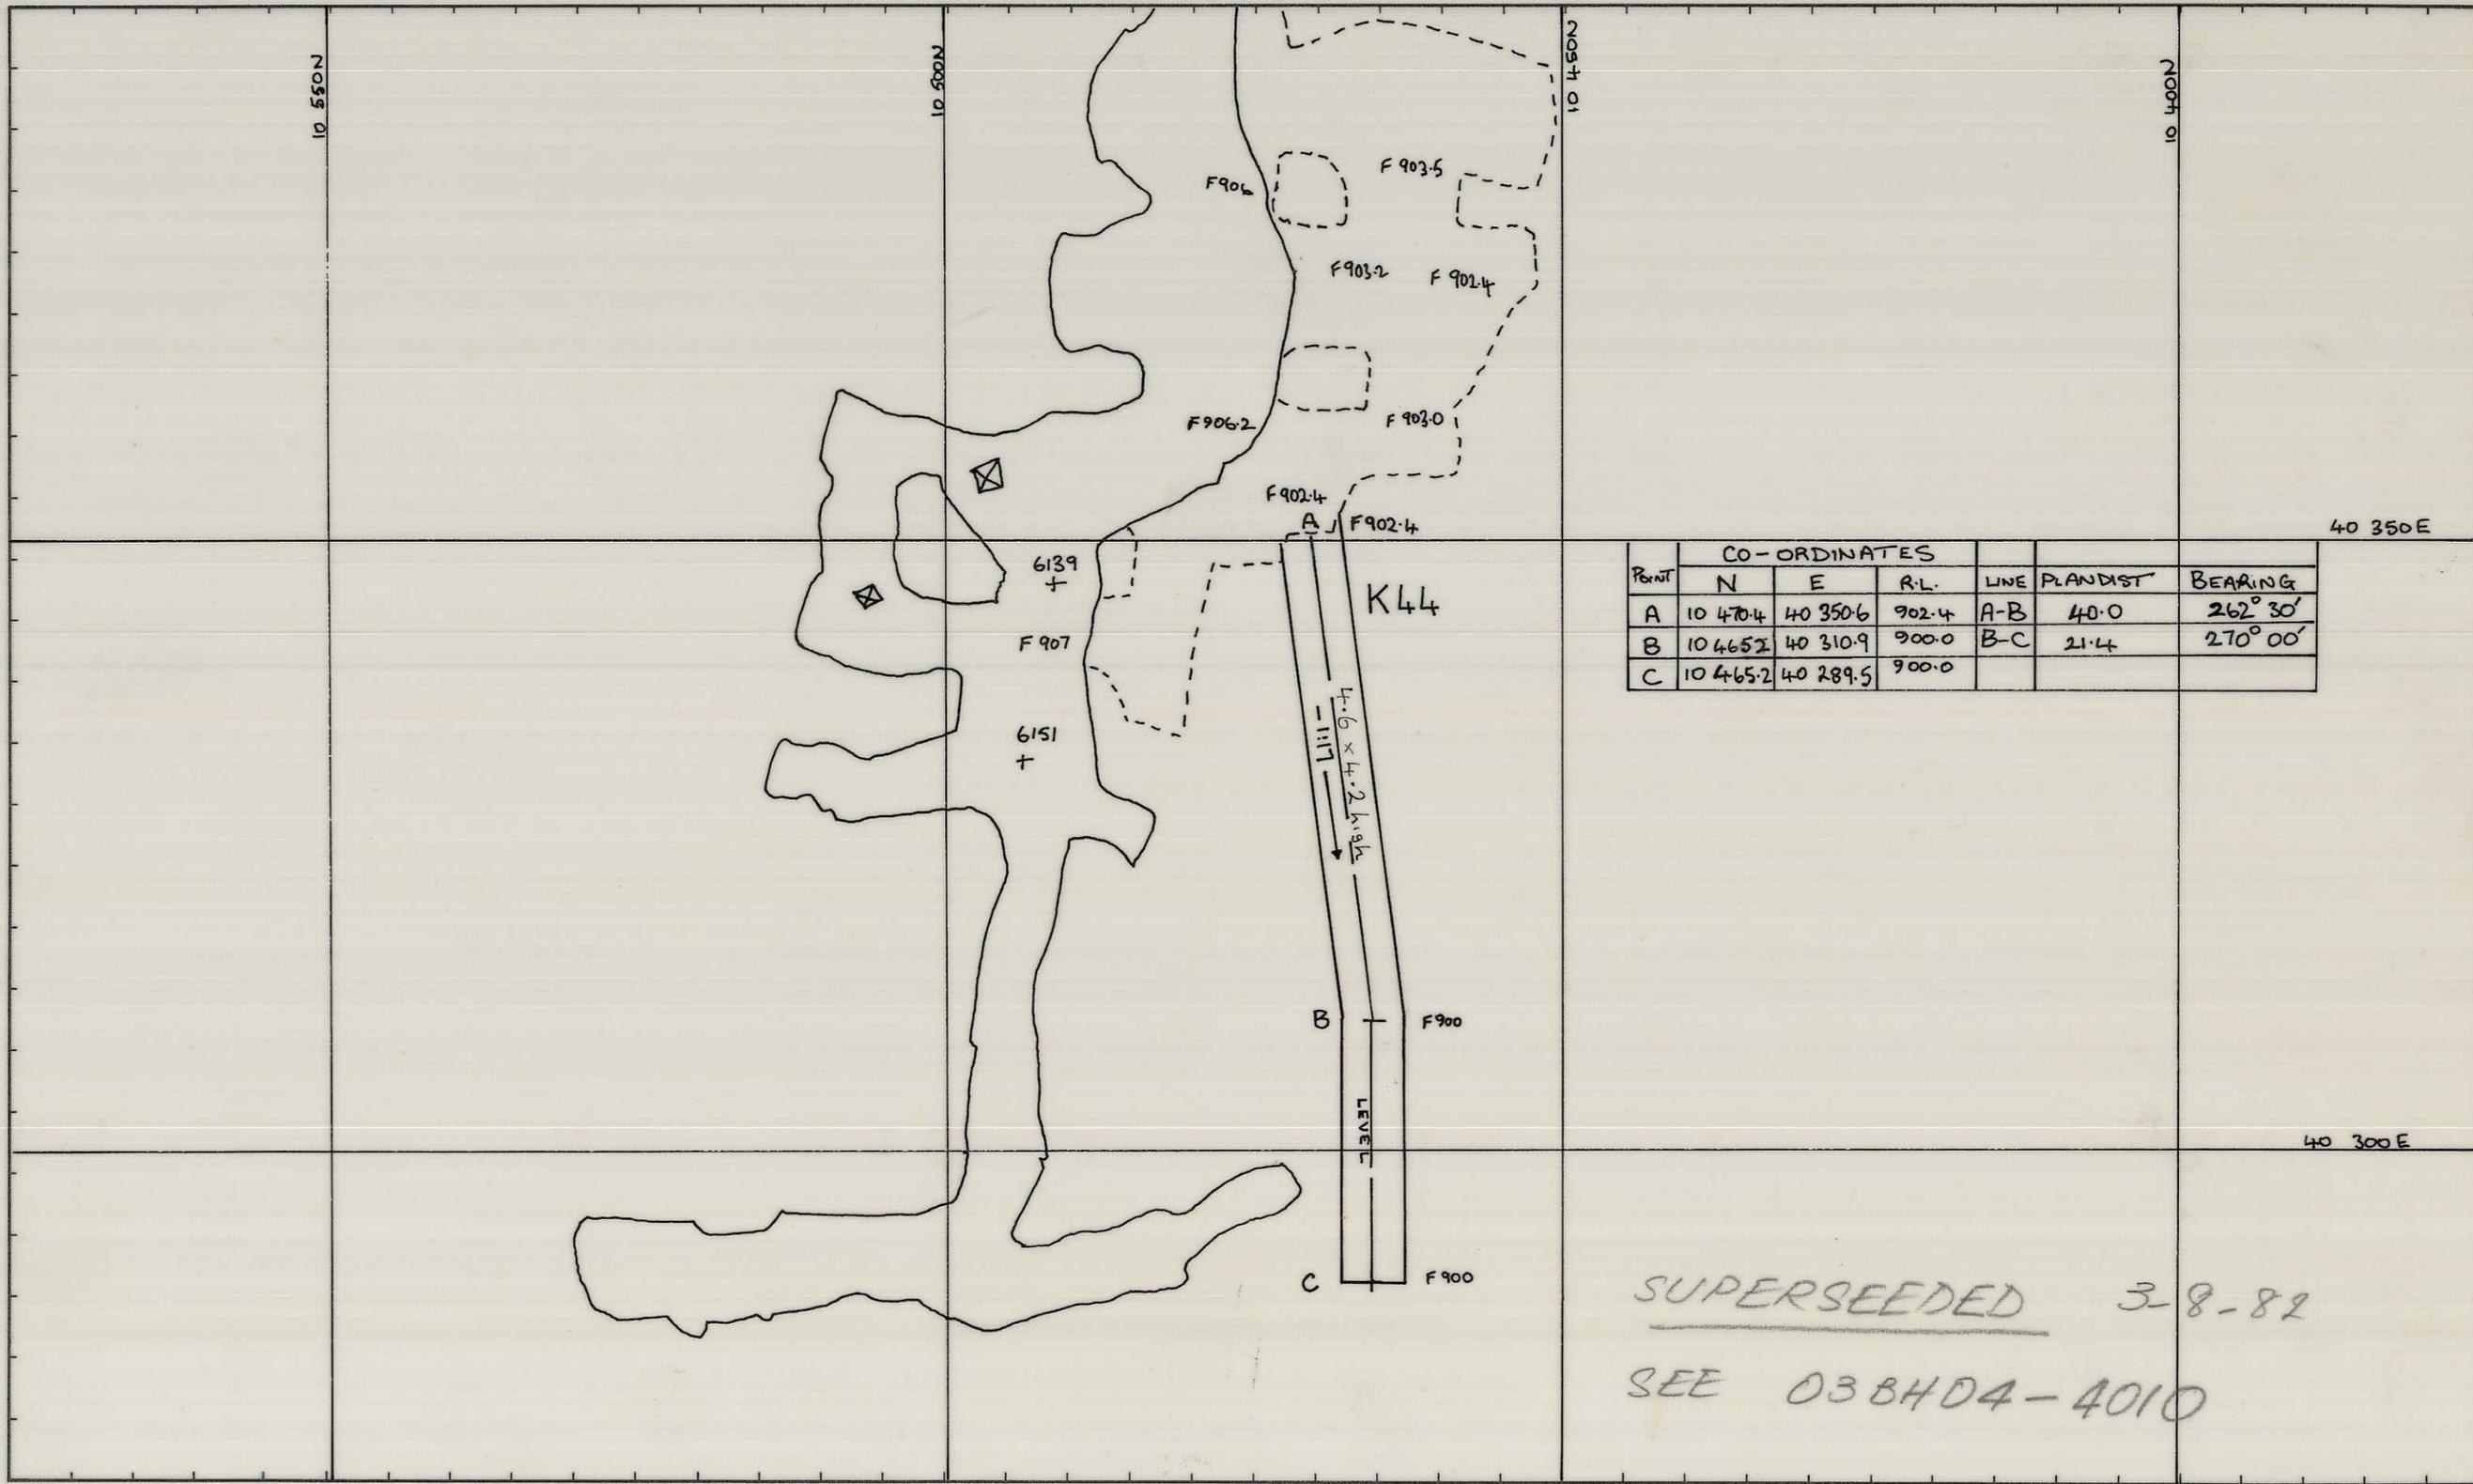


0374_3889

03BH04-3022

465-2 310.94
465-2 289.54

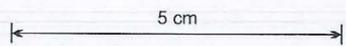

SUPERSEDED 3-8-82
SEE 03BH04-4010

FLOOR OF T47 U/C TO BE MUCKED OUT AND GRADED TO PROVIDE ACCESS.

REF PLAN
B/HM/S: MARD

GEOLOGY		
SURVEY	BK.	12/4/82
PLANNING	ADJ	8-4-82
ROCK MEC.		
GRADE CON.		
DRAFTING		
T.S.S.		

SCALE 1:500

KIS KING ISLAND SCHEELITE GRASSY KING ISLAND

BOLD HEAD
K44 (C WEST) STOPE ACCESS

DRAWING NUMBER
03 BH 04 - 3022