


27 JUN 1981

0374\_3899

03 BH 07 - 3003  
BF<sub>2</sub> U/C

5 cm

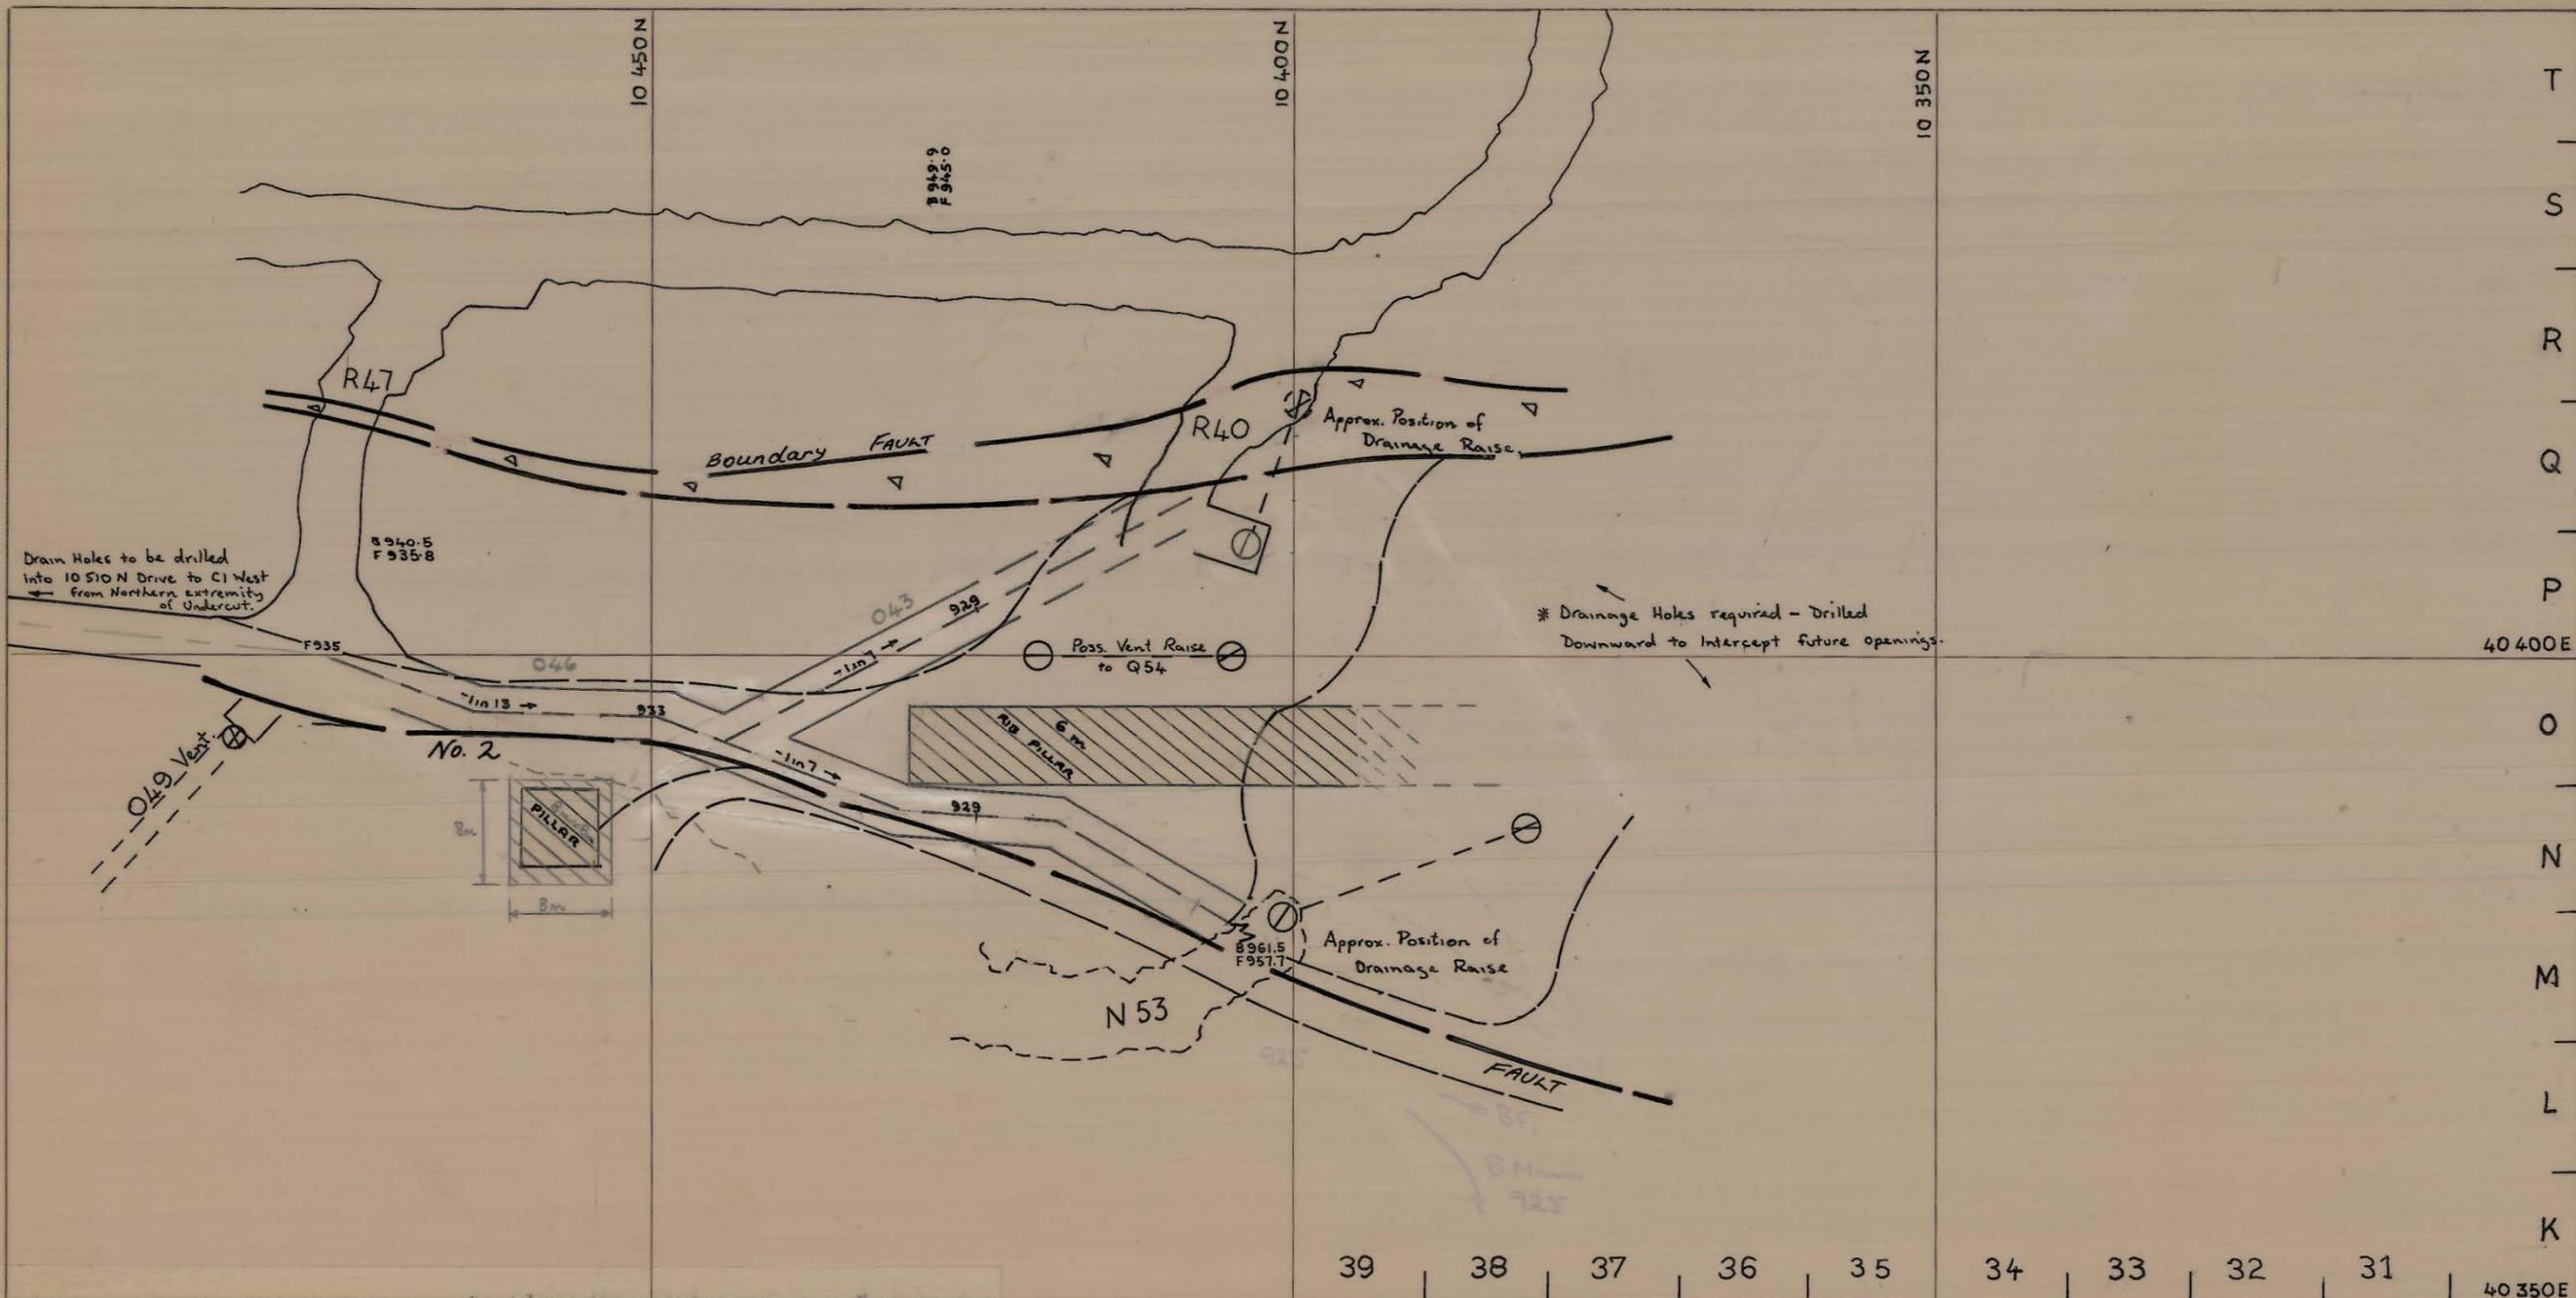

REVISIONS	NO	DATE	DESCRIPTION	INITIALS
	1	8.8.78	6m x 6m PILLAR INCREASED TO 8m x 8m SIZE	EW

N.B. \* ORE BODY OUTLINE SHOWN IN PLANE OF UNDERCUT AT 1:7 GRADIENT.  
 \* BF<sub>2</sub> UNDERCUT SOUTH - FOLLOW NO. 2 FAULT TO 10 450 N AS SHOWN, THEN FOLLOW SURVEY DIRECTION LINES FROM 10 450 N SOUTHWARD.

**KING ISLAND SCHEELITE**

DATE: 1 AUGUST 1977 SCALE: 1:500  
 MINE: BOLD HEAD DWG/NO.: 03 BH 07 - 3003

PROPOSED LAYOUT FOR  
BF<sub>2</sub> UNDERCUT

APPROVAL

PLANNING ENG.:	EW	COPY
SENIOR PLAN. ENG.:	BS	
MINE SUPT.:	M. J. M.	3
G. MINING SUPT.:	D. J. M.	1
SENIOR SURV'R.:	J. M.	1
SENIOR GEOLOGIST:	S. J. B.	
SURVEYOR:		

PRELIMINARY      FINAL

49    48    47    46    45    44    43    42    41    40