


0374\_3904

03BH04 - 3014

5 cm

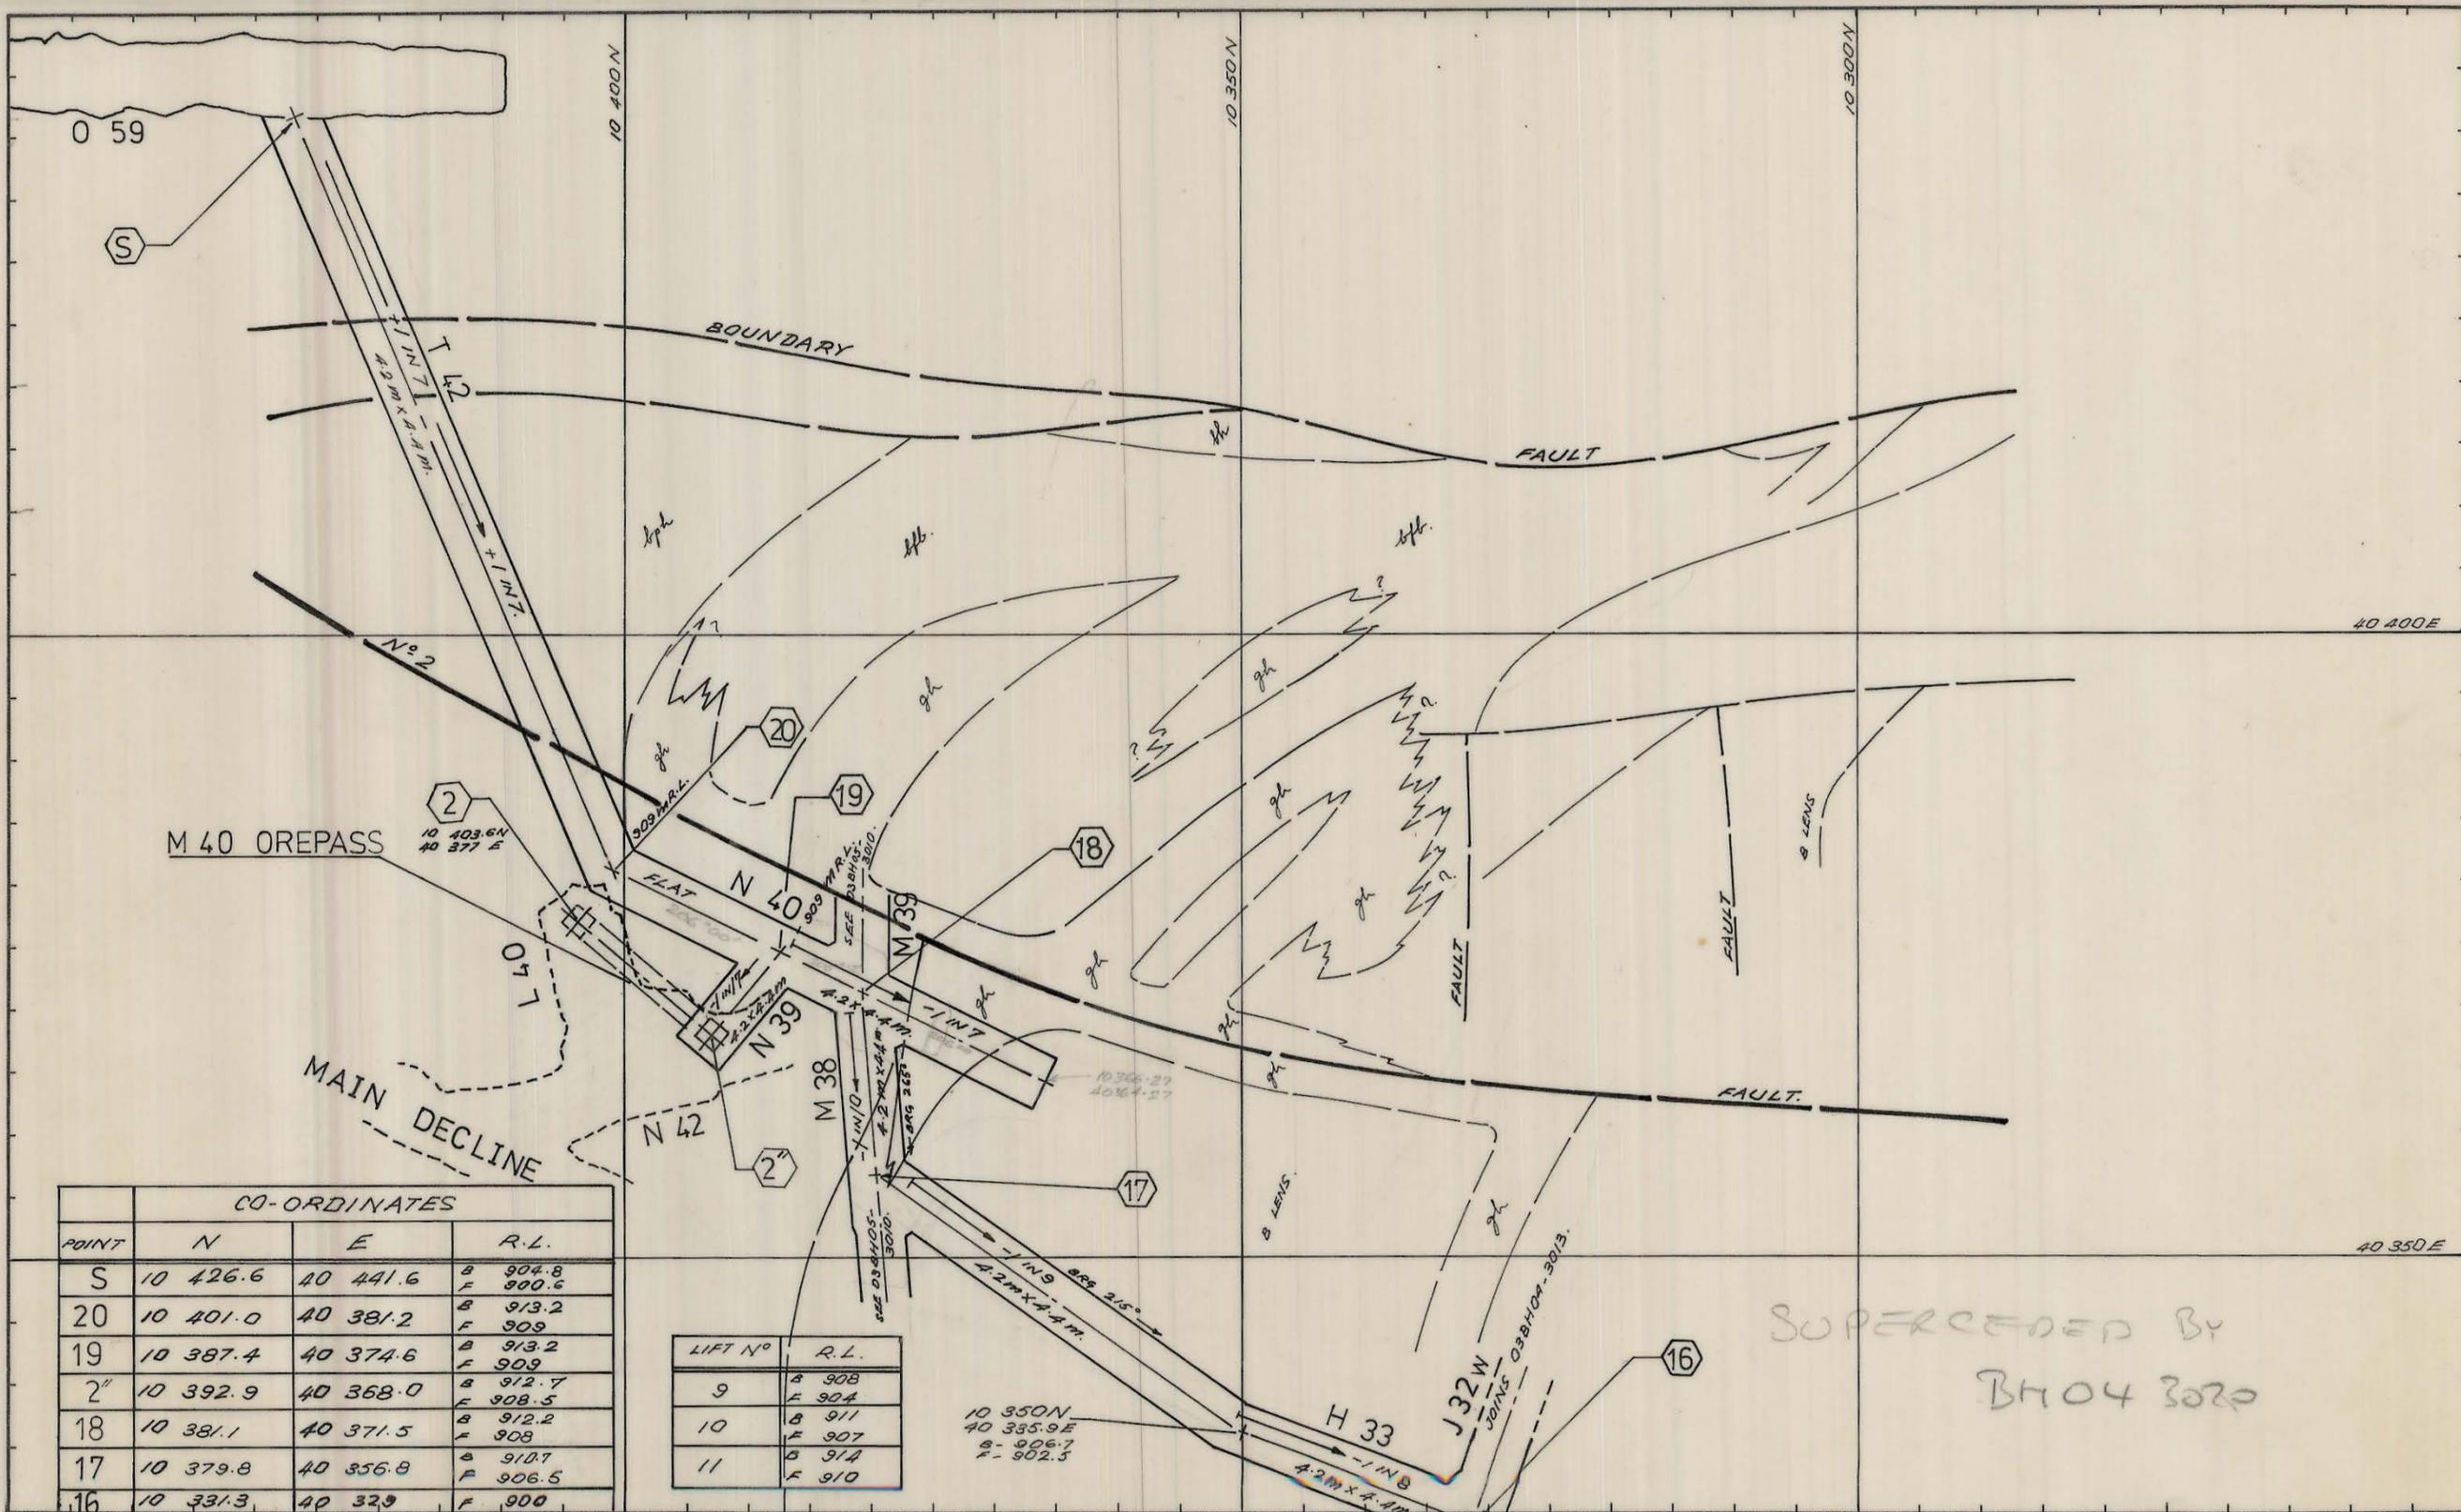

POINT	CO-ORDINATES		
	N	E	R.L.
S	10 426.6	40 441.6	B 904.8 F 900.6
20	10 401.0	40 381.2	B 913.2 F 909
19	10 387.4	40 374.6	B 913.2 F 909
2"	10 392.9	40 368.0	B 912.7 F 908.5
18	10 381.1	40 371.5	B 912.2 F 908
17	10 379.8	40 356.8	B 910.7 F 906.5
16	10 331.3	40 329	F 900

LIFT NO	R.L.
9	B 908 F 904
10	B 911 F 907
11	B 914 F 910

REVISION N<sup>o</sup>:  
 1. M 40 OREPASS, N 40 AND N 39. (P.B. 13-2-81).  
 2. M 38 AND H 33. (4-6-81). P.B.

N.B. TO AVOID LEAVING A CROWN PILLAR, MINING OF THE 9TH LIFT SHOULD BE CONFINED TO THE AREA WEST OF N<sup>o</sup> 2 FAULT ONLY.

REF PLAN 04BH14-1013

PRELIMINARY GEOLOGY AT 907.5 m R.L., AND DATED NOV., 1980. (BY T.F. POTTER).

GEOLOGY	T.F. Potter	26 Nov 80
SURVEY	W.S.C.	28/11/80
PLANNING	P.B.	12-11-80
ROCK MEC.	J.P.	1/12/80
MINE SUPT.	W.S.C.	28/11/1980
GENERAL MINING SUPT.	W.S.C.	18/11/80
T.S.S.	W.S.C.	18/11/80

SCALE 1: 500

KIS KING ISLAND SCHEELITE GRASSY KING ISLAND

BOLD HEAD MINE LOWER FAULT BLOCK-LIFTS 9, 10, 11.

DRAWING NUMBER 03BH04 - 3014/1-2