


0374\_3916

03BH05-3019

5 cm

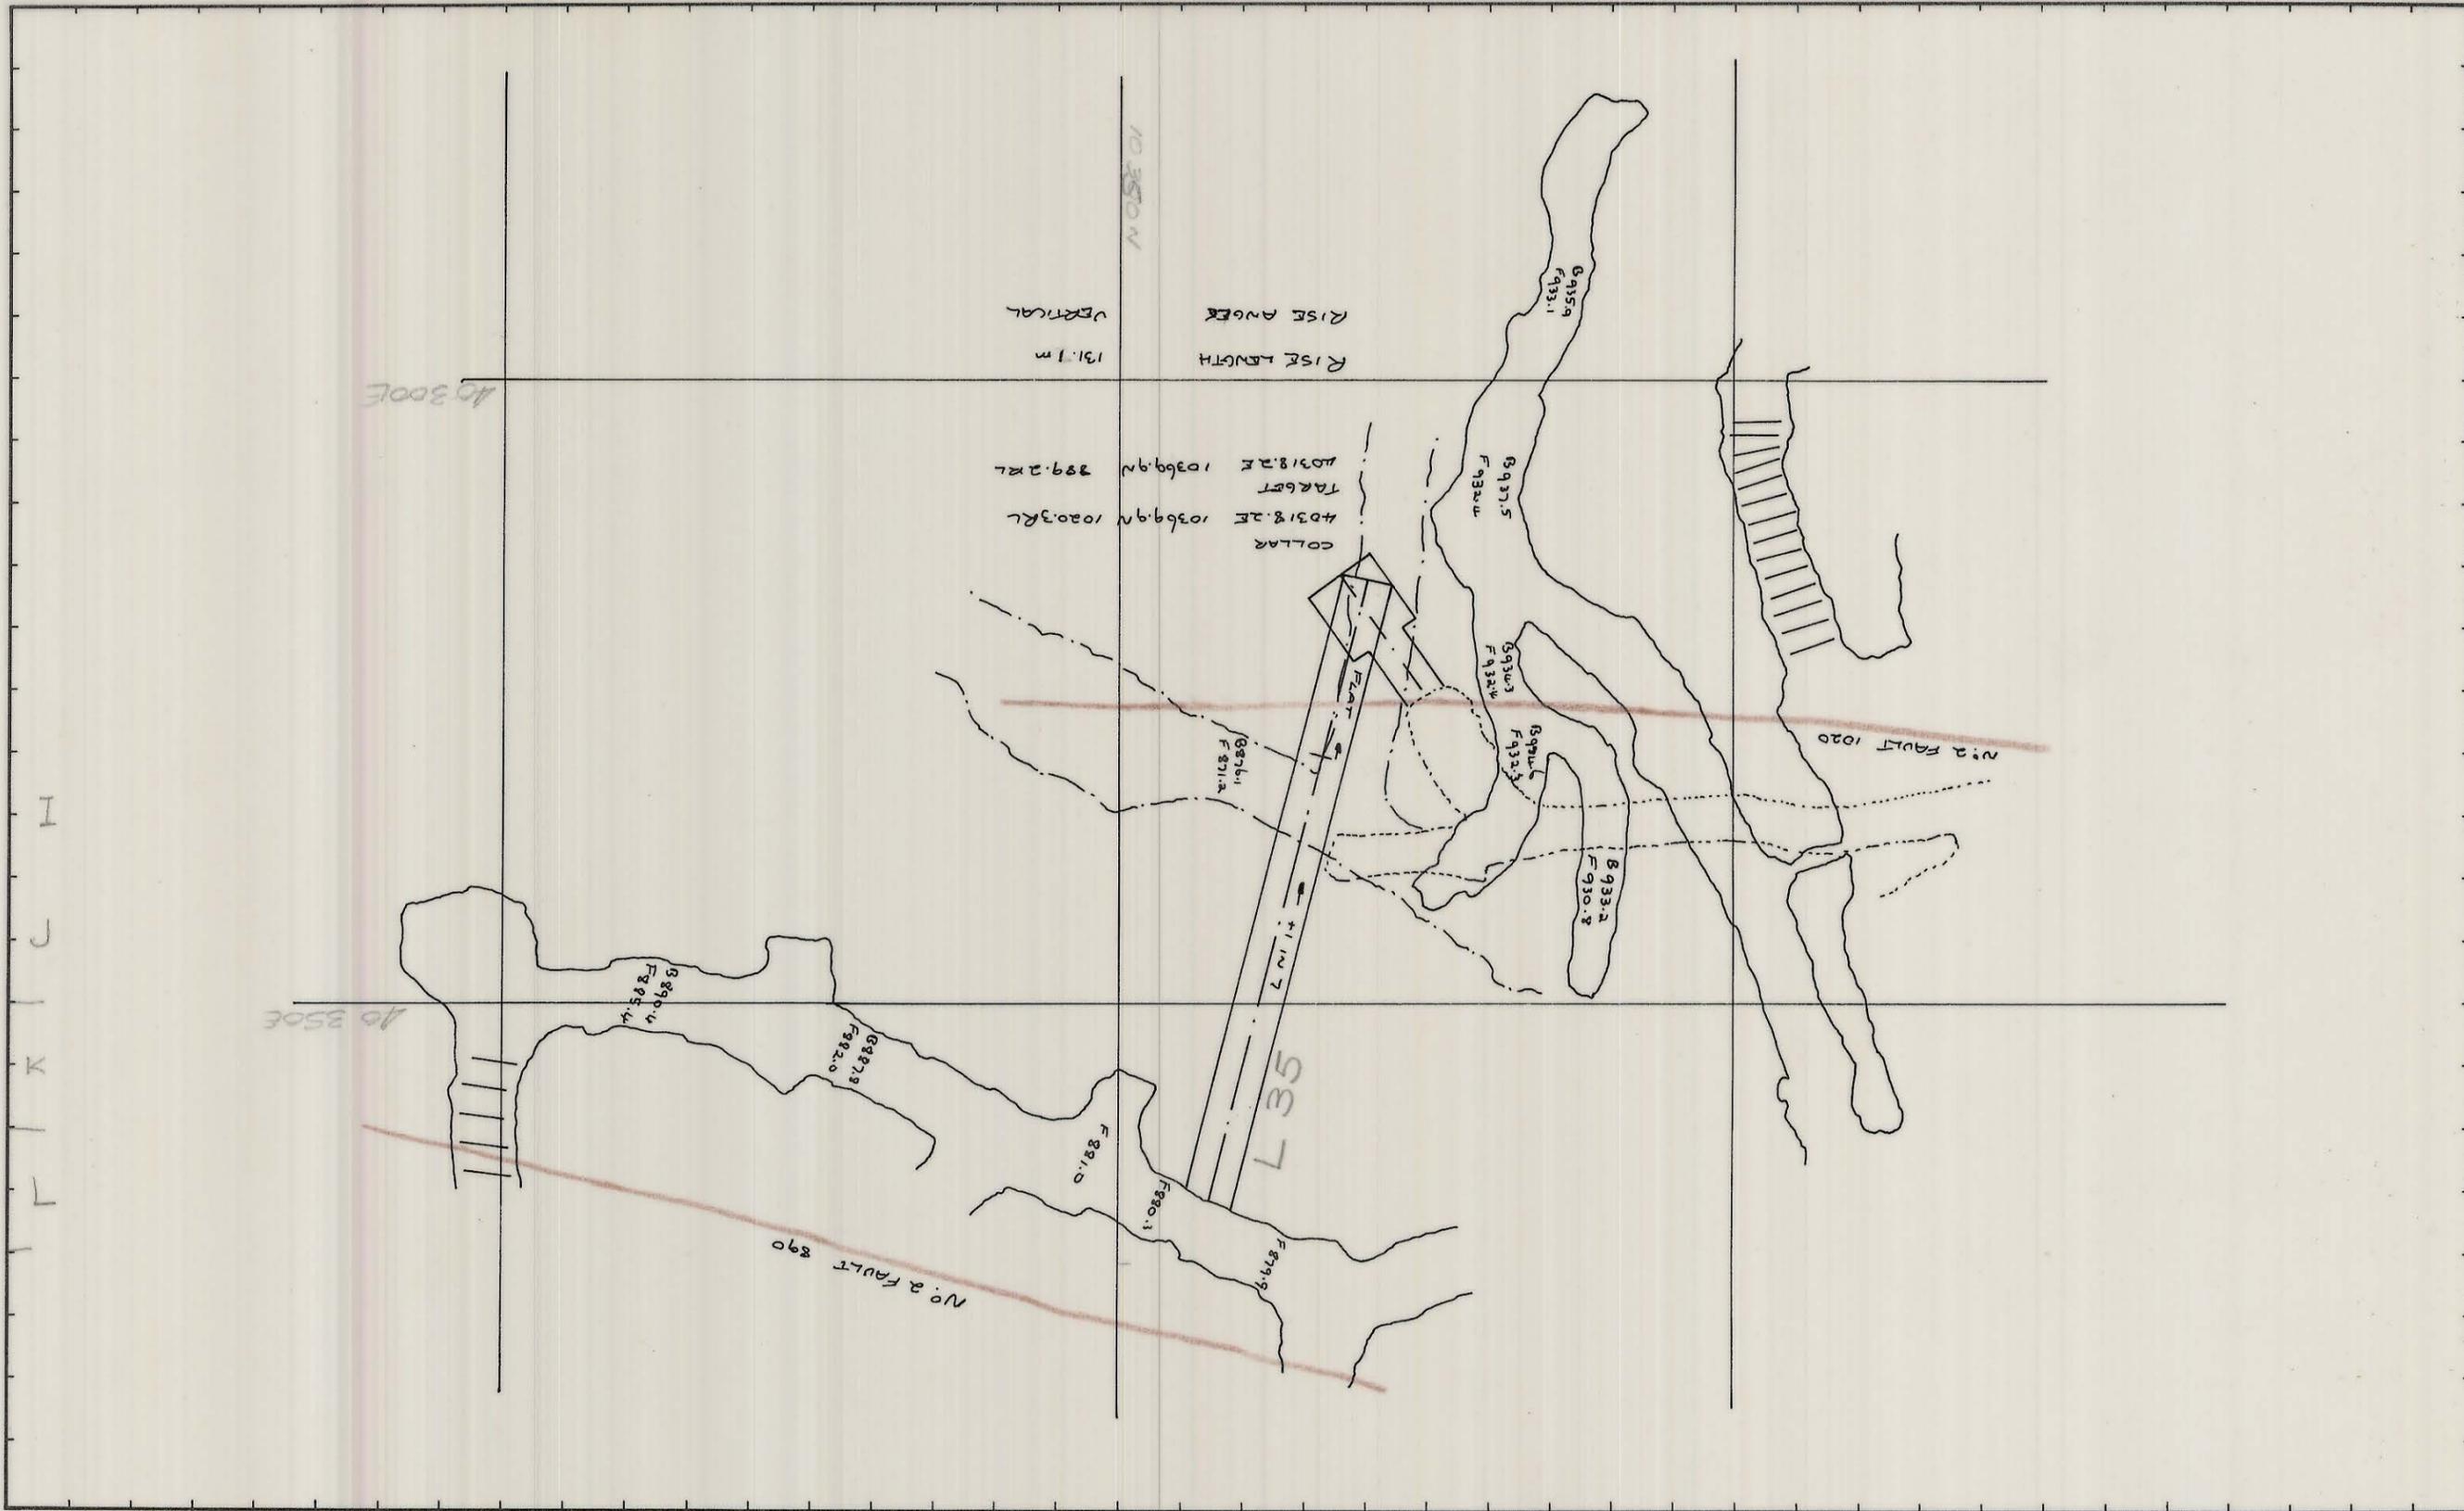

REF PLAN	03BH05-3018
GEOLOGY	
SURVEY	
PLANNING	
ROCK MEC.	
GRADE CON.	
DRAFTING	
T.S.S.	29/8/83

SCALE	1:500
<p>BOLD HEAD MINE MAIN VENTILATION - LOWER RAISE BORE HOLE - REVISED TARGET</p>	
DRAWING NUMBER	03BH05-3019

REF PLAN	03BH05-3018
GEOLOGY	
SURVEY	
PLANNING	
ROCK MEC.	
GRADE CON.	
DRAFTING	
T.S.S.	29/8/83