


0374-392

04DM15 - 1007
SHEET THREE 1997



SCALE 1:500

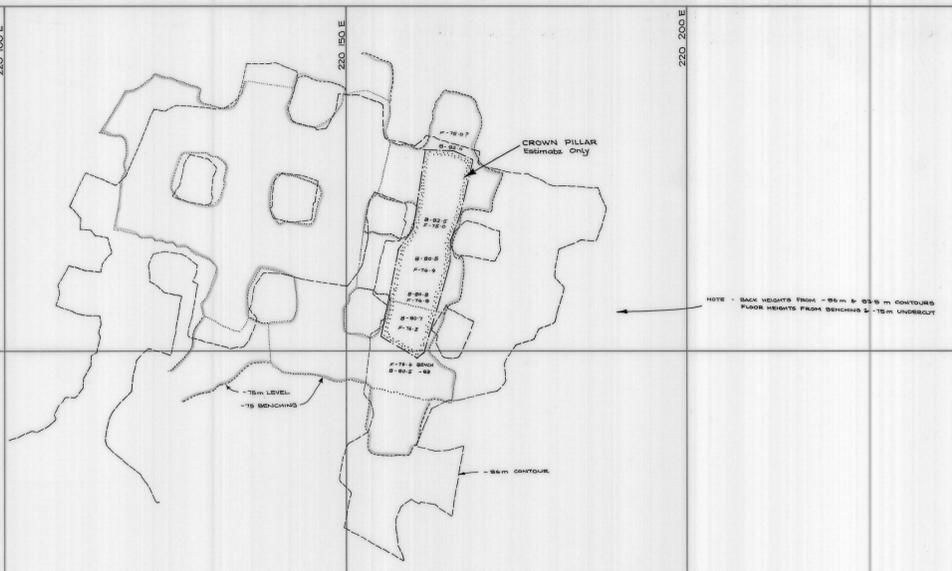

LOCATION
DOLPHIN MINE

SUBJECT
WEDGE STOPE
CROWN PILLAR

KIS KING ISLAND SCHEELITE
A DIVISION OF WARMAN INTERNATIONAL

GRASSY KING ISLAND

PLAN NUMBER
04DM15 - 1007