


03BH05-4007



BOLD HEAD
S62 VENT RISE

0374_3925

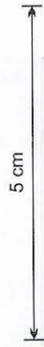


27 JUN 1981

Rise collar	40420.5 E	10615.2 N	925.2 RL
Rise target	40422.3 E	10633.5 N	954.7 RL

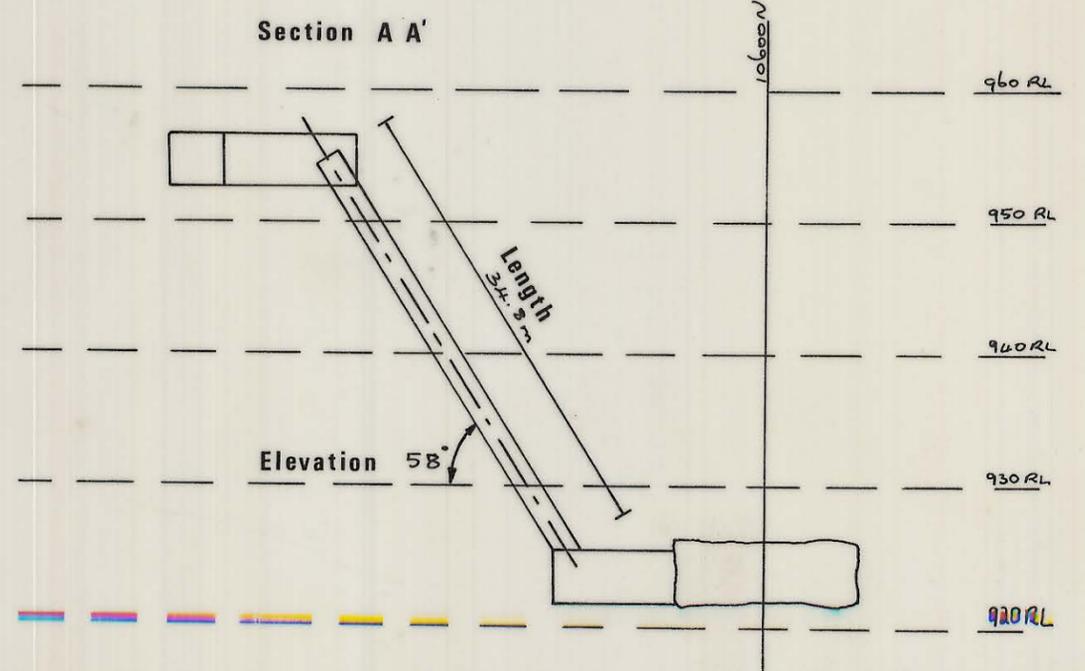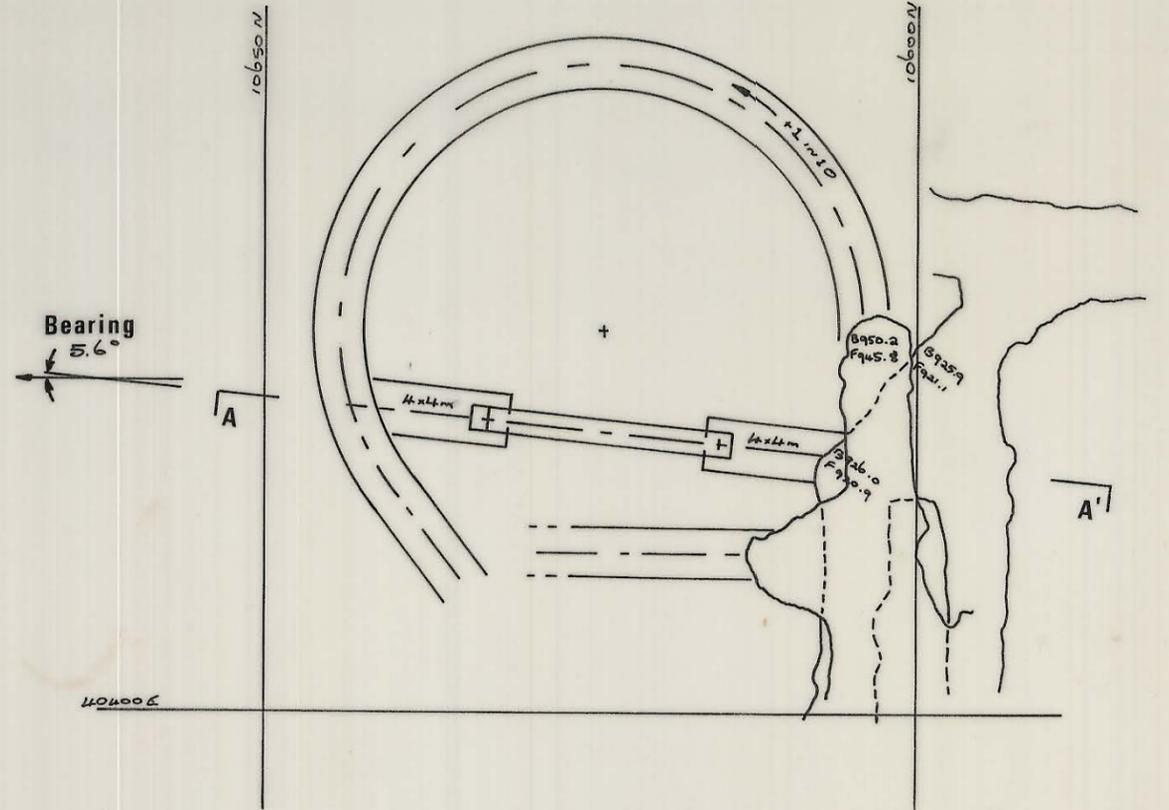

LEGEND:

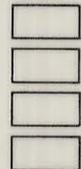

WJ Conley
Jay



DATE: 7/5/80
 GEOL:
 DWN: JJC
 CHKD: JJC

GEOPEKO LIMITED
KING ISLAND

Scale: 1:500

No K

BOLD HEAD MINE
S62 VENT RISE

03BH05-4007