
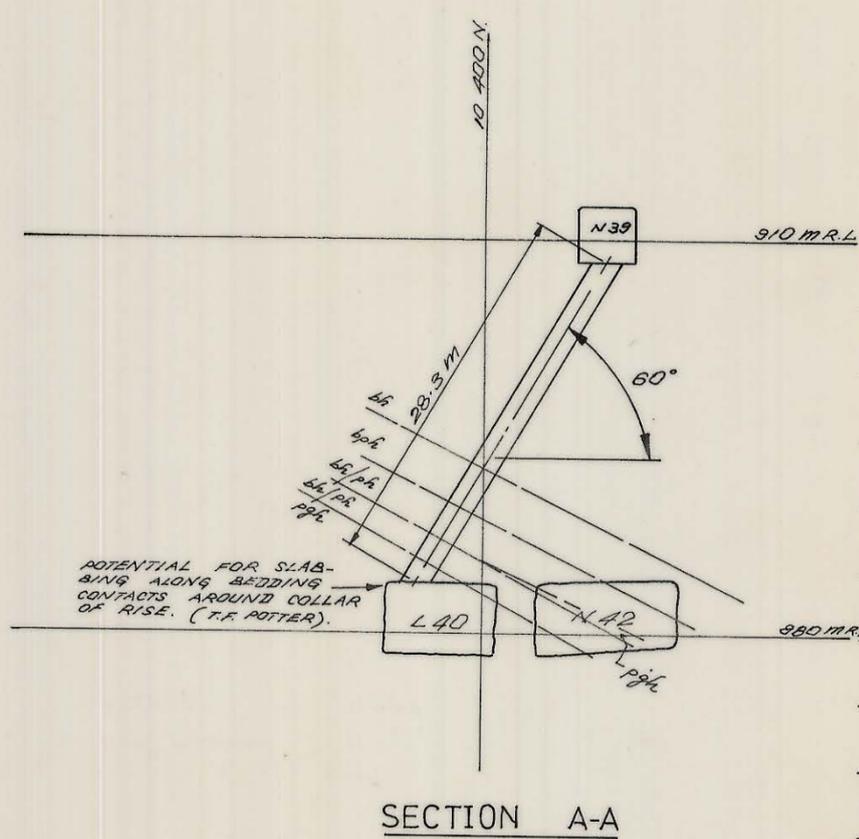


5 cm

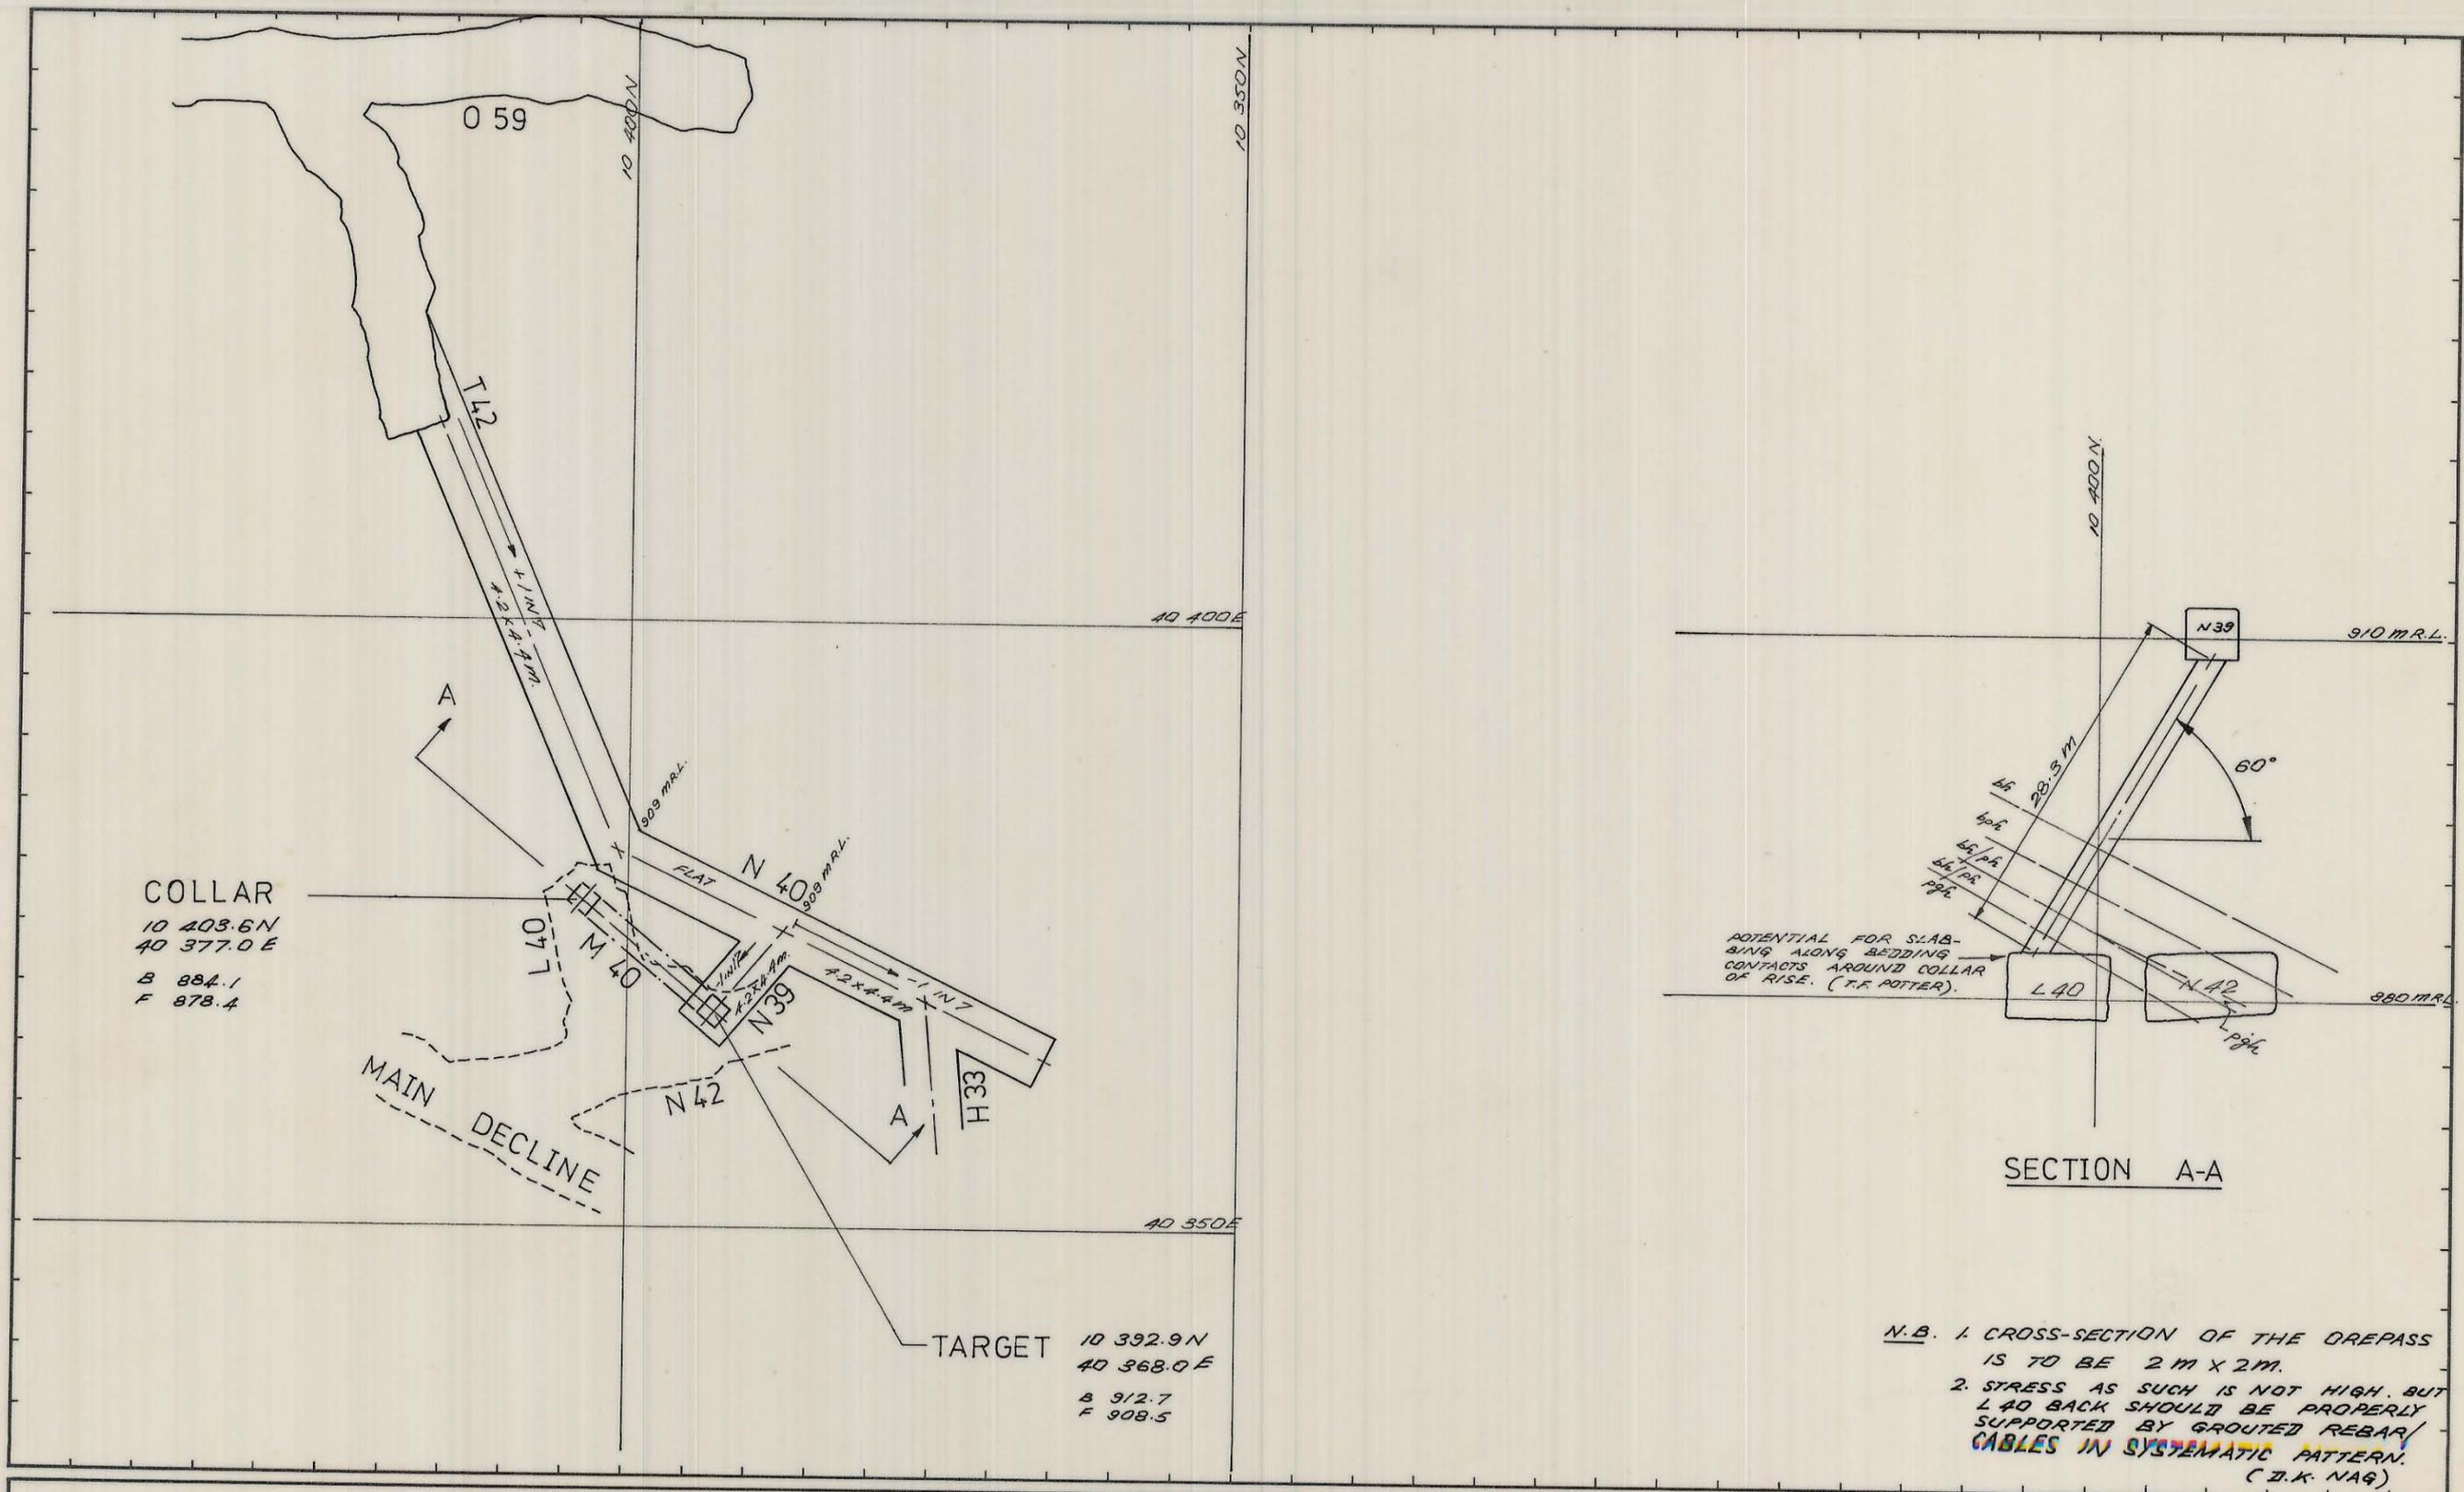

N.B. 1. CROSS-SECTION OF THE OREPASS IS TO BE 2 M X 2 M.
 2. STRESS AS SUCH IS NOT HIGH, BUT L 40 BACK SHOULD BE PROPERLY SUPPORTED BY GROUDED REBAR/CABLES IN SYSTEMATIC PATTERN. (D.K. NAG)

REF PLAN 03BH14 - 1013/1014.	GEOLOGY	Terry F. Potter	19 th FEB '81	SCALE 1: 500	KING ISLAND SCHEELITE GRASSY KING ISLAND
	SURVEY	[Signature]	17/2/81		
	PLANNING	P.B.	17.2.81		
	ROCK MEC.	[Signature]	20 Feb '81		
	MINE SUPT.	[Signature]	27/2/81		
G.M.S.	[Signature]	4/2/81	DRAWING NUMBER	03BH06 - 3002	
T.S.S.	[Signature]	6/3/81			
BOLD HEAD MINE M 40 OREPASS					