


0374\_3951

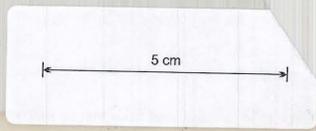

10 650 N

10 625 N

10 600 N


10 550 N

40 450 E

40 400 E

40 375 E

934 m RL

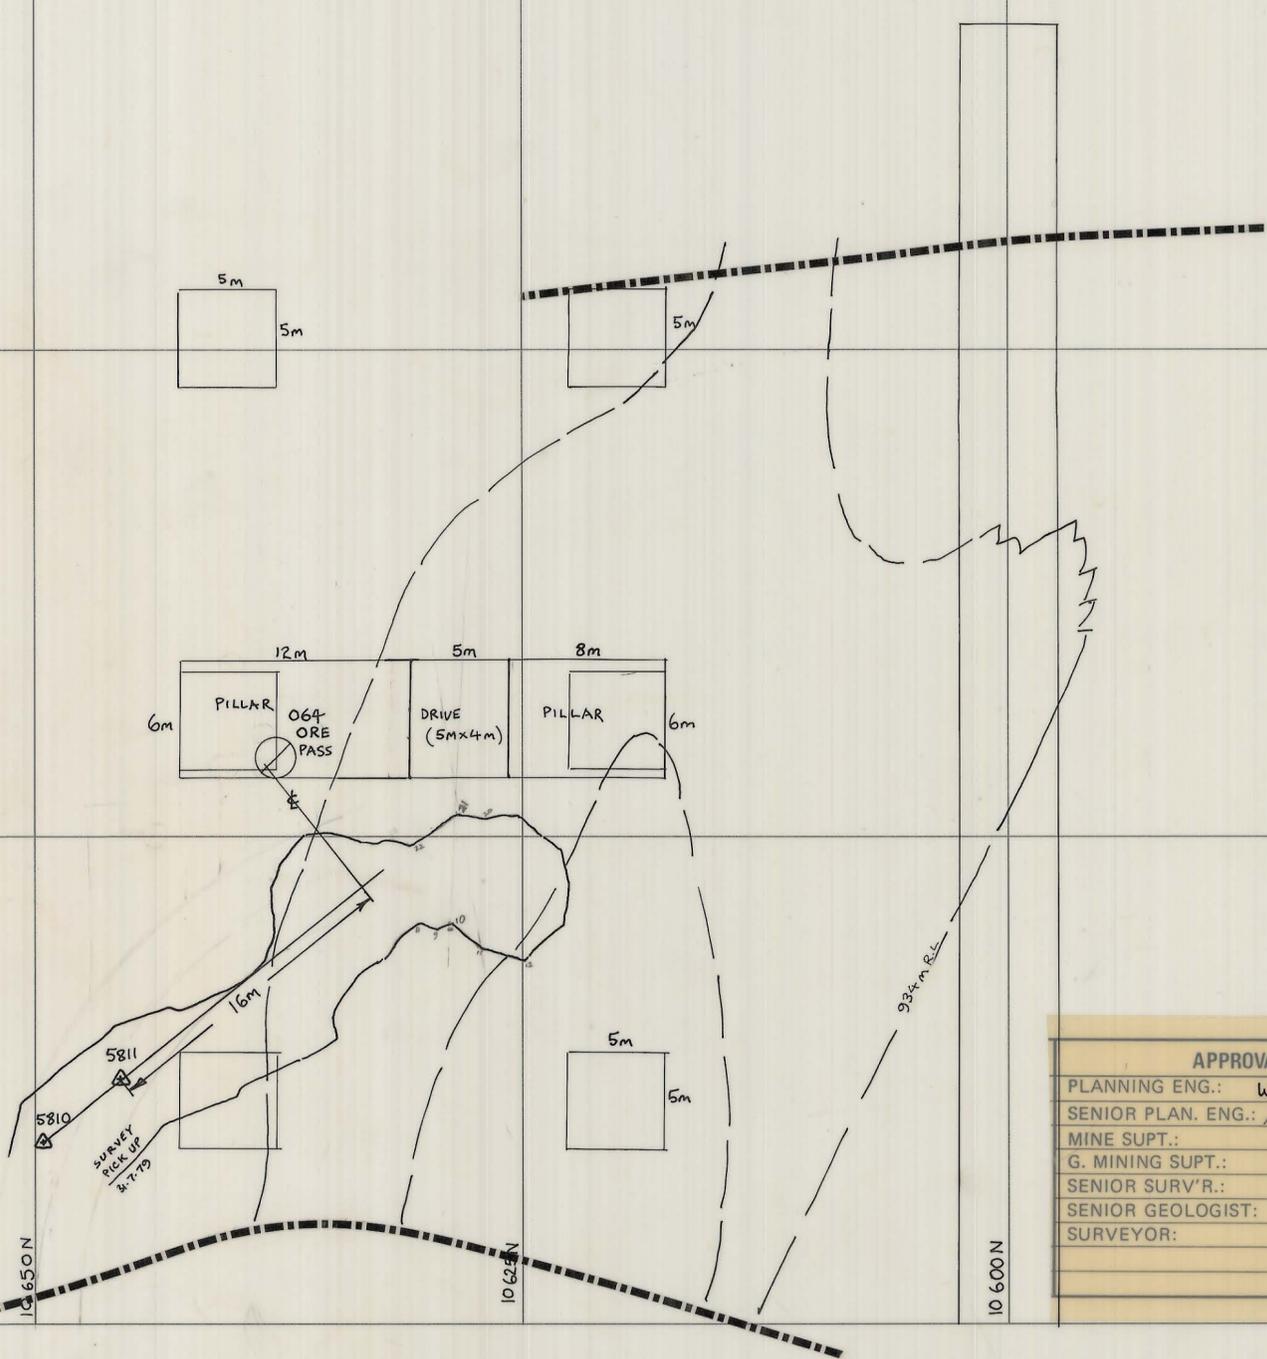

APPROVAL		COPY
PLANNING ENG.:	<i>WJ Crossley</i>	
SENIOR PLAN. ENG.:	<i>M.D.M. 1/8/79</i>	
MINE SUPT.:		
G. MINING SUPT.:		
SENIOR SURV'R.:	<i>17/6</i>	
SENIOR GEOLOGIST:		
SURVEYOR:		

SCALE 1: 250

LOCATION BOLD HEAD MINE

SUBJECT R60 STOPE 3<sup>RD</sup> LIFT SLOT THROUGH PILLAR

north



GRASSY KING ISLAND

PLAN NUMBER 03BH04 2001