



0374 - 396

04DM15 - 1011

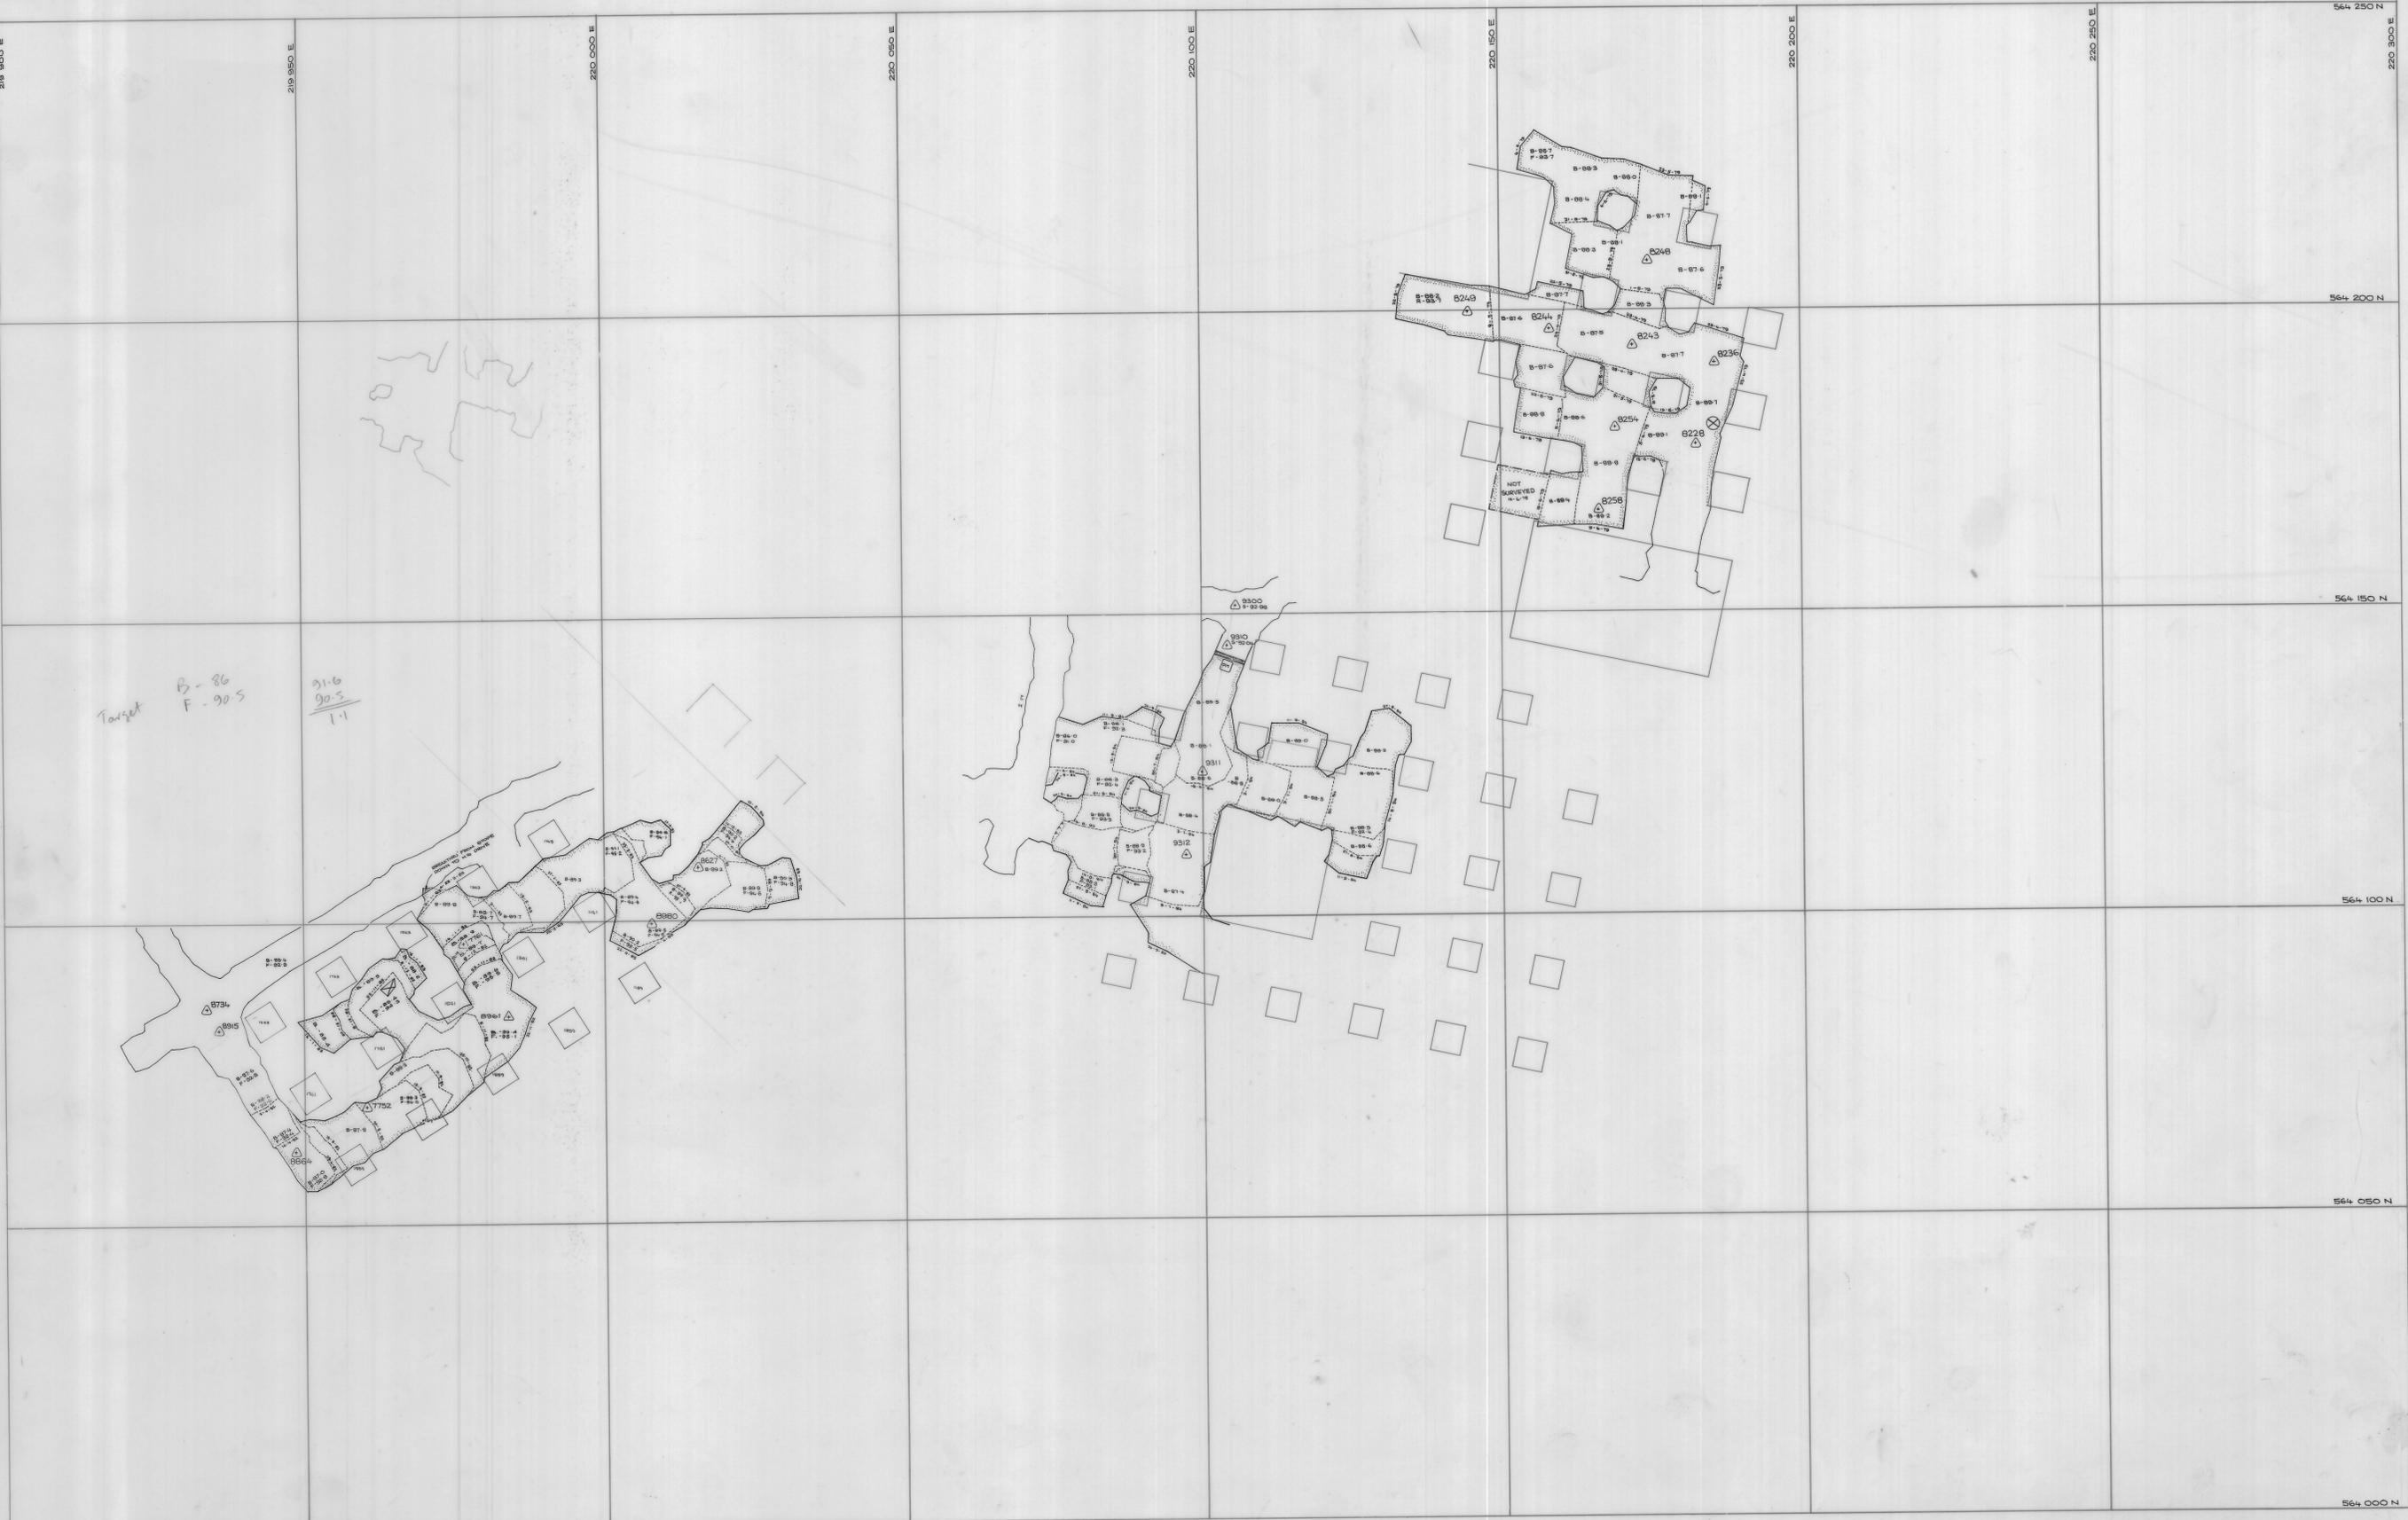

Target
 B-86
 F-90S
 91.6
 90.5
 1.1

SCALE 1:500

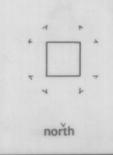

LOCATION DOLPHIN MINE
 SUBJECT
 C WEDGE STOPE - 92.0m Contour
 PIT STOPE - 93.0m Contour
 CENTRAL STOPE - 93.0m Contour

KIS KING ISLAND SCHEELITE
 A DIVISION OF WARMAN INTERNATIONAL
 GRASSY KING ISLAND
 PLAN NUMBER 04DM15 - 1011