


0374 - 397

04DM15 - 1012

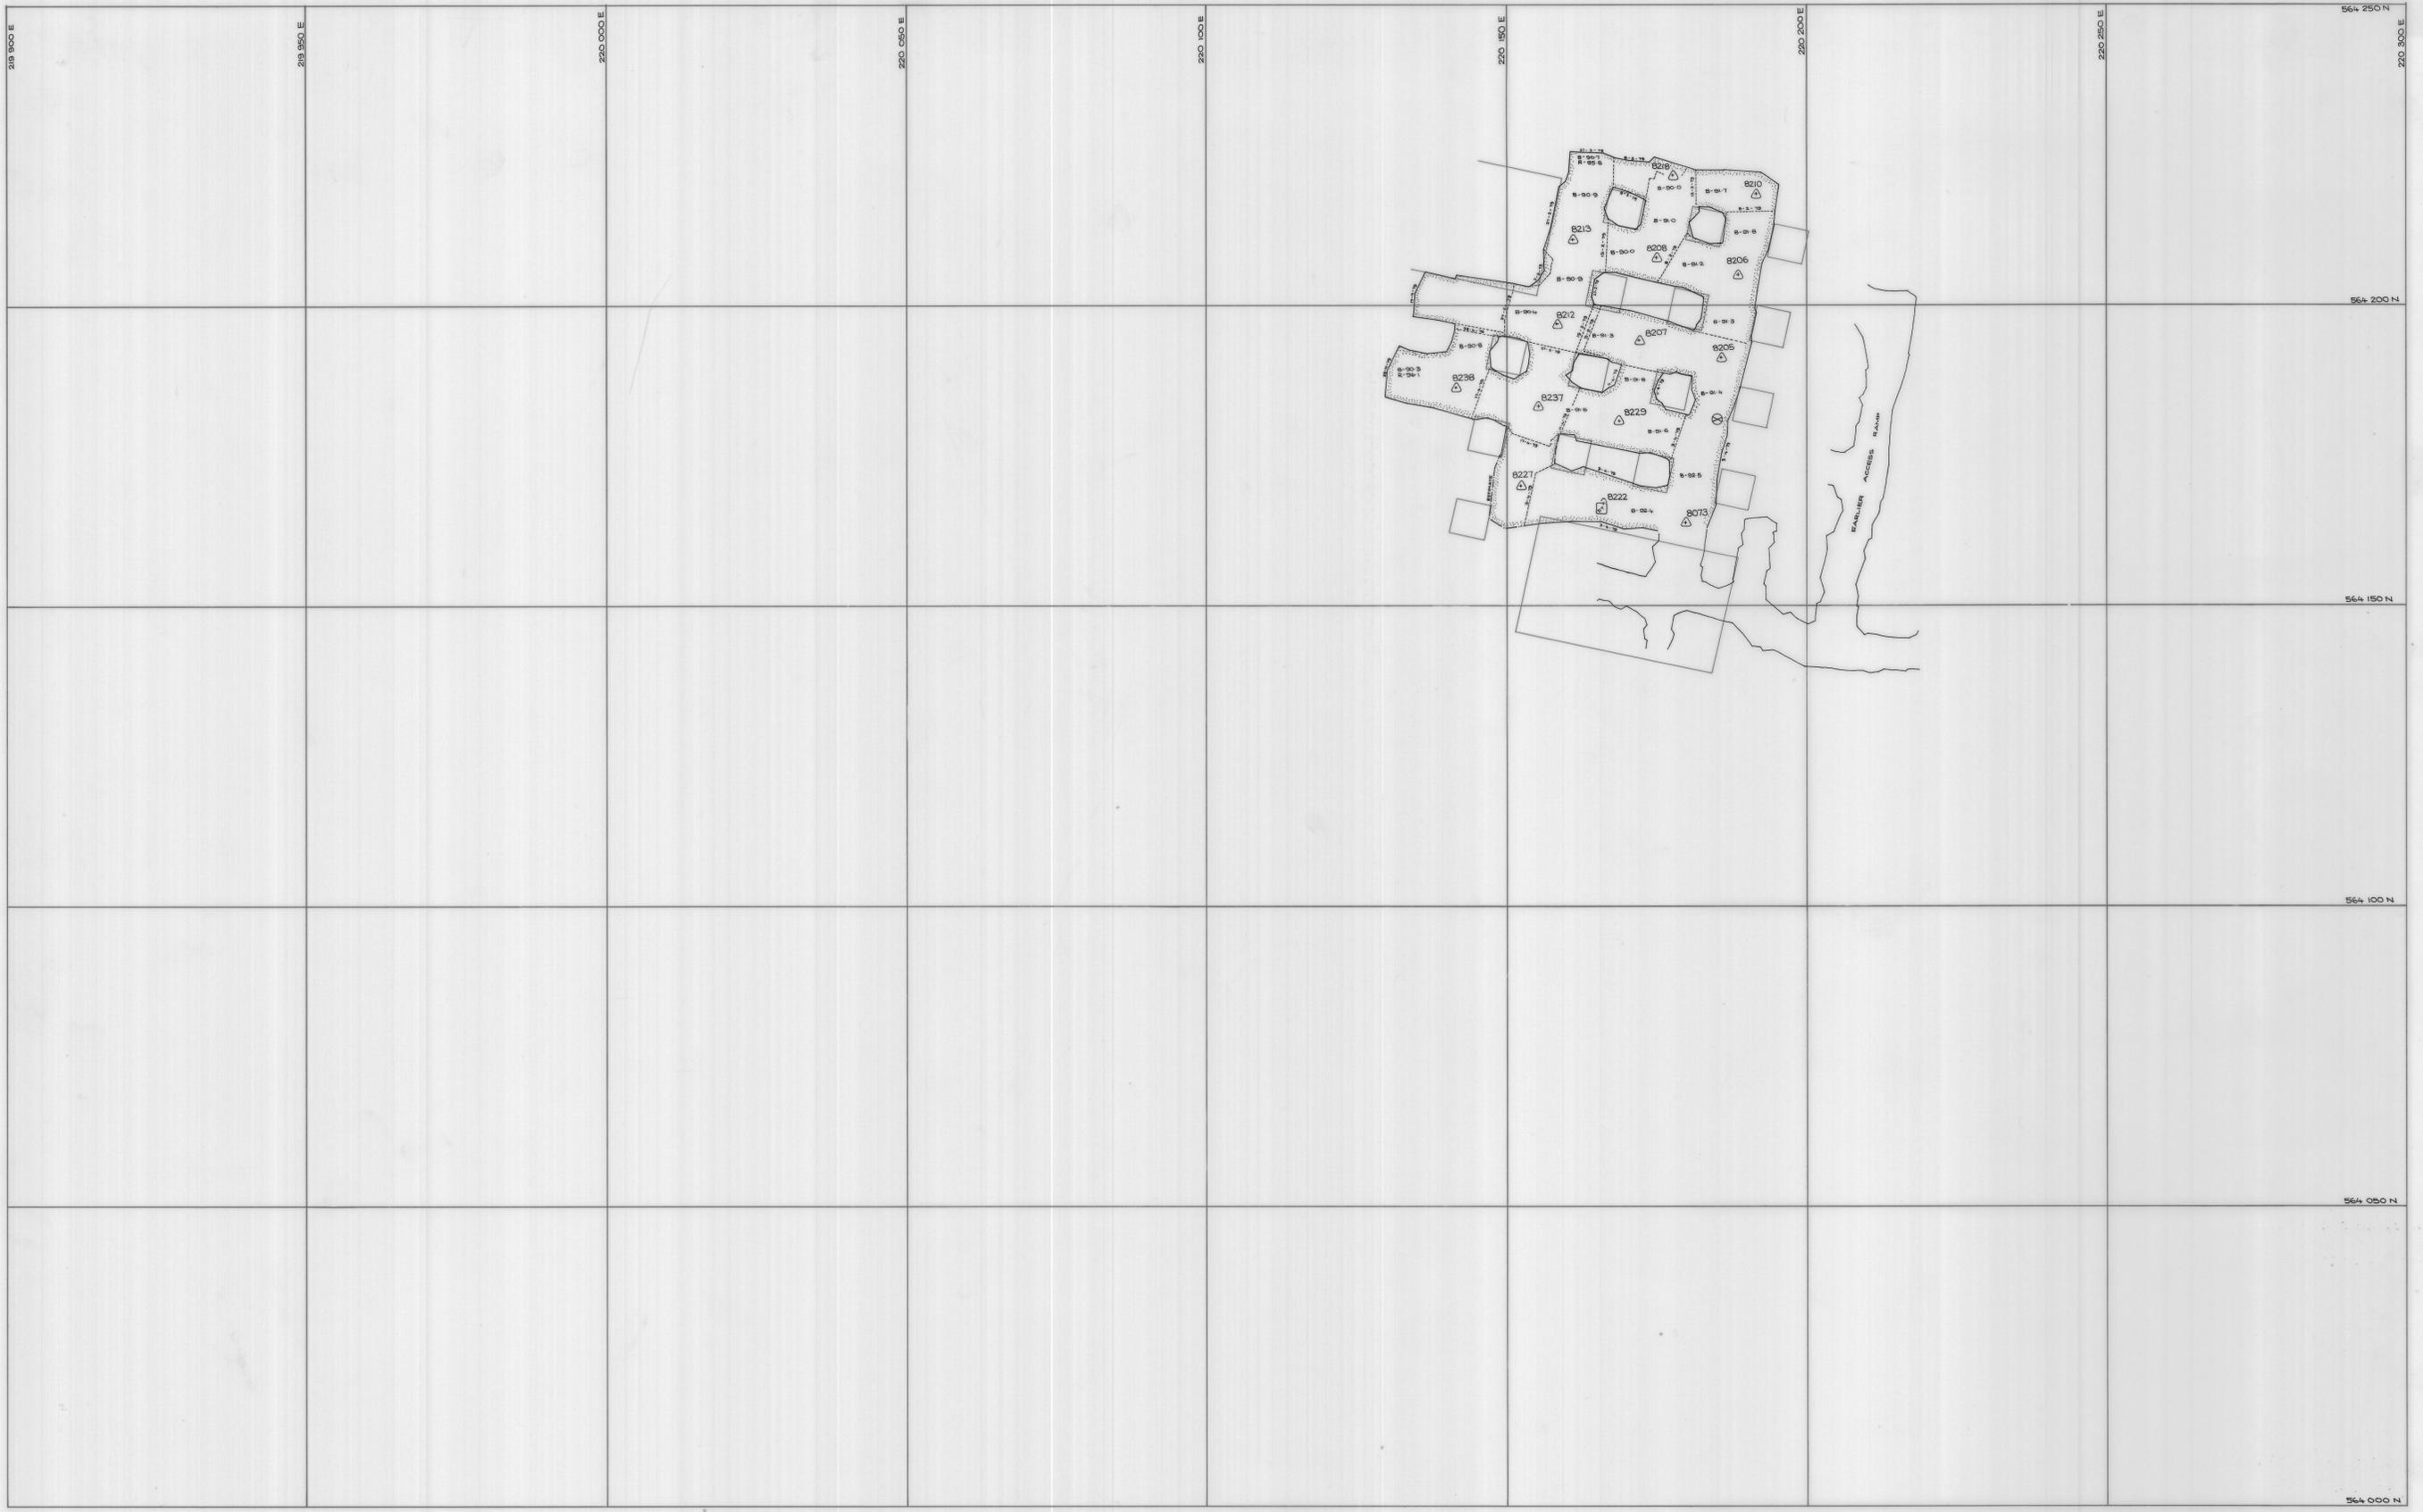

	SCALE 1:500 		LOCATION DOLPHIN MINE SUBJECT C WEDGE STOPE - 95m CONTOUR	 A DIVISION OF BARMAN INTERNATIONAL GRASSY KING ISLAND PLAN NUMBER 04DM15 - 1012
--	--	---	--	--