


BOLD HEAD
B WEST
Sc/DR & Access Ex M52

1:250

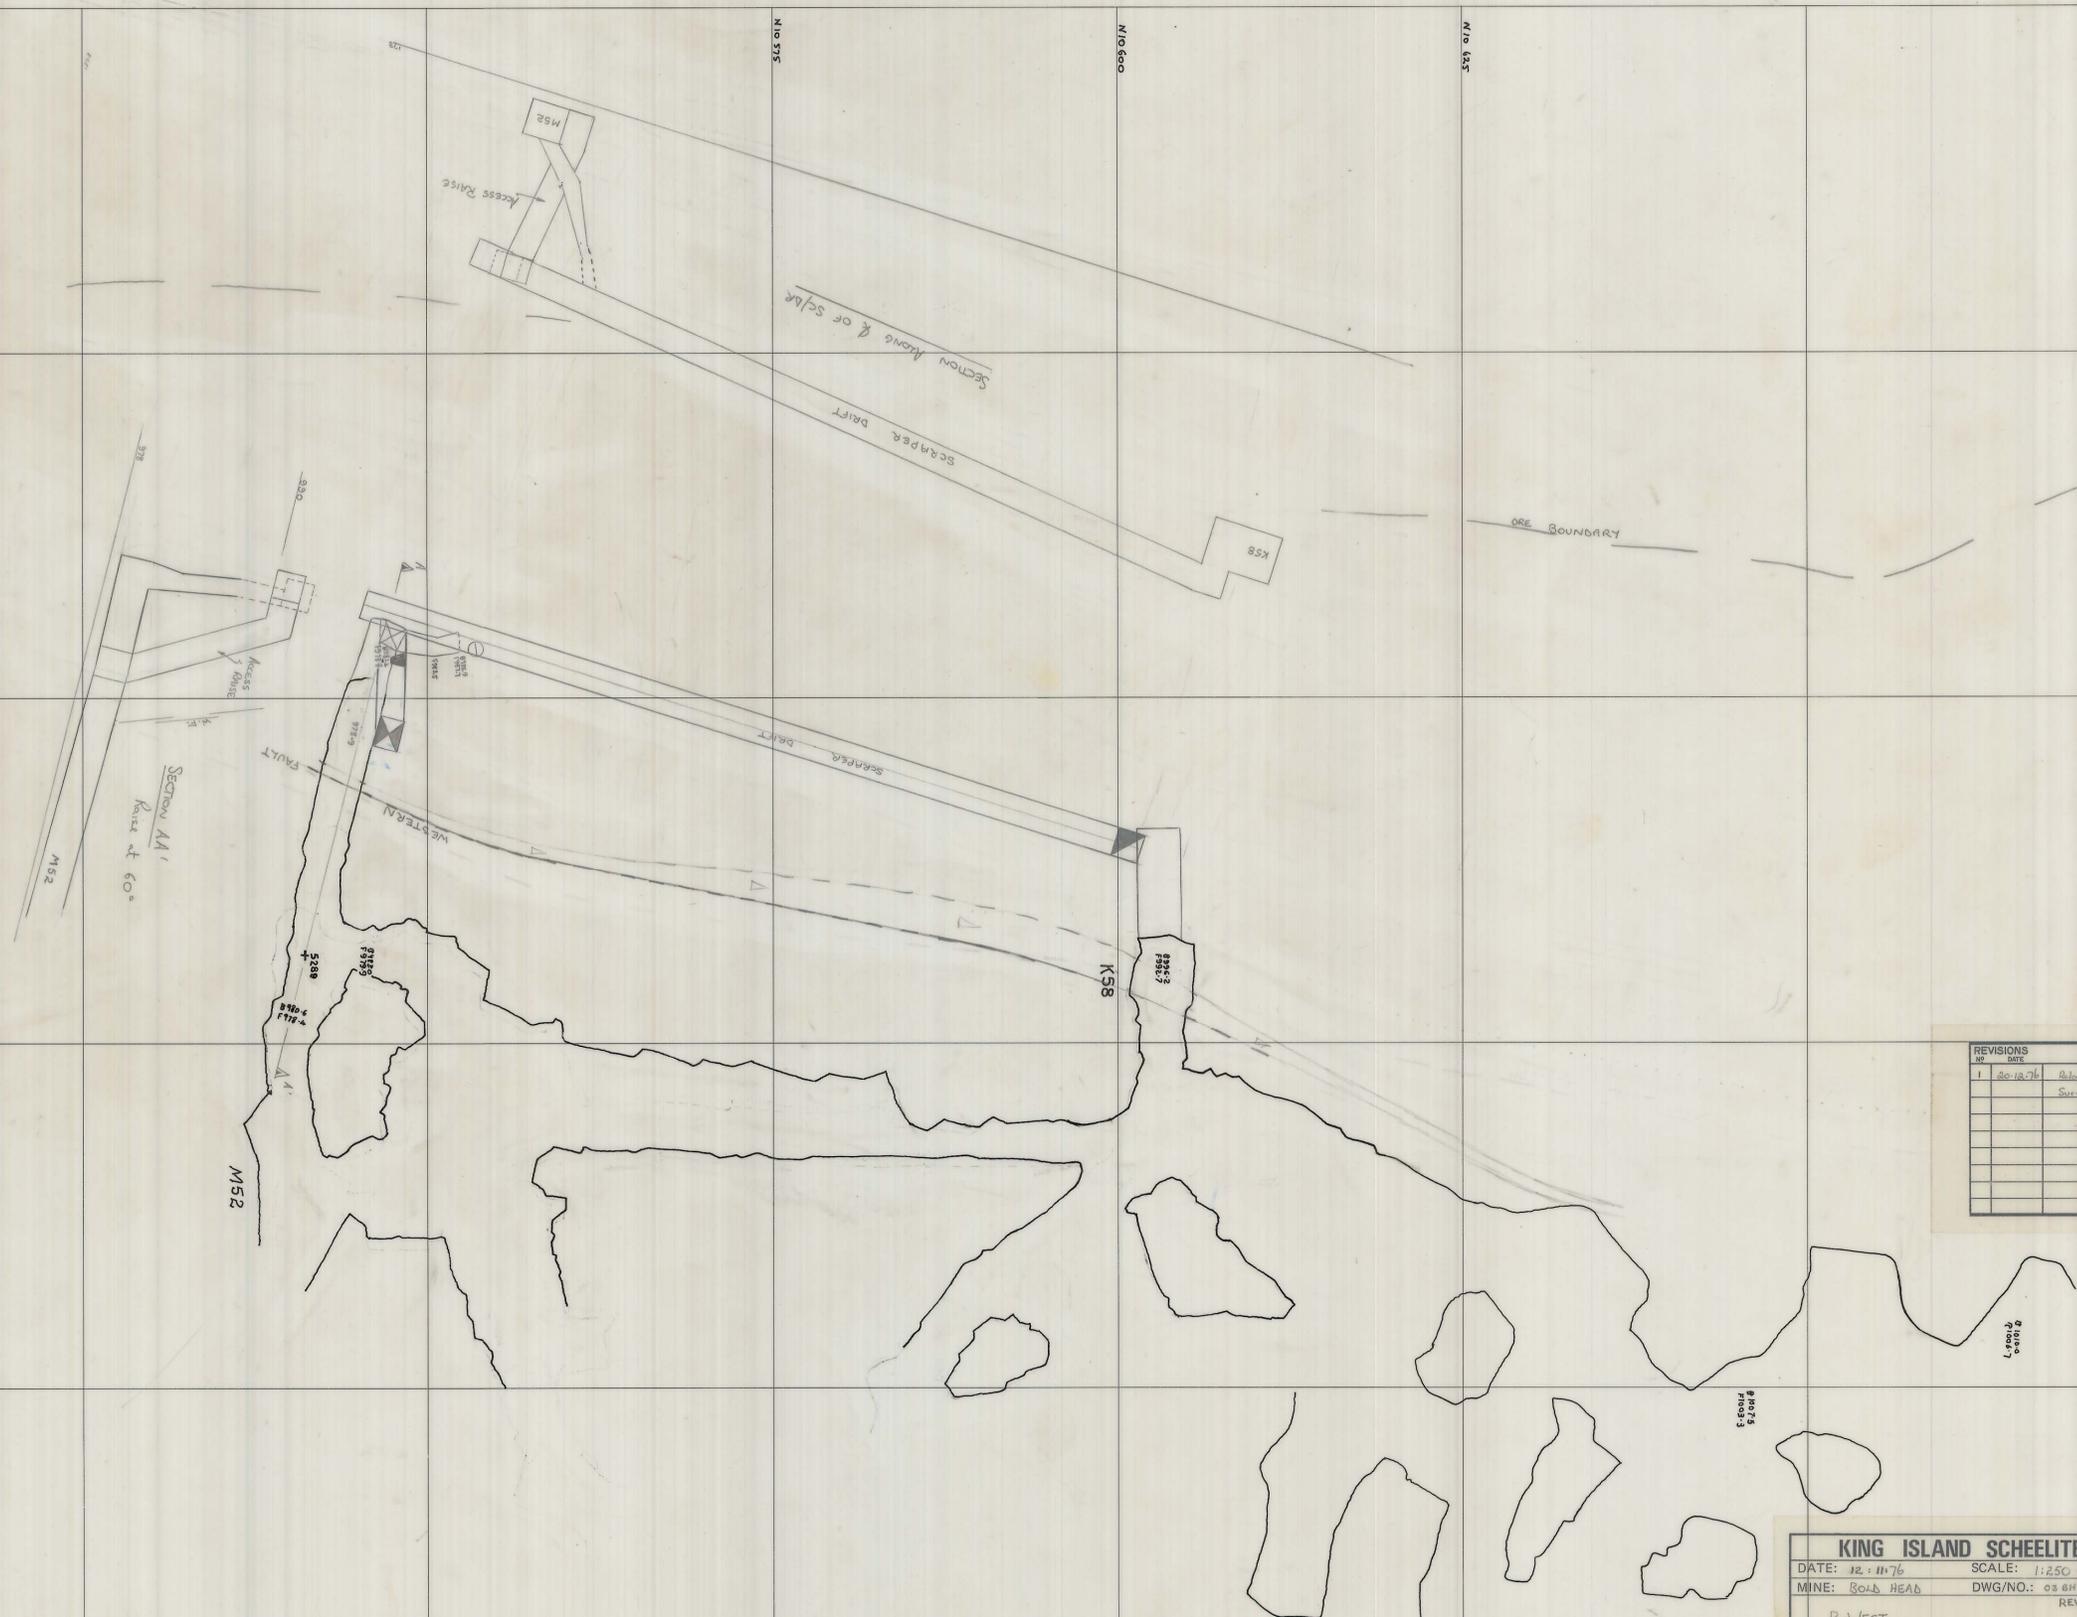

REV. NO.	DATE	DESCRIPTION	INITIALS
1	20-10-76	Relocation of Access Raize & Sc/DR, Correction of Surveying Error	ED

KING ISLAND SCHEELITE		APPROVAL	COPY
DATE: 12-11-76	SCALE: 1:250	PLANNING ENG.:	
MINE: BOLD HEAD	DWG/NO.: 038407-1015	SENIOR PLAN. ENG.:	
B WEST	REV: I	MINE SUPT.:	
Sc/DR & Access Ex M52		G. MINING SUPT.:	
		SENIOR SURV'R.:	
		SENIOR GEOLOGIST:	
		SURVEYOR:	
PRELIMINARY	<input checked="" type="checkbox"/>	FINAL	<input type="checkbox"/>