


40 450 E

40 400 E

40 350 E

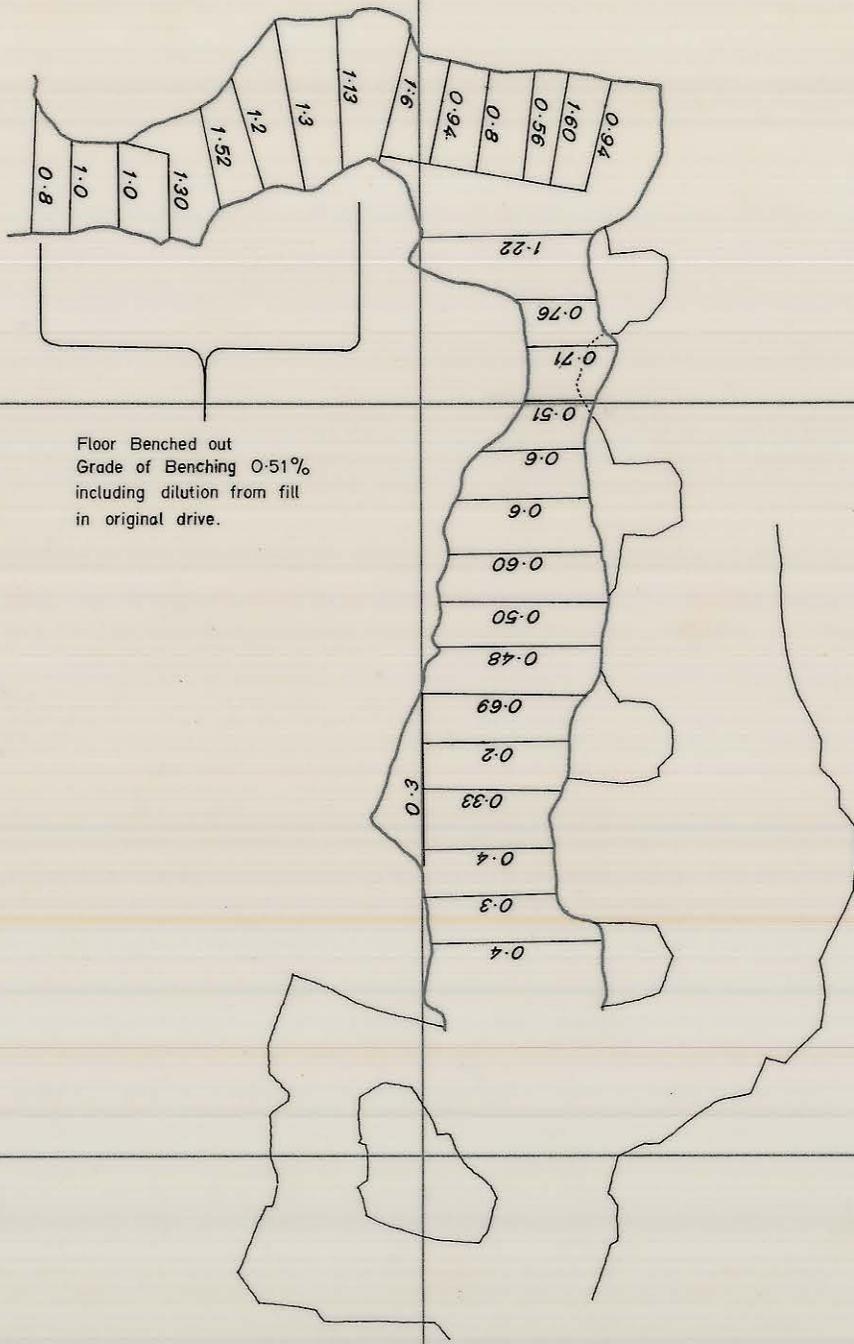

Floor Benched out
 Grade of Benching 0.51%
 including dilution from fill
 in original drive.

0374_4004

5 cm

REF PLAN 1-30 Assay Results 0-7 Lamp Estimate	GEOLOGY		1 : 500 SCALE	 KING ISLAND SCHEELITE GRASSY KING ISLAND
	SURVEY			
	PLANNING		BOLD HEAD MINE CI Lens Q 49 Grade Samples	
	ROCK.MEC.			
	GRADE CON.		DRAWING NUMBER	
	DRAFTING	<i>C.W.</i>		
	T.S.S.			