


03 BH07-3002

C<sub>1</sub> LENS - BOLD HEAD  
T47 STOPING PATTERN

0374\_4008

5 cm

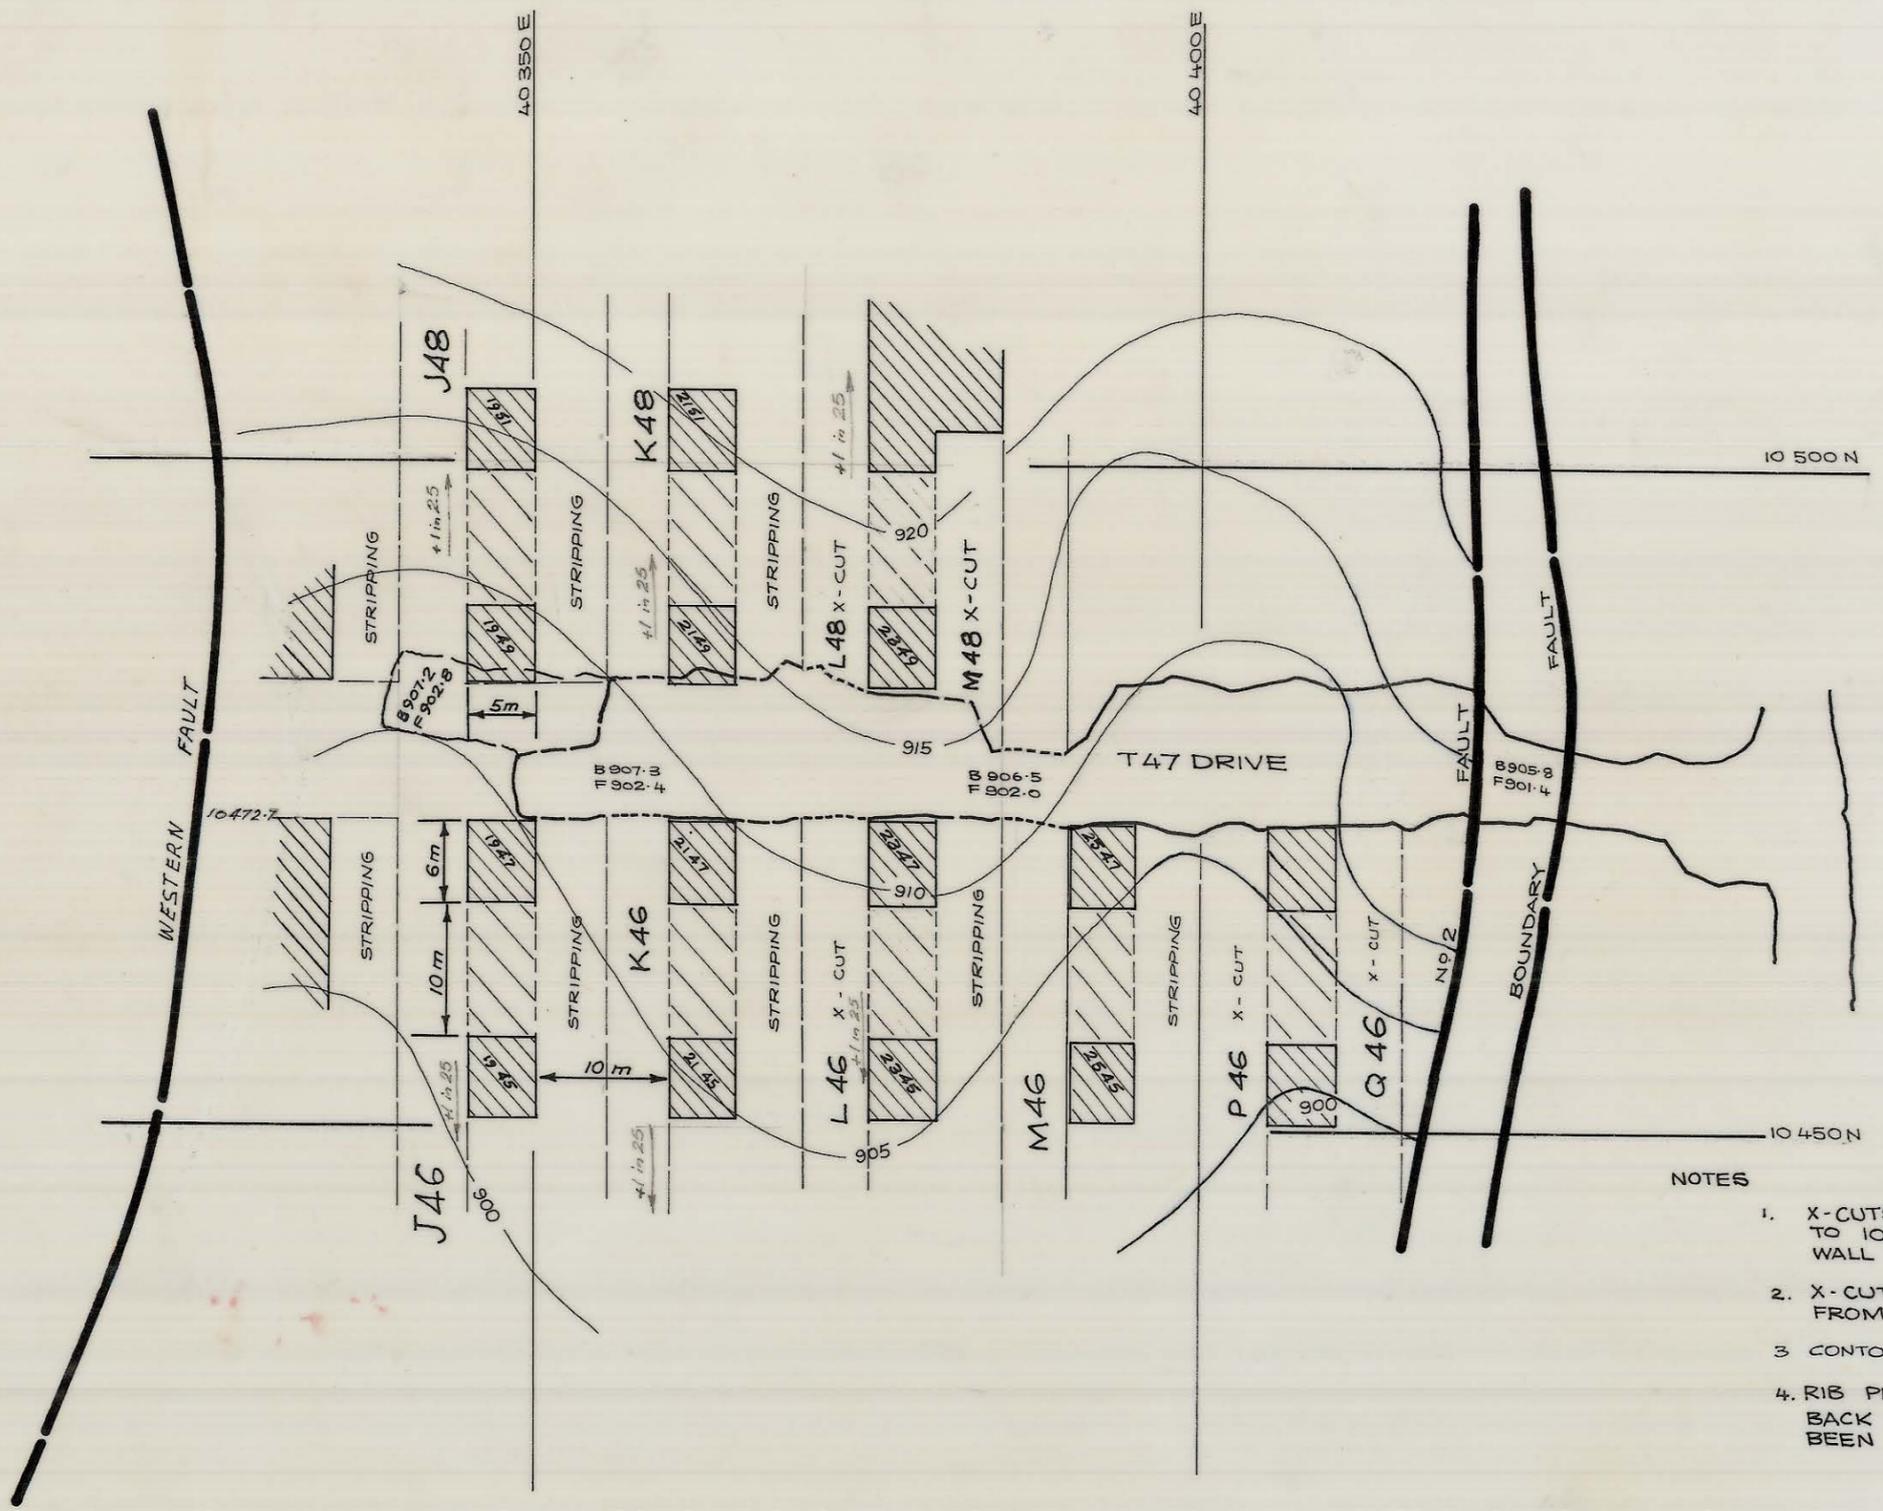

NOTES

1. X-CUTS TO BE DRIVEN 5m WIDE & STRIPPED TO 10m. AS SHOWN AFTER REACHING HANGING WALL OR FOOTWALL
2. X-CUTS TO HAVE GRADIENT 1 IN 25 UP AWAY FROM T47
3. CONTOURS REPRESENT TOP OF PSH (min).
4. RIB PILLARS MAY BE 'ROBBED' AS SHOWN AFTER BACK CONDITIONS IN STRIPPED X-CUTS HAVE BEEN DETERMINED.

LEGEND	REVISIONS		DESCRIPTION	INITIALS
	NO	DATE		
	1	11/7/80	Xcut numbers, Pillar numbers, and Wend T47 added	W.S.

*mining should be considered east of 10350E south of T47.*

*OK W.S. Crowley*



GEOEKO LIMITED  
KING ISLAND

Scale: \_\_\_\_\_ No K

BOLD HEAD MINE  
C1 LENS  
T47 STOPING PATTERN.

DATE: 23/11/80  
GEOLOGIST:  
DWN:  
CHKD: [Signature] drawing # 04BH07-3002

27 JUN 1981