


0374 4013

03 BH 07-3011

5 cm

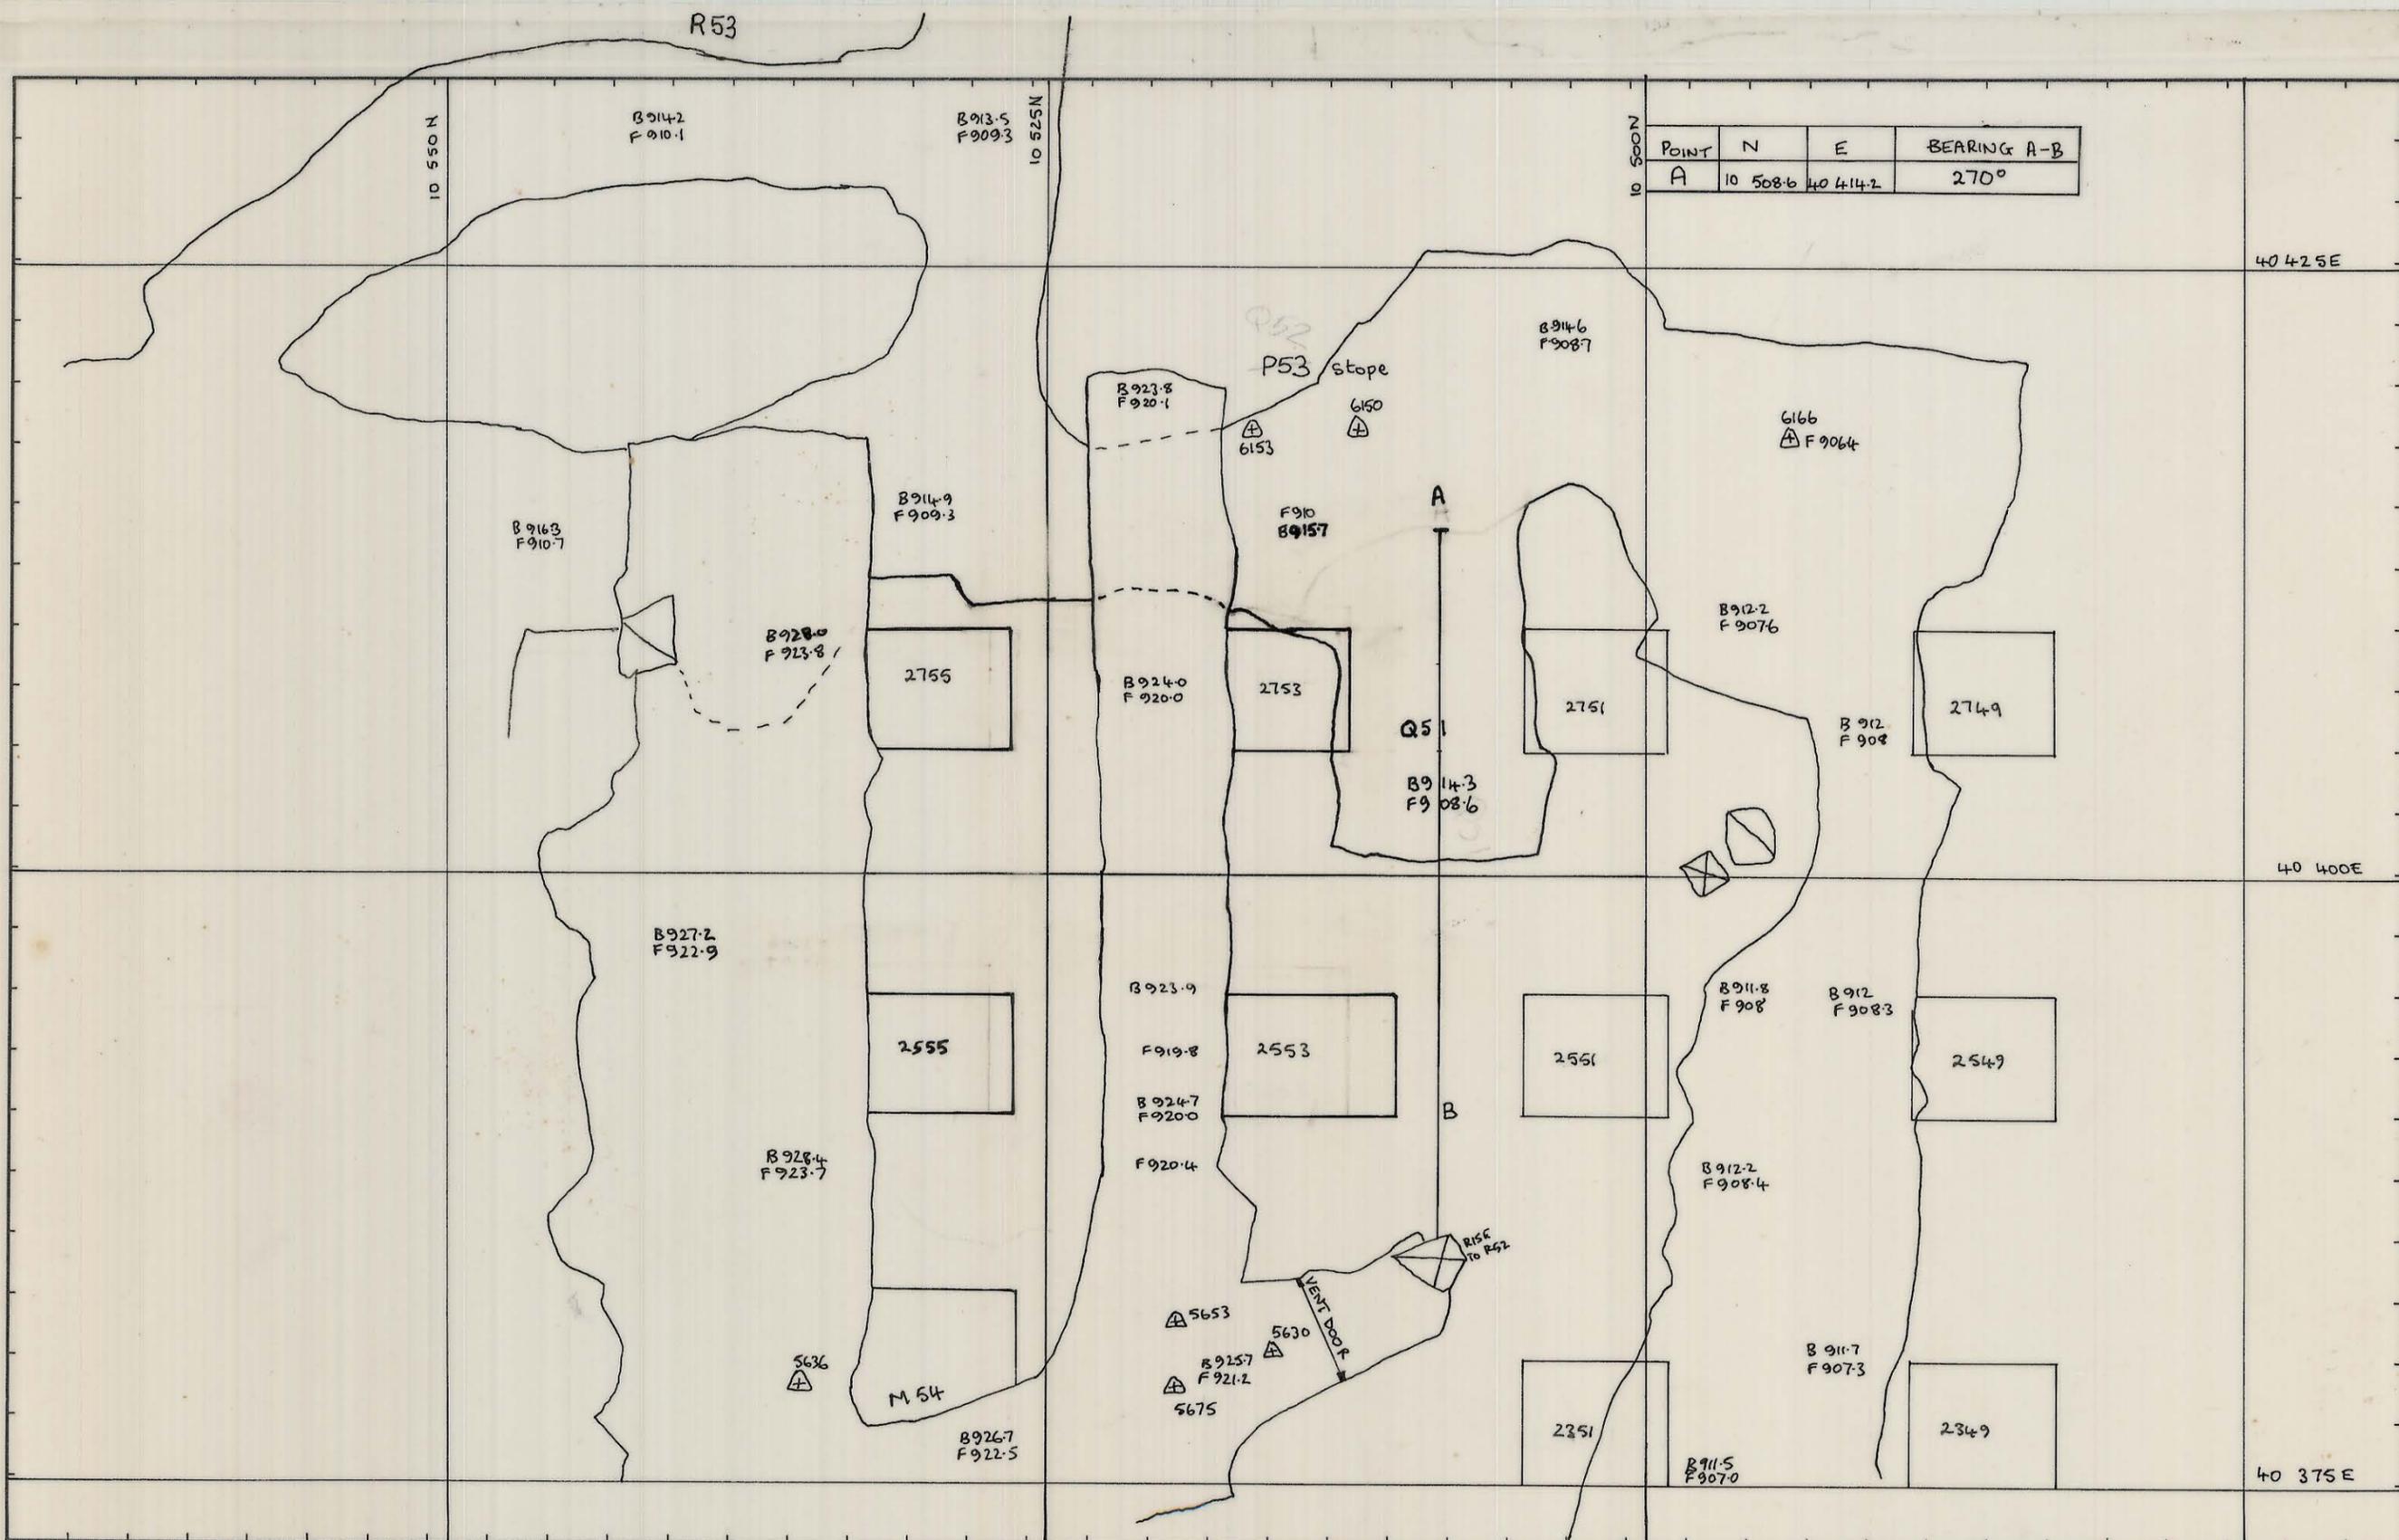

REF PLAN	04 BH 13-156 236 S	GEOLOGY	<i>Small</i> 5-1-82	SCALE 1:250	KIS KING ISLAND SCHEELITE GRASSY KING ISLAND
	04 BH 13-156 224				
		SURVEY	<i>BAL</i> 10/1/82	PILLAR POSITIONS C1 OREBODY	
		PLANNING	<i>ADJ</i> 5-1-82		
		ROCK MEC.	<i>JK</i> 5.1.82	BOLD HEAD MINE.	
		M Supt			
		GMS		DRAWING NUMBER	
		T.S.S.	<i>JK</i> 22/3/82		