


5 cm

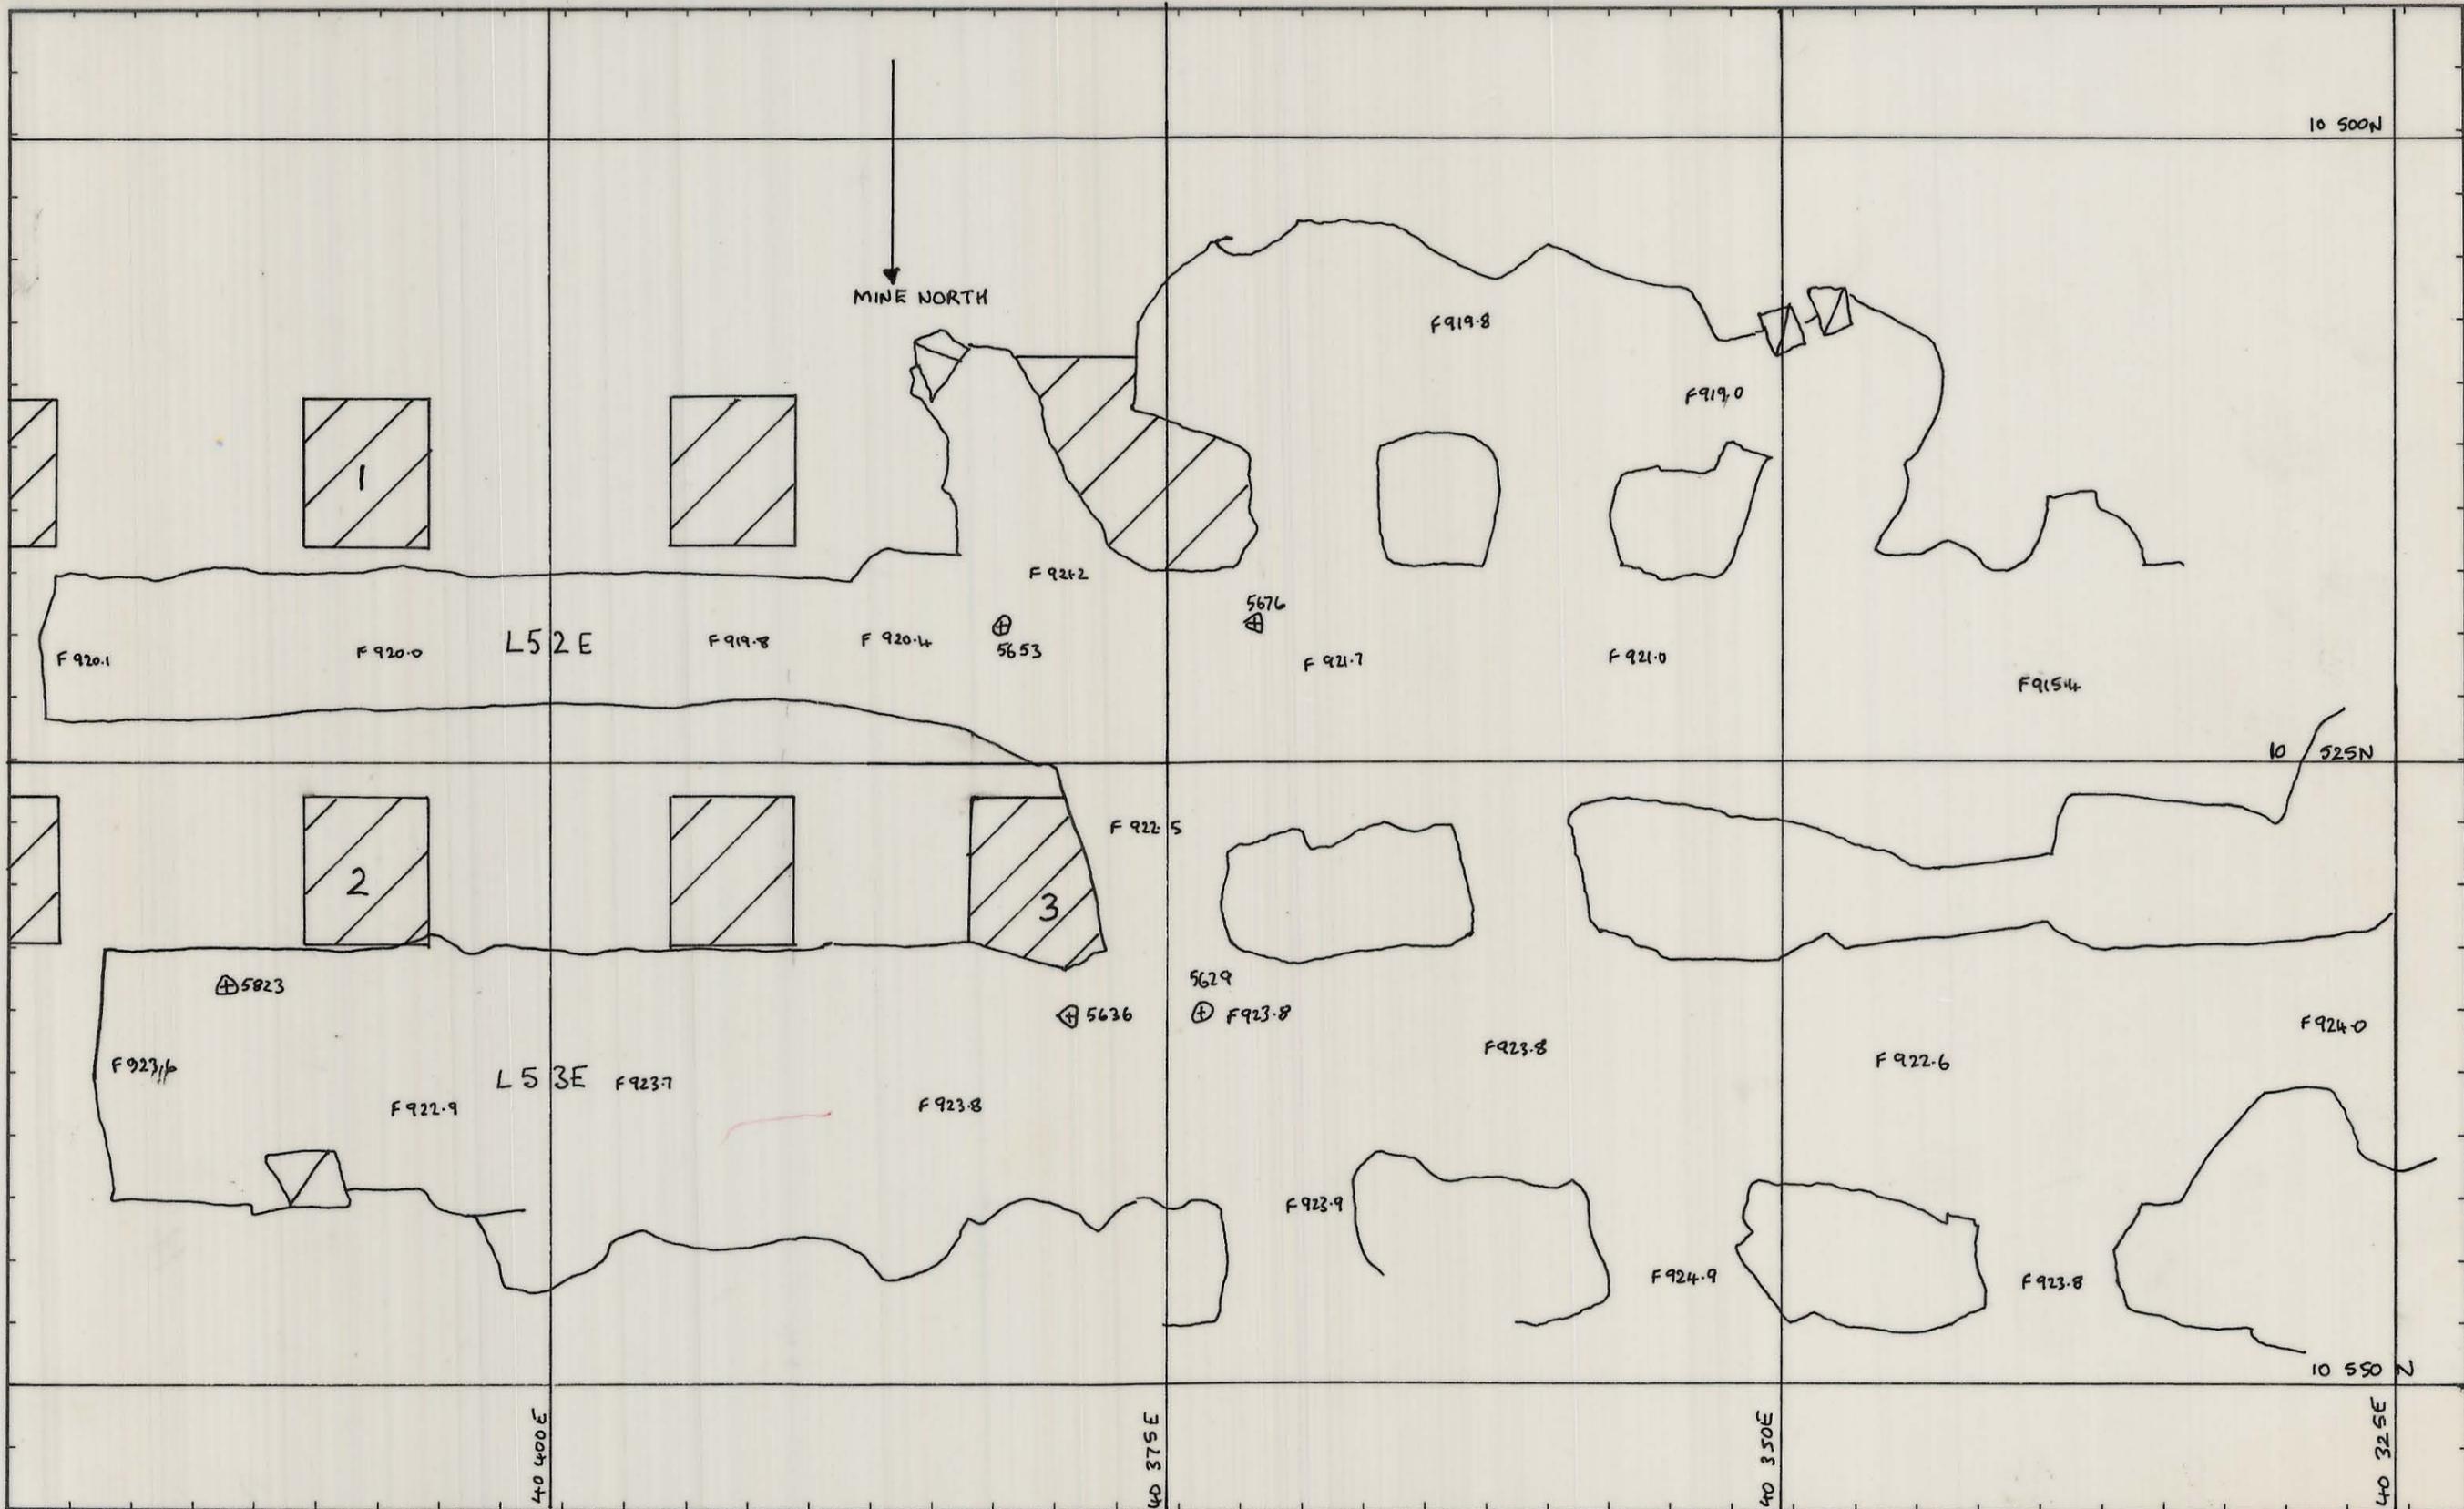

REF PLAN	04 BK 13 - 155224, 156224
----------	---------------------------

GEOLOGY	<i>ADJ</i>	16/2/82
SURVEY	<i>ADJ</i>	16-2-82
PLANNING	<i>ADJ</i>	16-2-82
ROCK MEC.	<i>ADJ</i>	16.2.82.
M Sup	<i>Matho</i>	16.2.82
GMS	<i>ADJ</i>	16/2/82
T.S.S.	<i>ADJ</i>	16-2-82

SCALE	1:250
BOLD HEAD PILLAR PATTERN L52, L53	
DRAWING NUMBER	03 BK07-30

