



0374_4020

5 cm

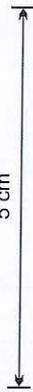

27 JUN 1981

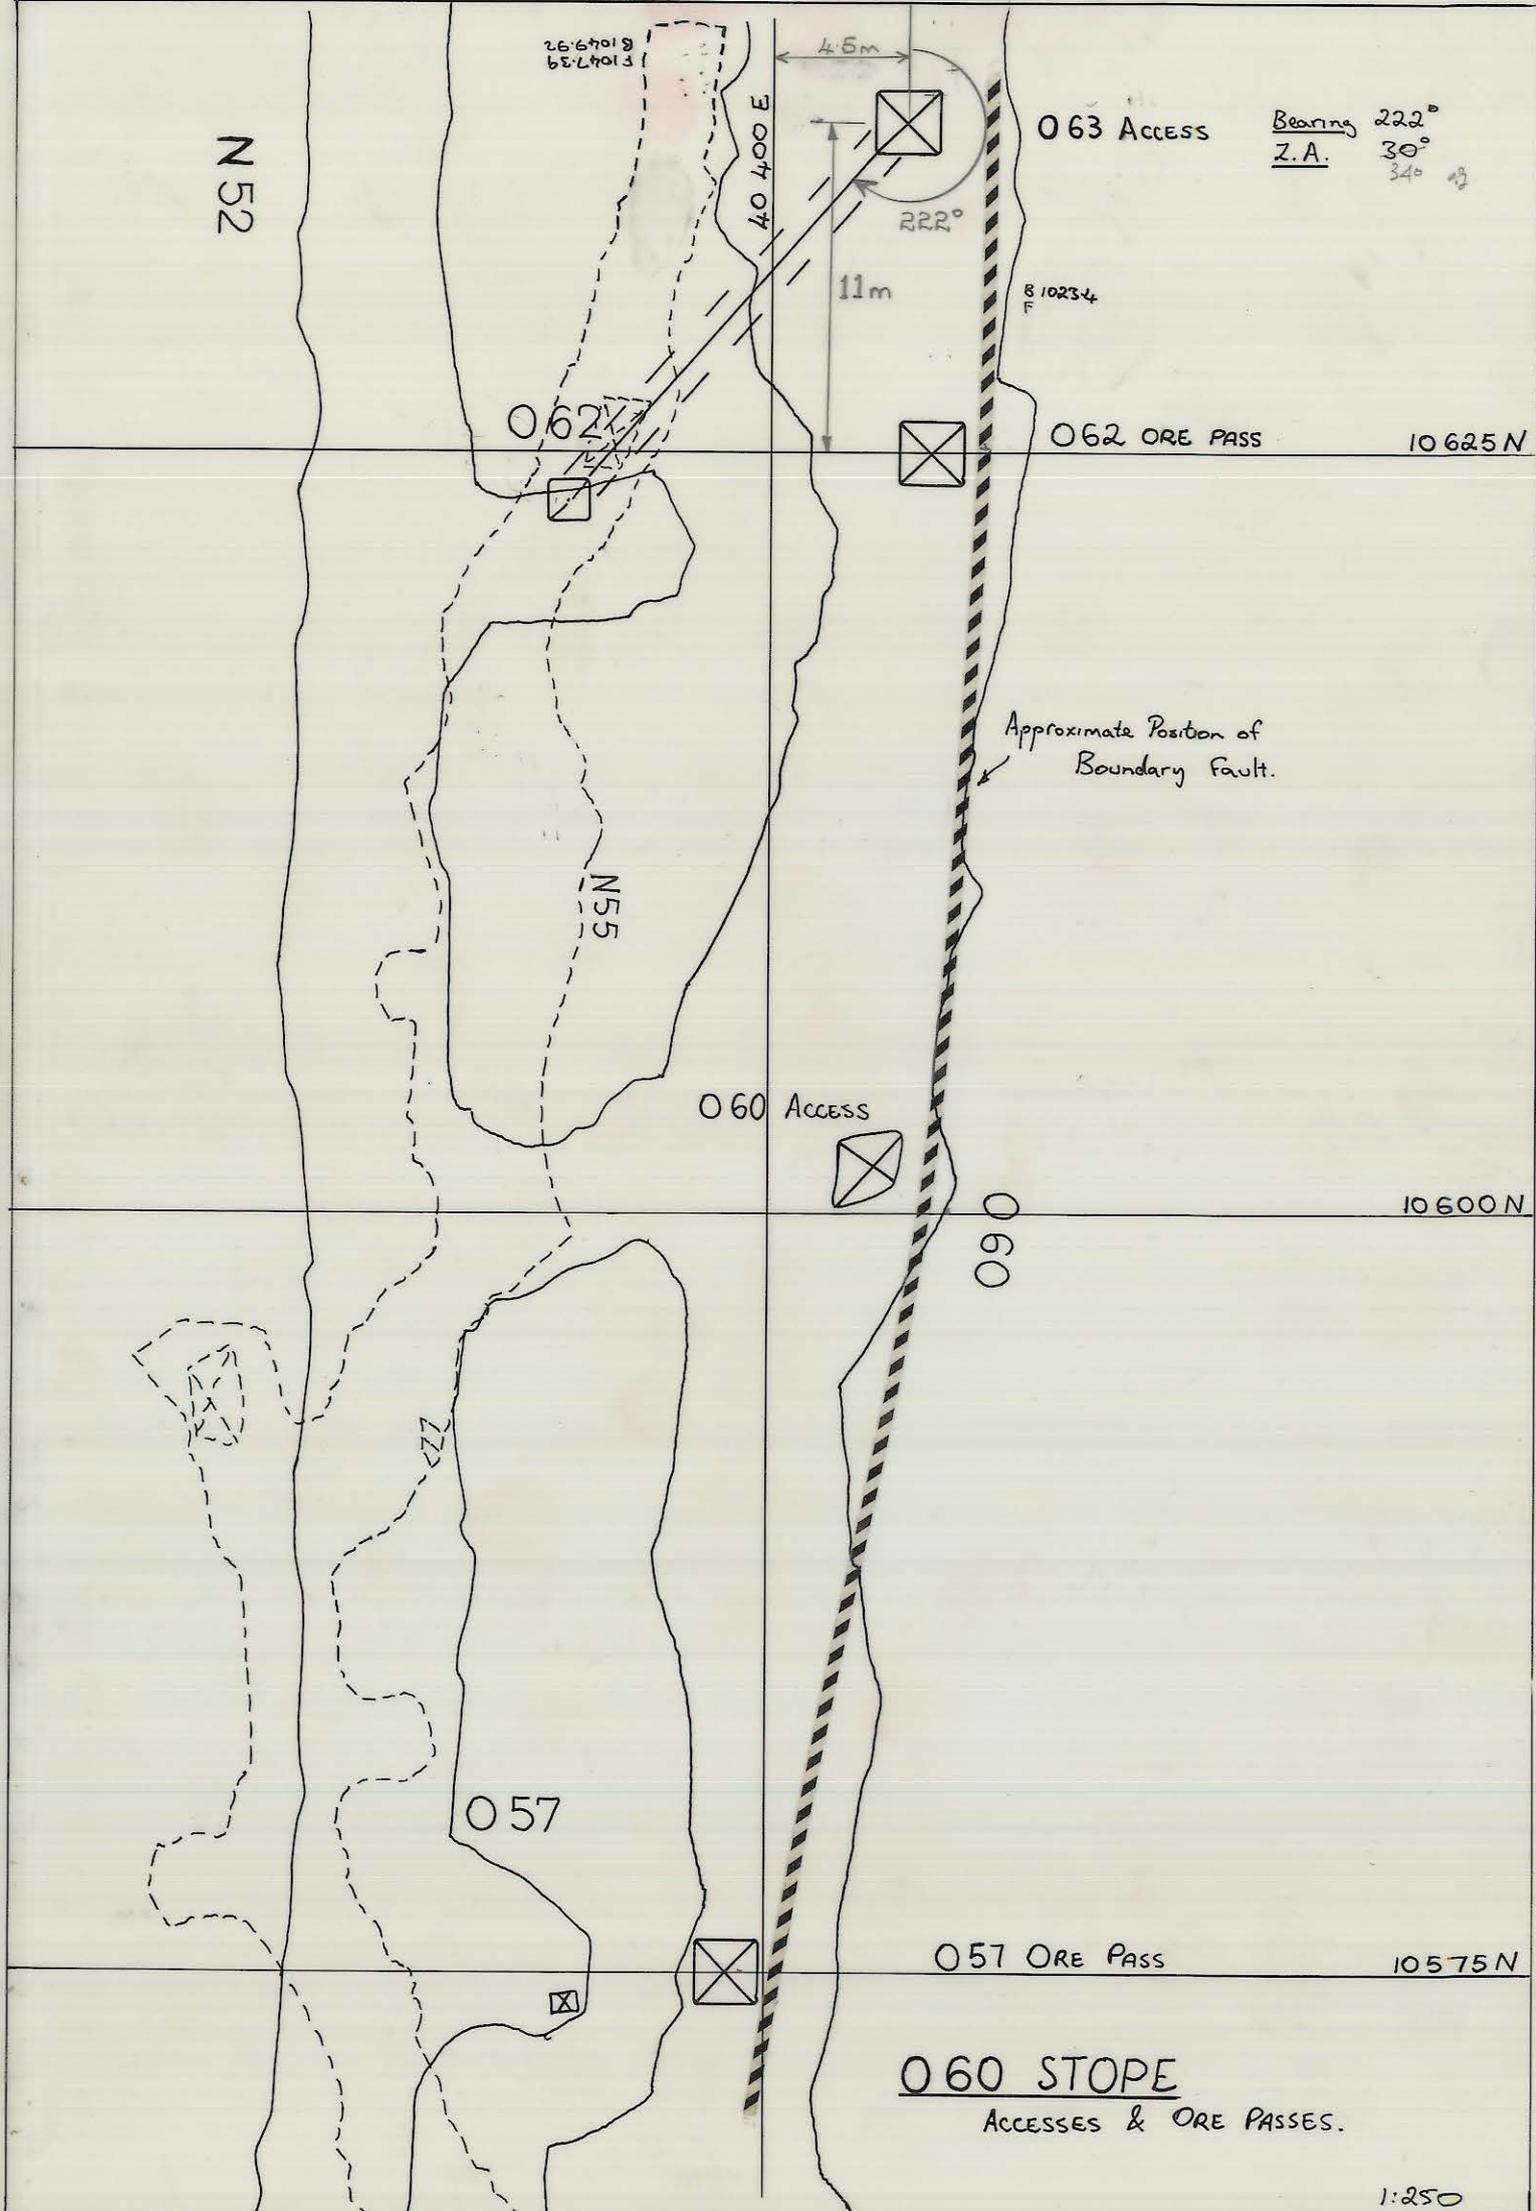

1:250