


0374_4024

5 cm

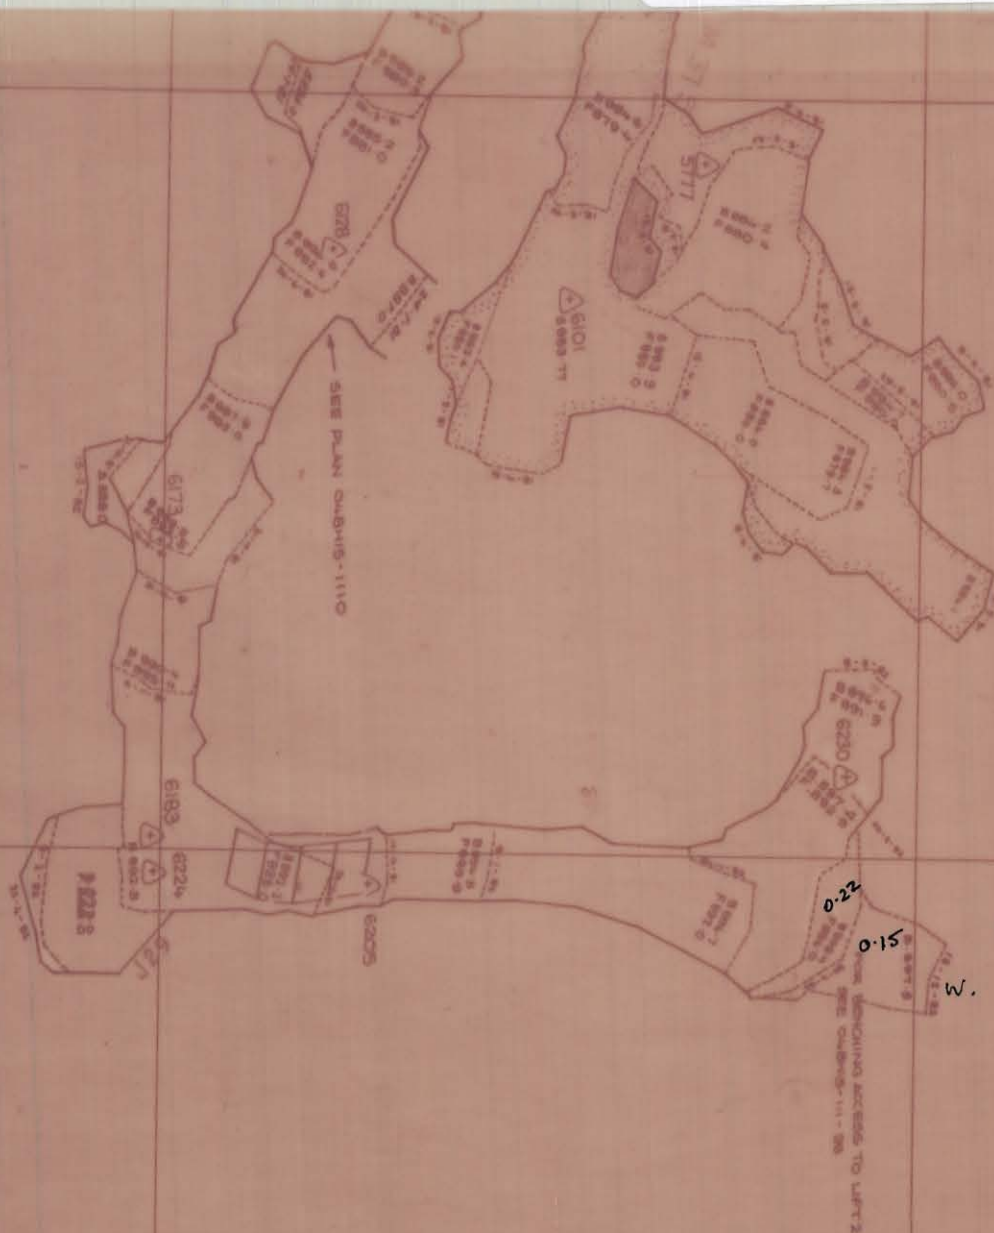

029. Development
Fault Block. South.

All left as waste.
(used as fill in M 37.).

W.