


H 50 LIFT 13
CLAB SAMPLES

0374_4046

5 cm

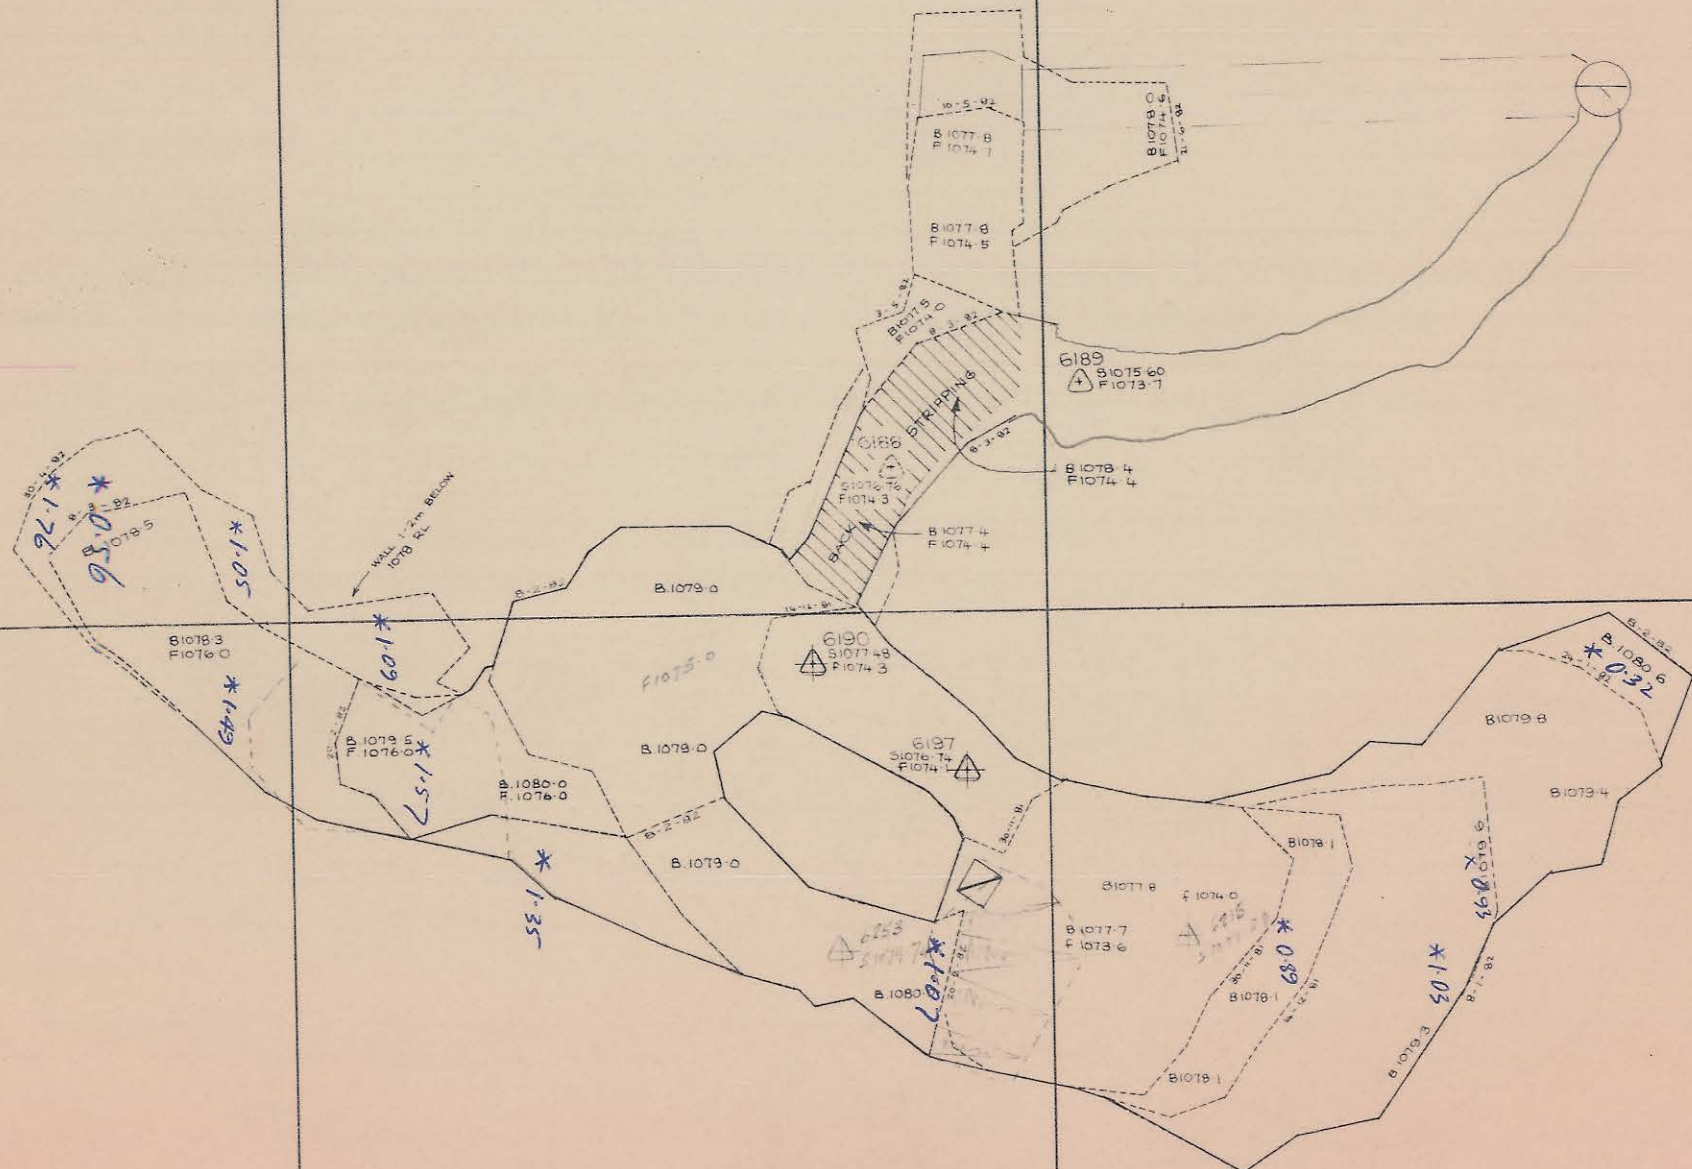

scale 1:250