



0374\_4050

5 cm

K44  
C. WEST  
STOPE  
2nd lift

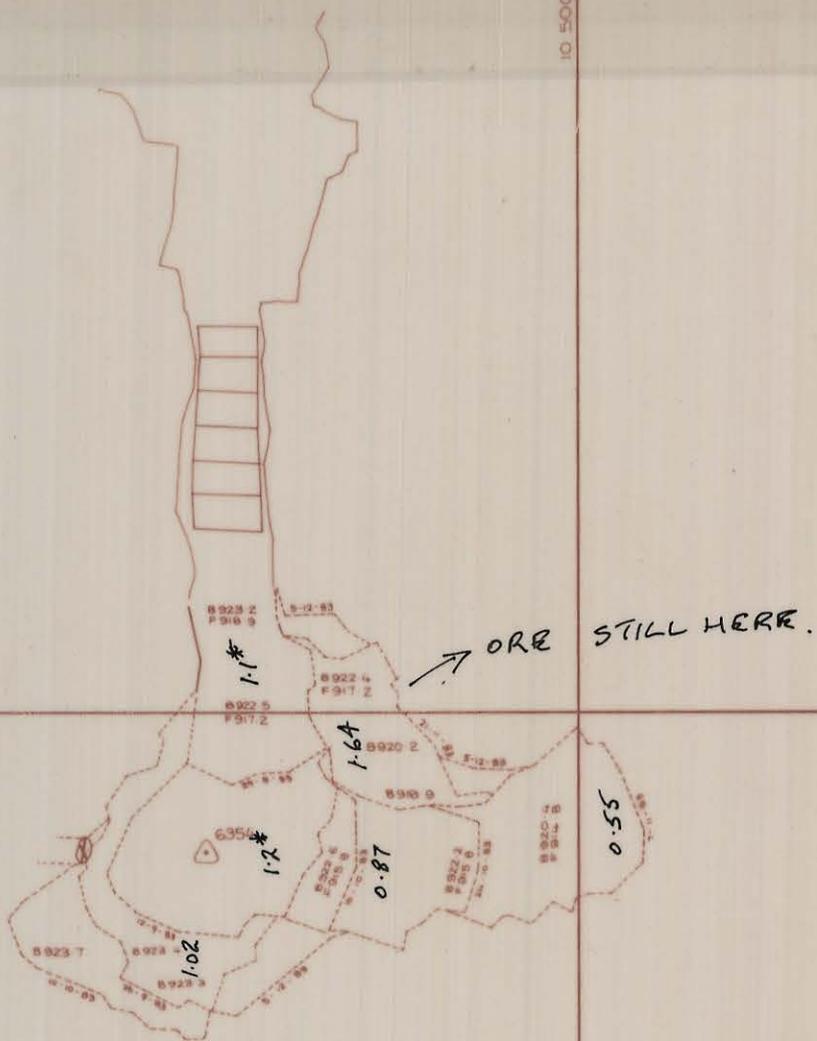

SCALE 1:500

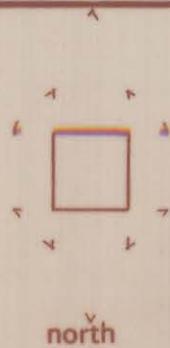

LOCATION

BOLD HEAD

SUBJECT

K44 S  
2nd lif