


038H07 4007

0374_4060

5 cm

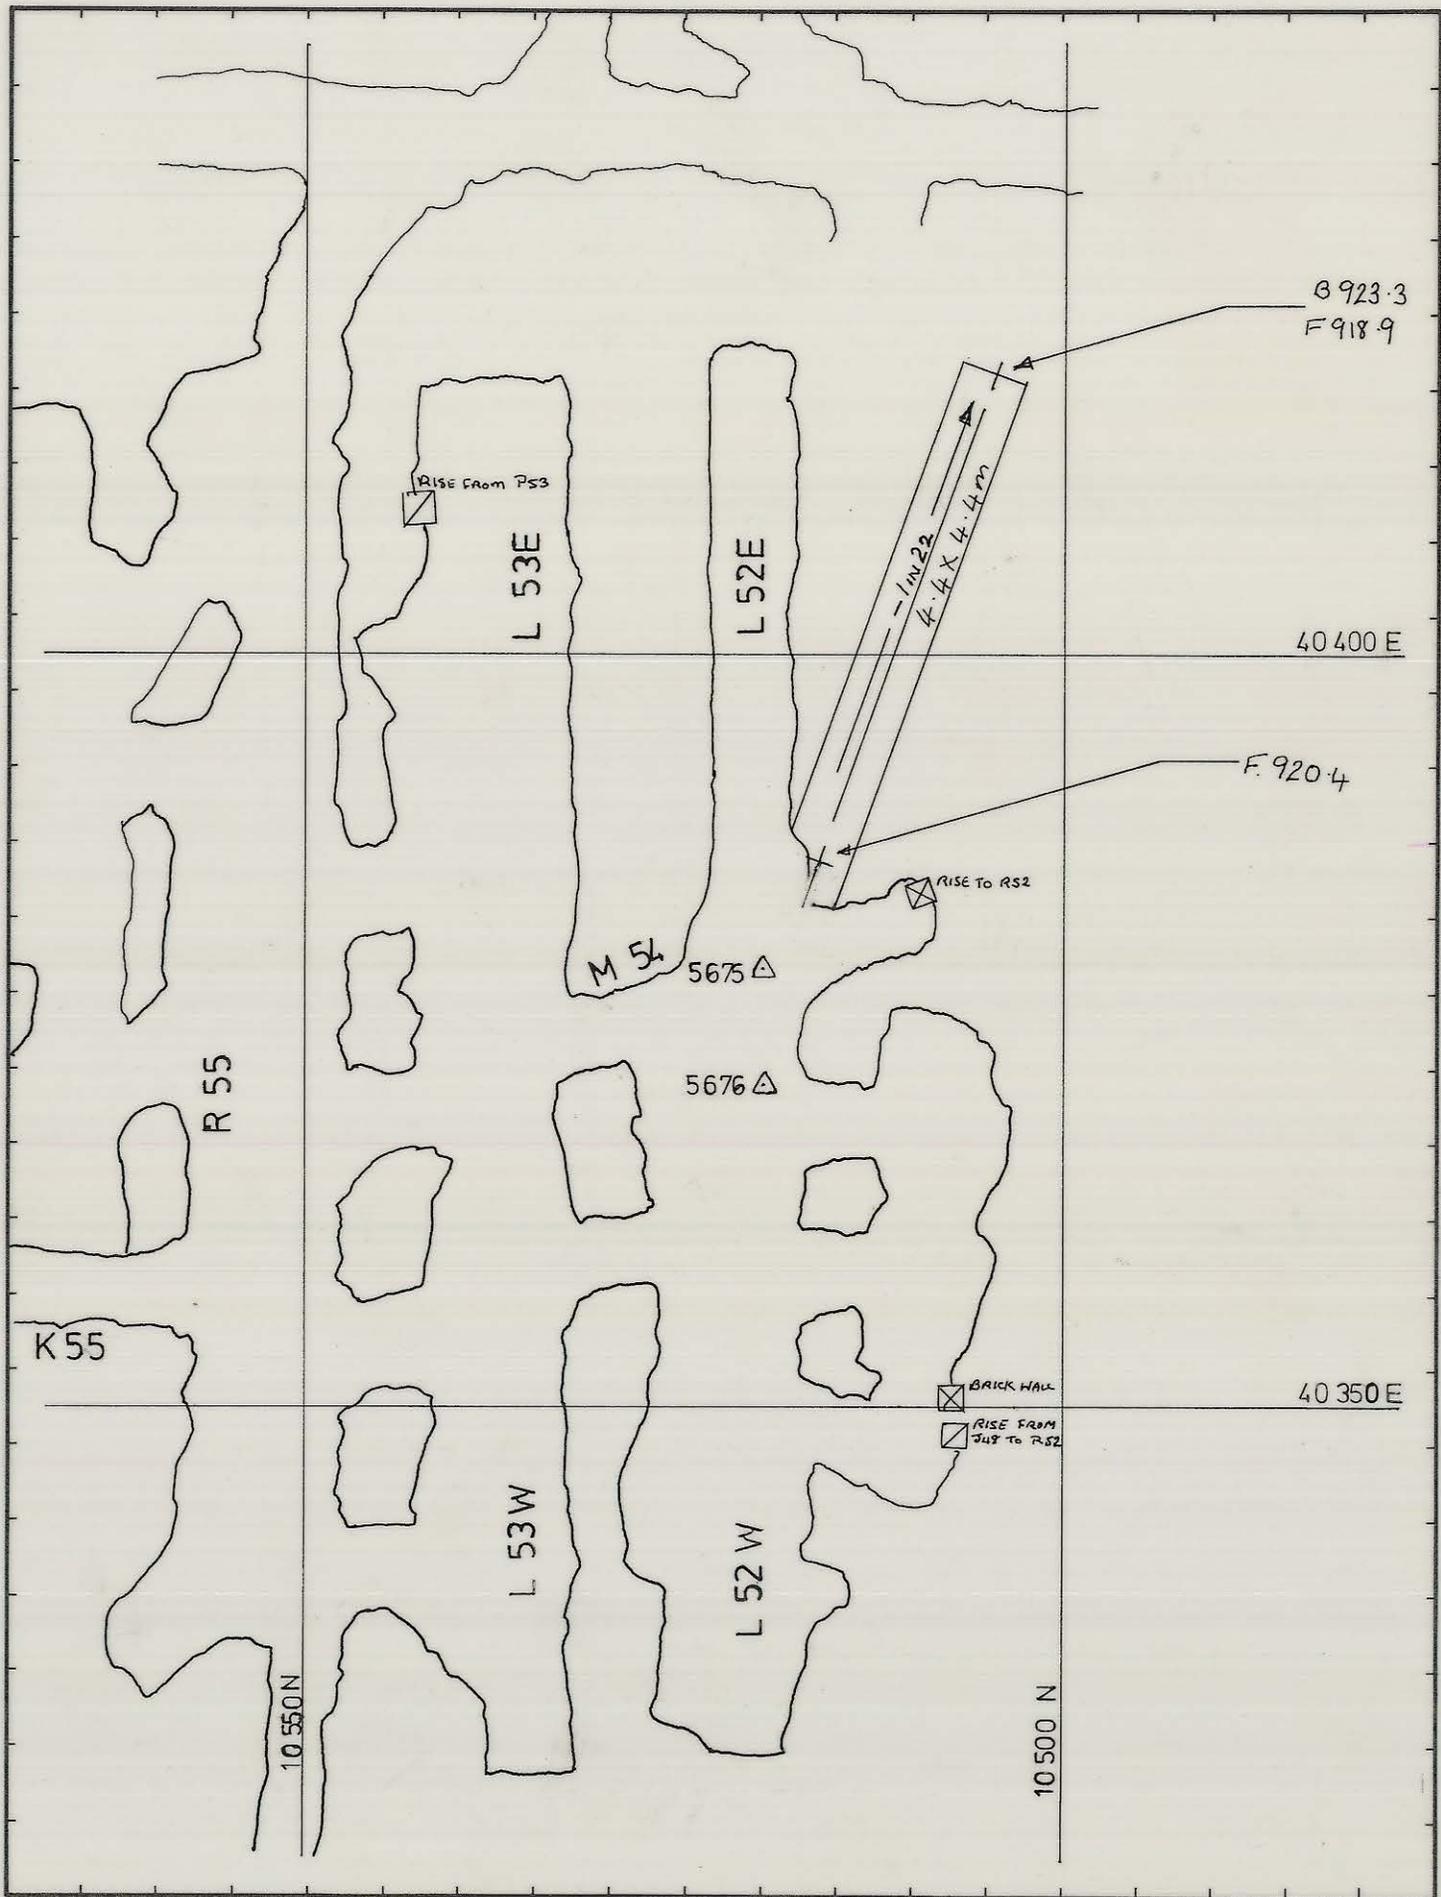

REF. PLAN OBH14 - 1013-1014

GEOLOGY

SURVEY

PLANNING

ROCK.MEC.

GRADE CON.

DRAFTING

T.S.S.

1:500
SCALE



KING ISLAND SCHEELITE
GRASSY KING ISLAND

C1 LENS, 5TH LIFT.

918.9 - 923.3.m.R.L.

DRAWING NUMBER