


038407 4008

0374_4061

5 cm

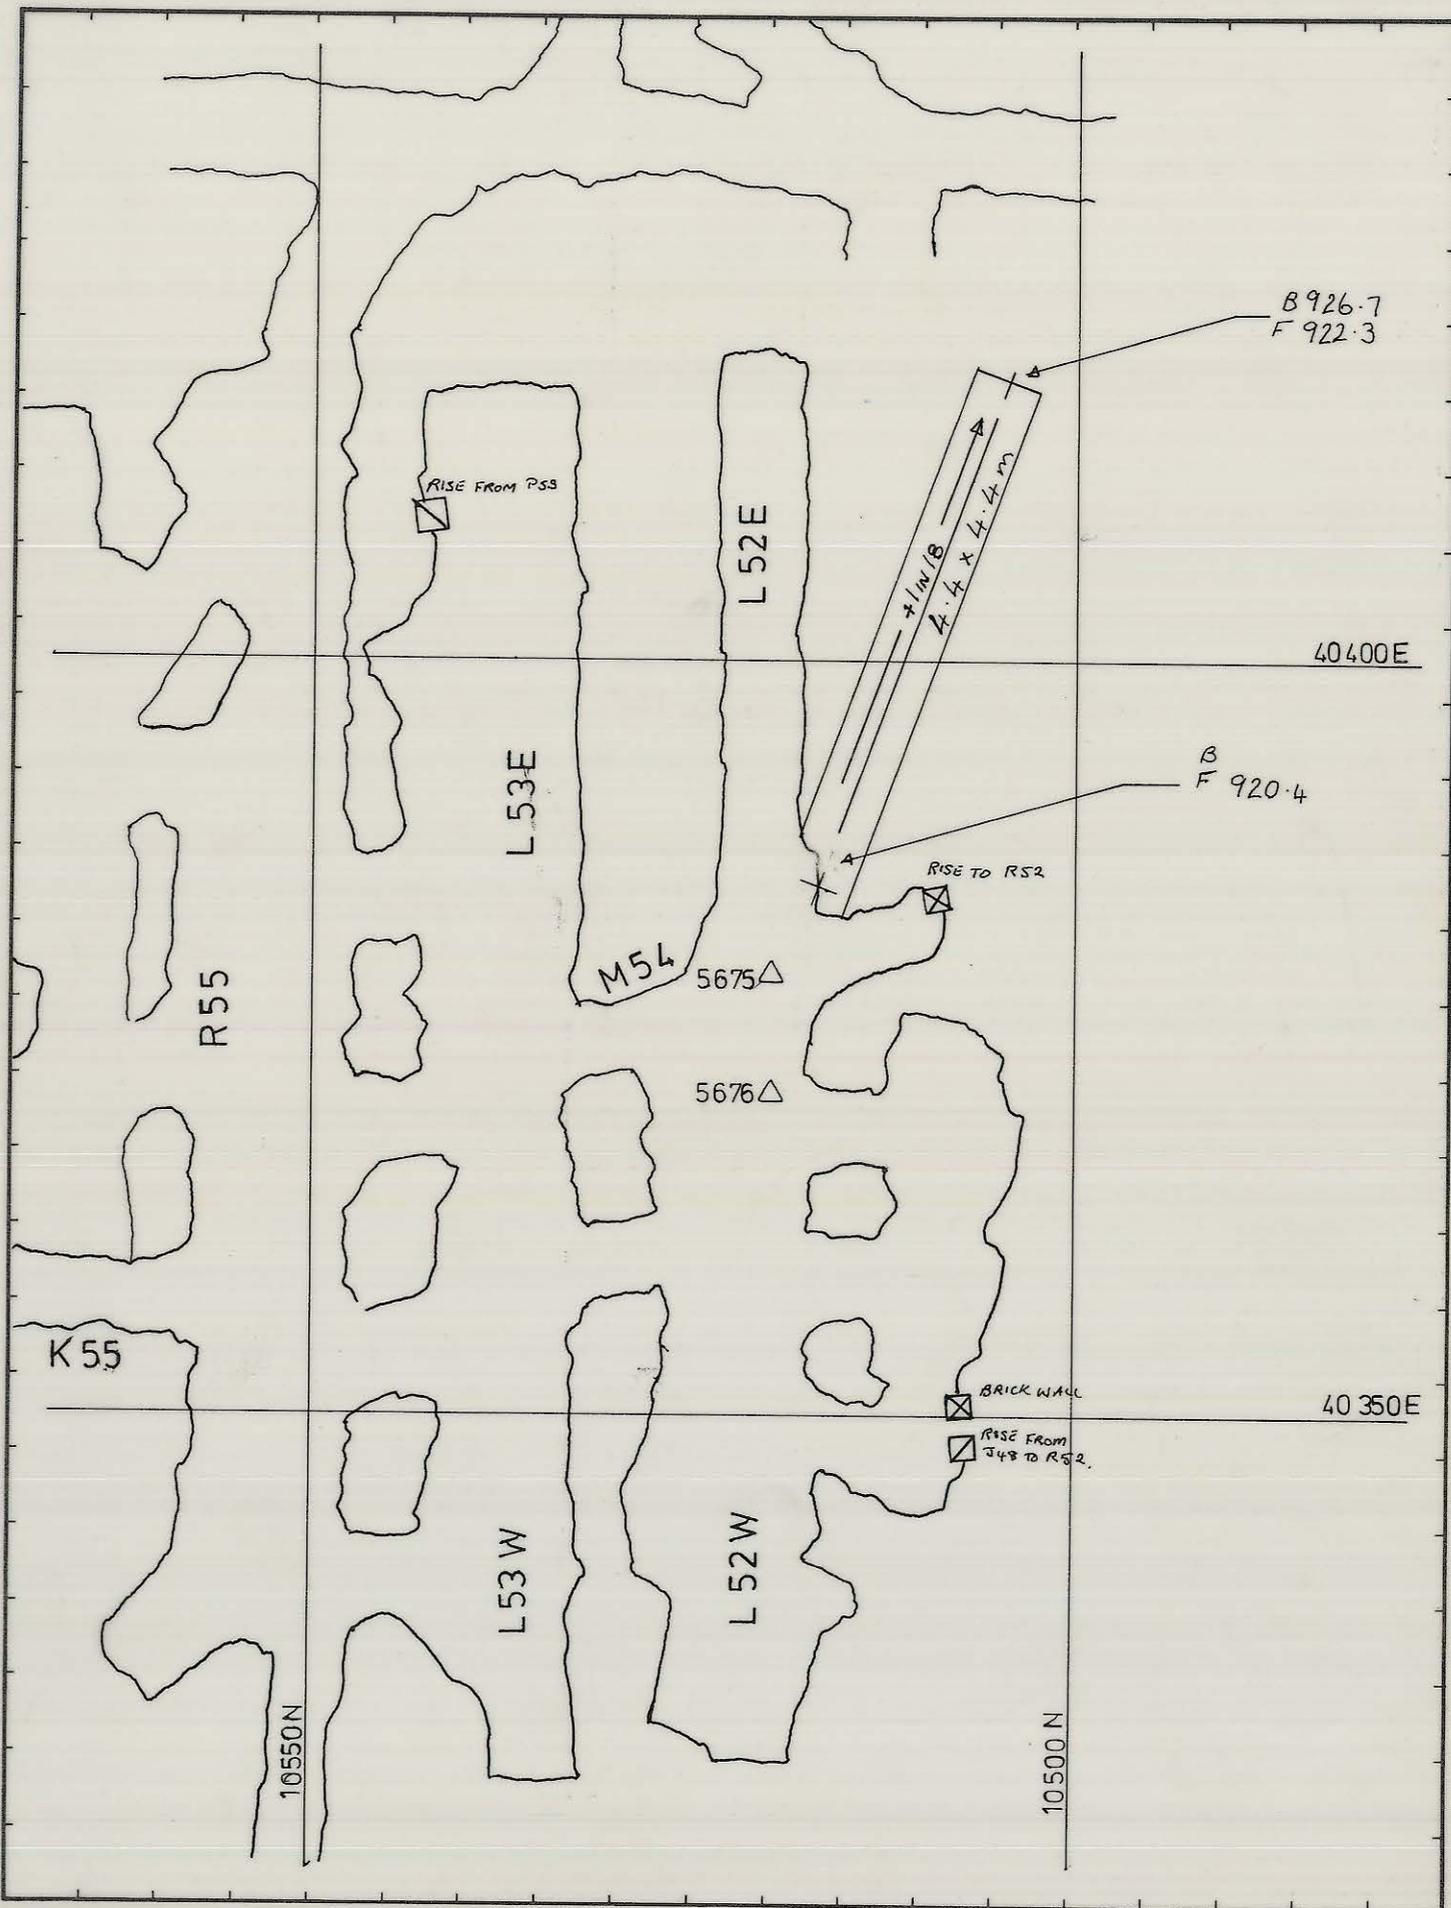

REF PLAN 04BH14-1013-1014	GEOLOGY			1:500 SCALE	
	SURVEY				
	PLANNING			C1 LENS 6TH LIFT	
	ROCK.MEC.			922.3-926.7 m.R.L.	
	GRADE CON.			DRAWING NUMBER	
	DRAFTING				
T.S.S.					