

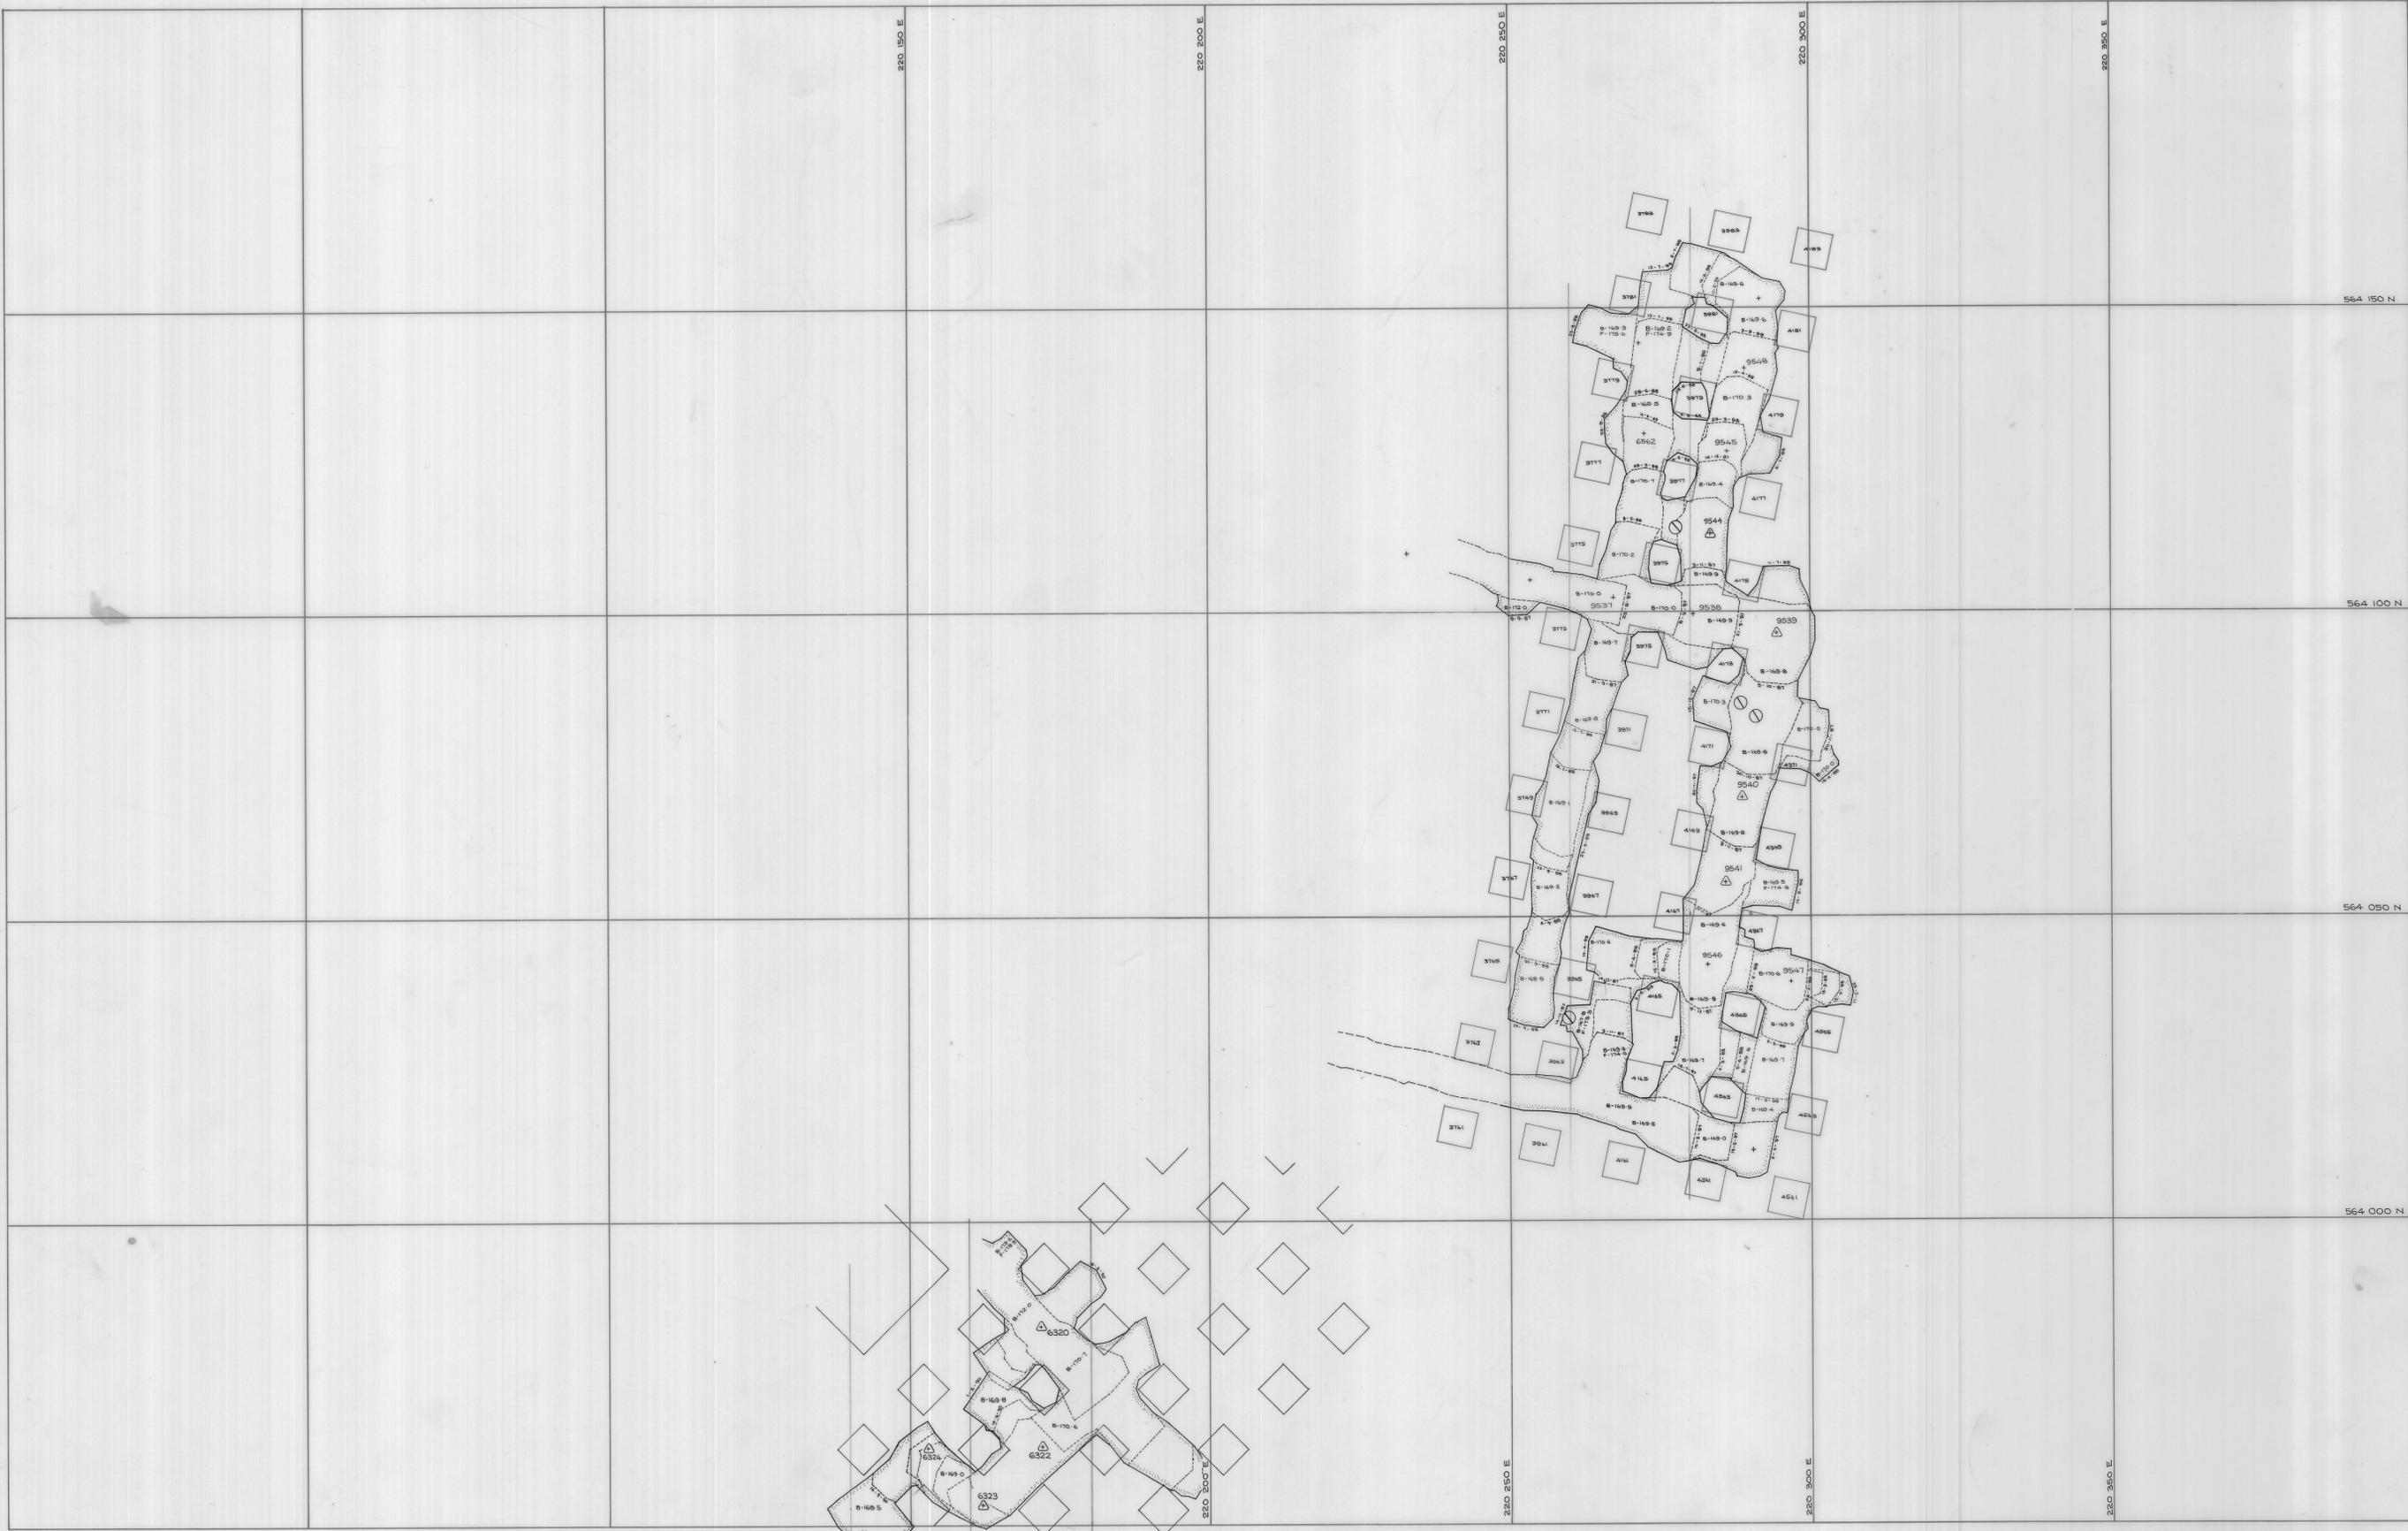


0374-407

04DM15-1044
Section 9 and 10, 20.8.90.

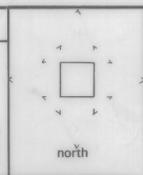

SCALE 1: 500

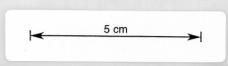

LOCATION DOLPHIN MINE
 SUBJECT MID WEDGE STOPE
 Lift 7
 LOWER PIT lift 15

KIS KING ISLAND SCHEELITE
 A DIVISION OF WARMAN INTERNATIONAL

GRASSY KING ISLAND

PLAN NUMBER 04DM15 - 1044