




03 BHD3-1001

1-5-82
PROJECTED
SECTION
E10350

0374_4082

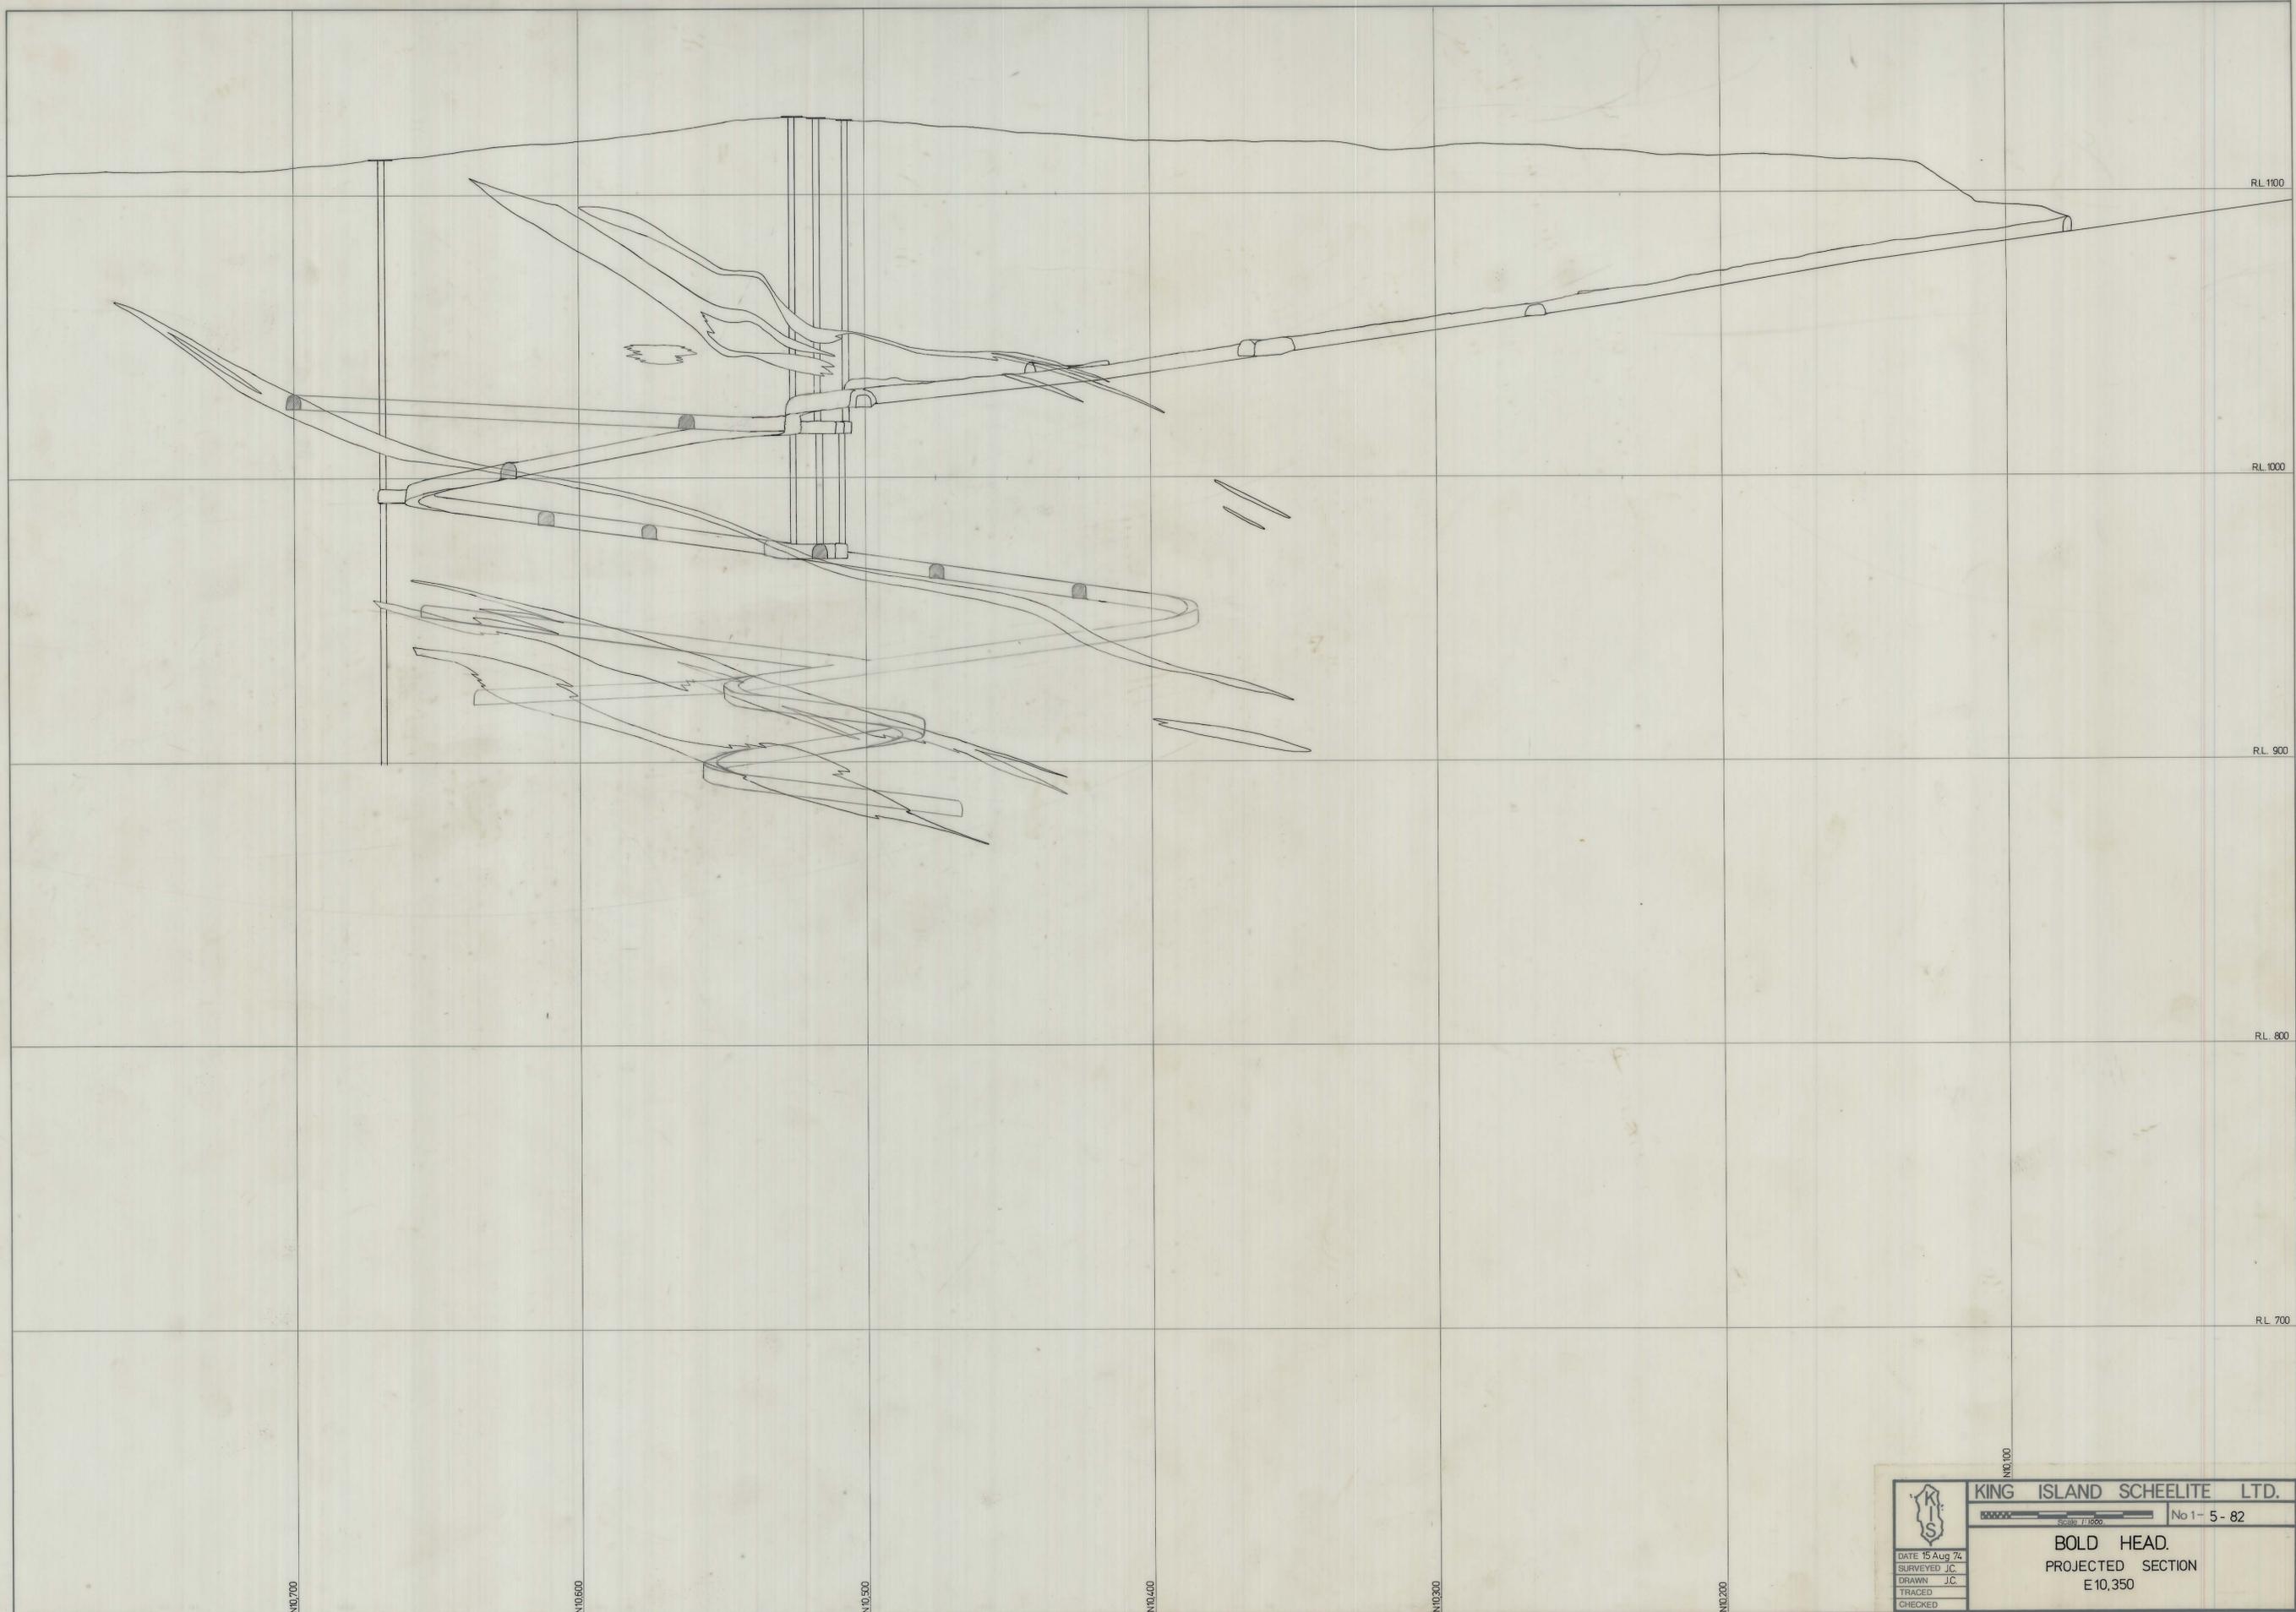

	KING ISLAND SCHEELITE LTD.	
	Scale 1:1000	
	No 1-5-82	
	BOLD HEAD. PROJECTED SECTION E 10,350	
	DATE 15 Aug 74	
SURVEYED JC		
DRAWN JC		
TRACED		
CHECKED		