


03 BH03-1003

0374_4084

1:500
BOLD HEAD MINE
MASTER PLANNING
1-5-11/A

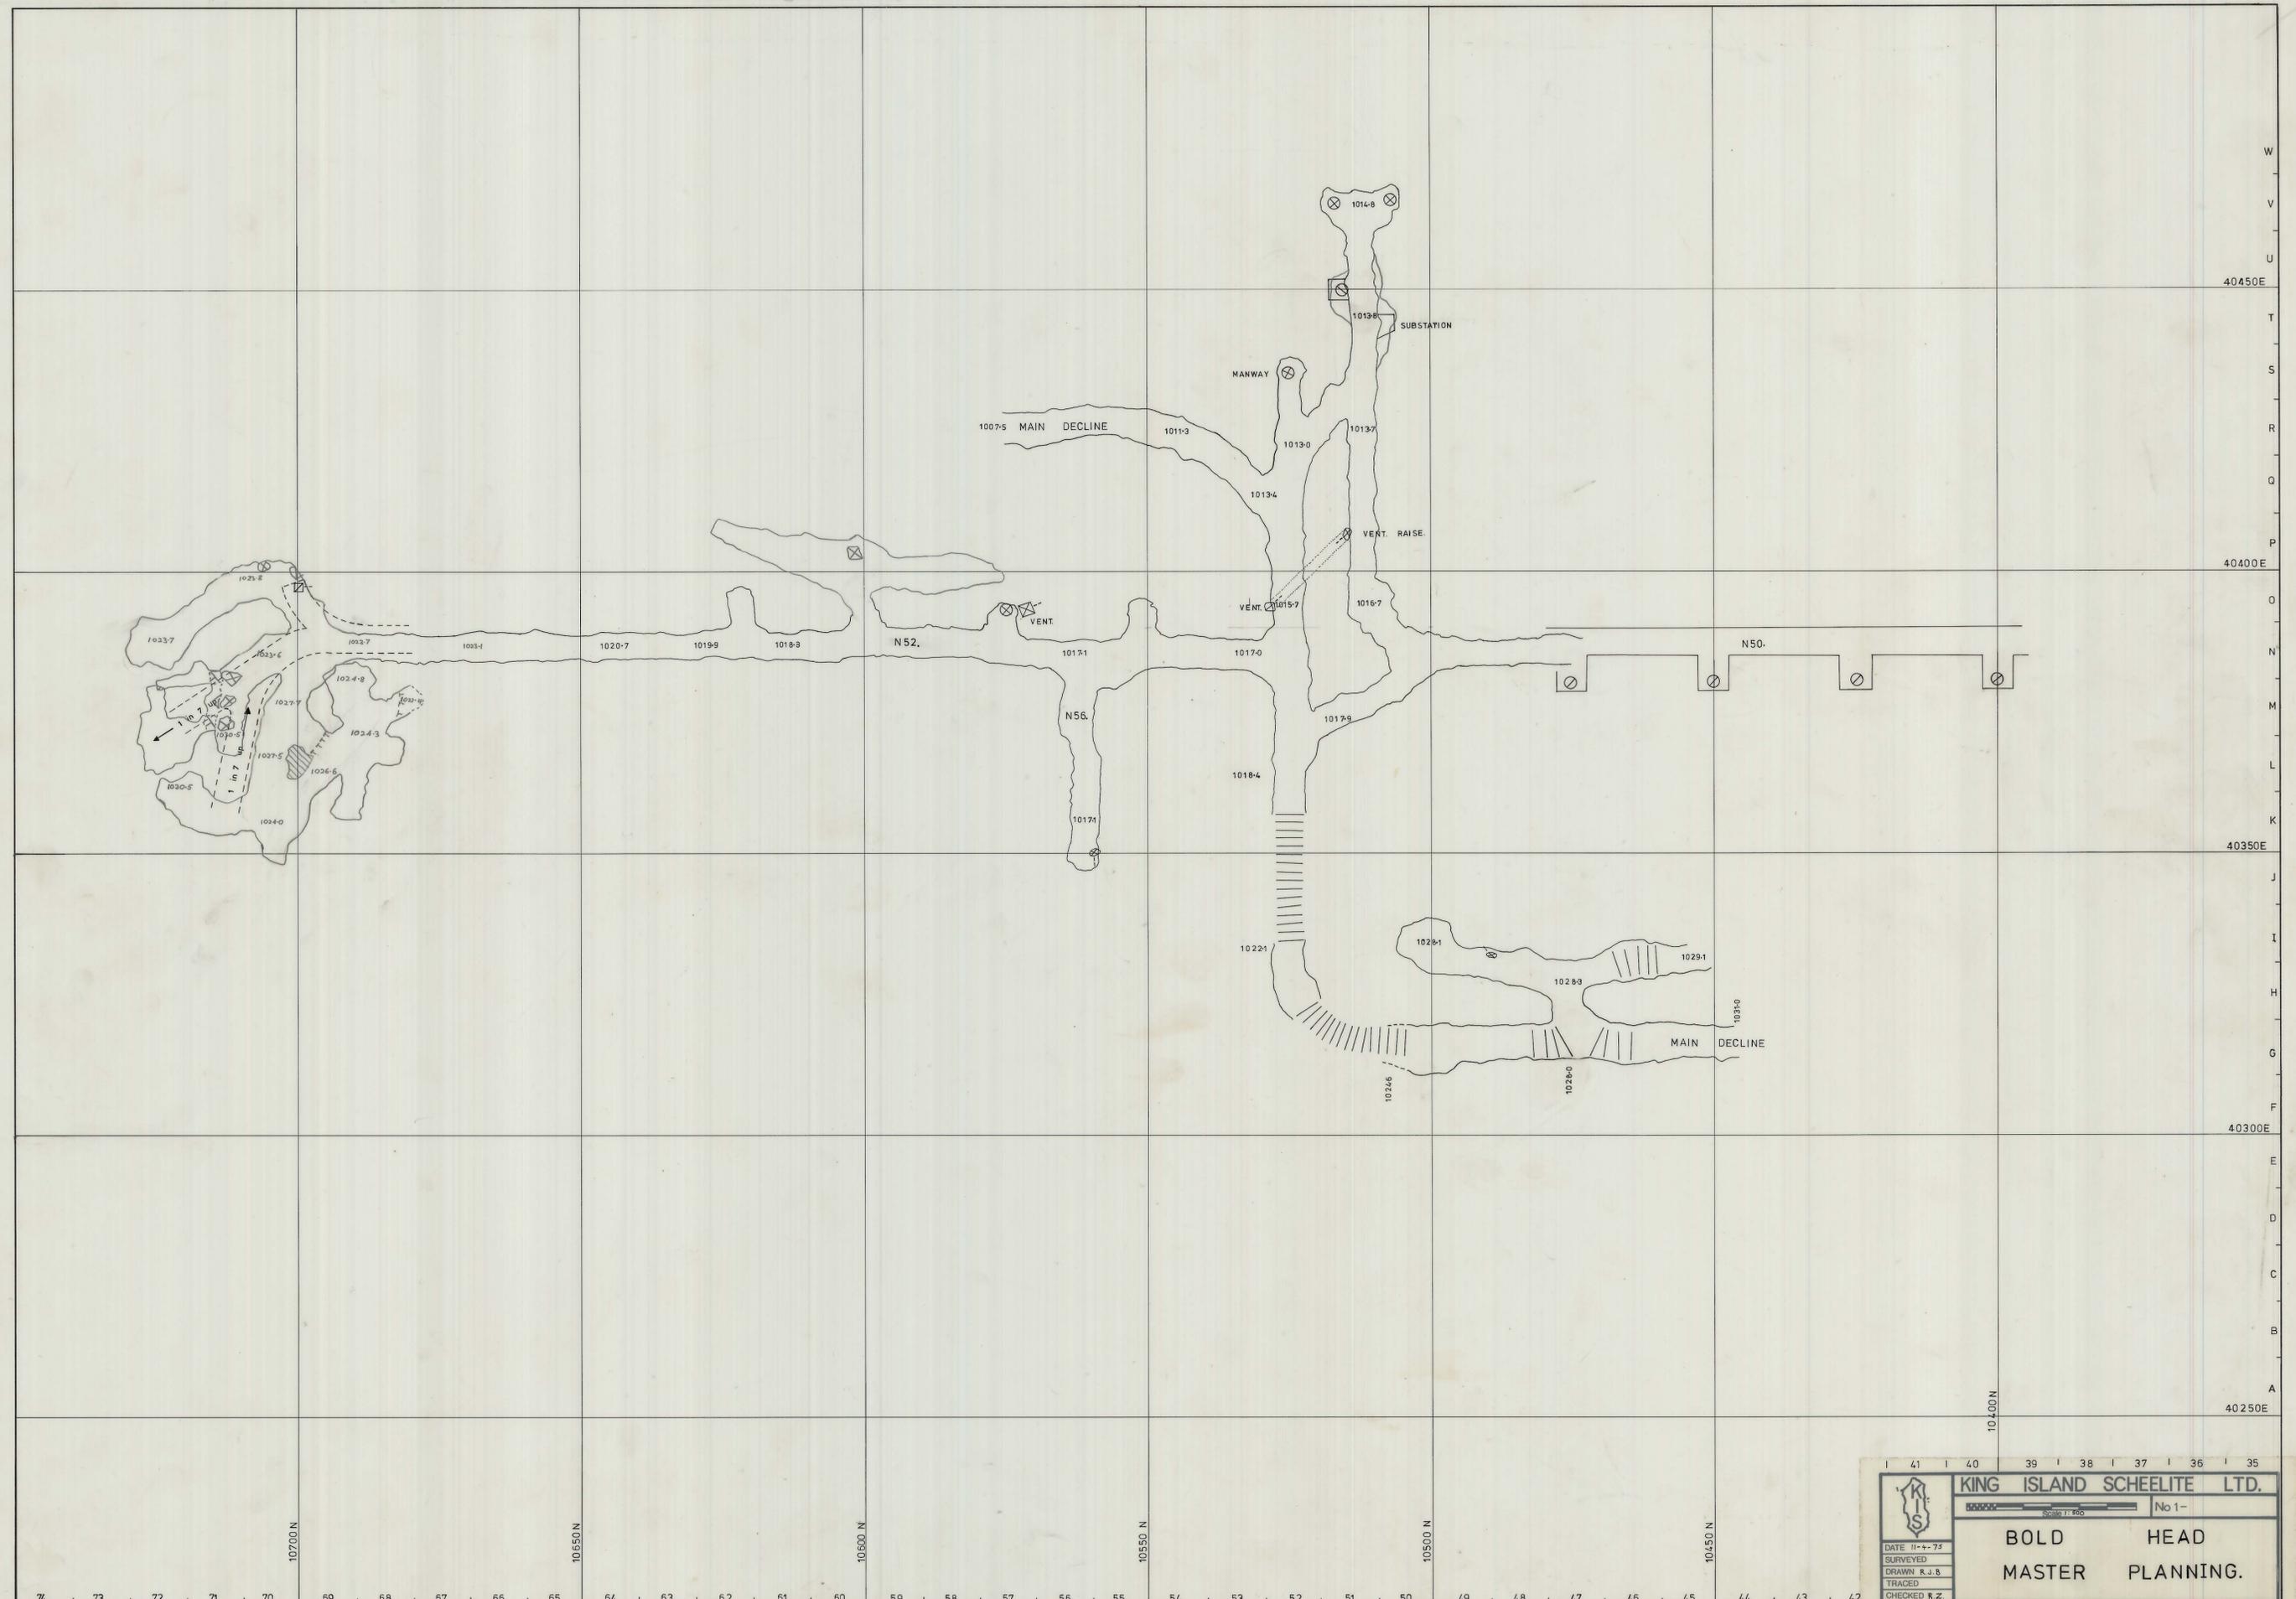

W
V
U
40450E
T
S
R
Q
P
40400E
O
N
M
L
K
40350E
J
I
H
G
F
40300E
E
D
C
B
A
40250E

KING ISLAND SCHEELITE LTD.	
DATE 11-11-75	No 1-
SURVEYED	
DRAWN R.J.B.	
TRACED	
CHECKED R.Z.	

**BOLD HEAD
MASTER PLANNING.**