




0374_4098

037
ASSAY RES

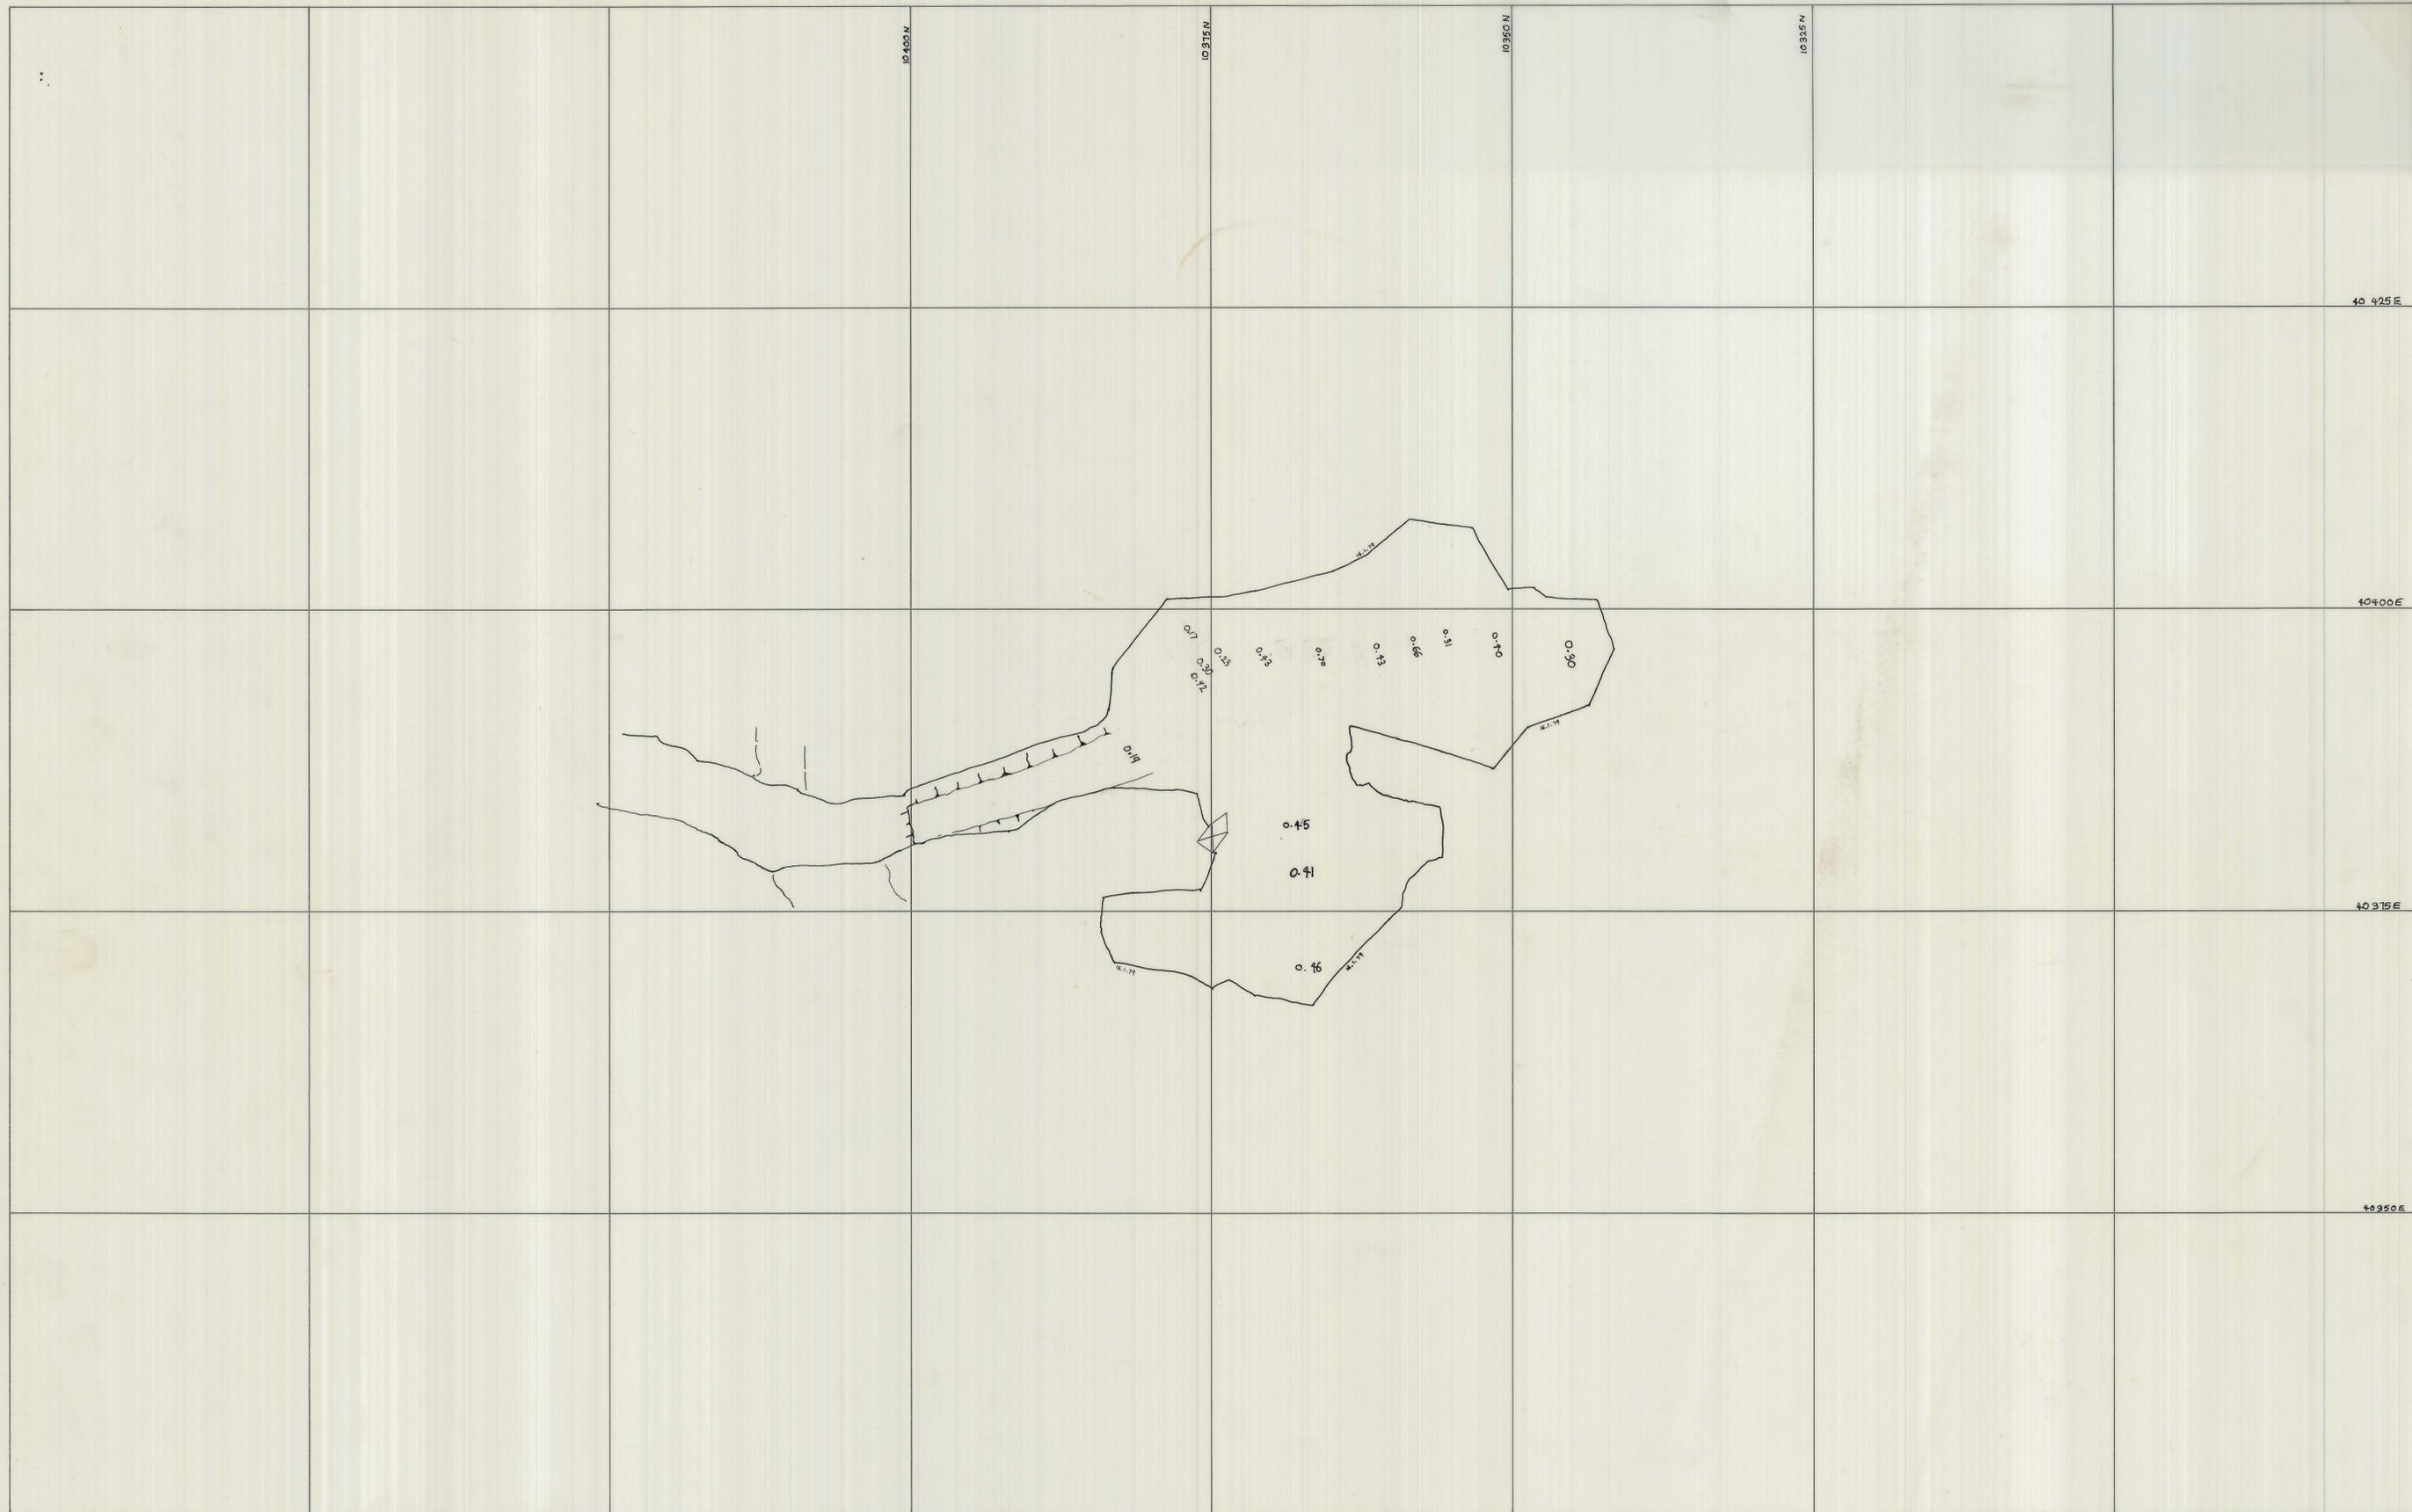

SCALE 1: 250		LOCATION	
		BOLD HEAD MINE	
		SUBJECT	
		037 (046) - 3rd LIFT	
		BF2 ASSAY RESULTS	
		% WO ₃	
		KING ISLAND SCHEELITE A DIVISION OF WARMAN INTERNATIONAL	
		GRASSY KING ISLAND	
		PLAN NUMBER	