


5 cm

04DM14-10

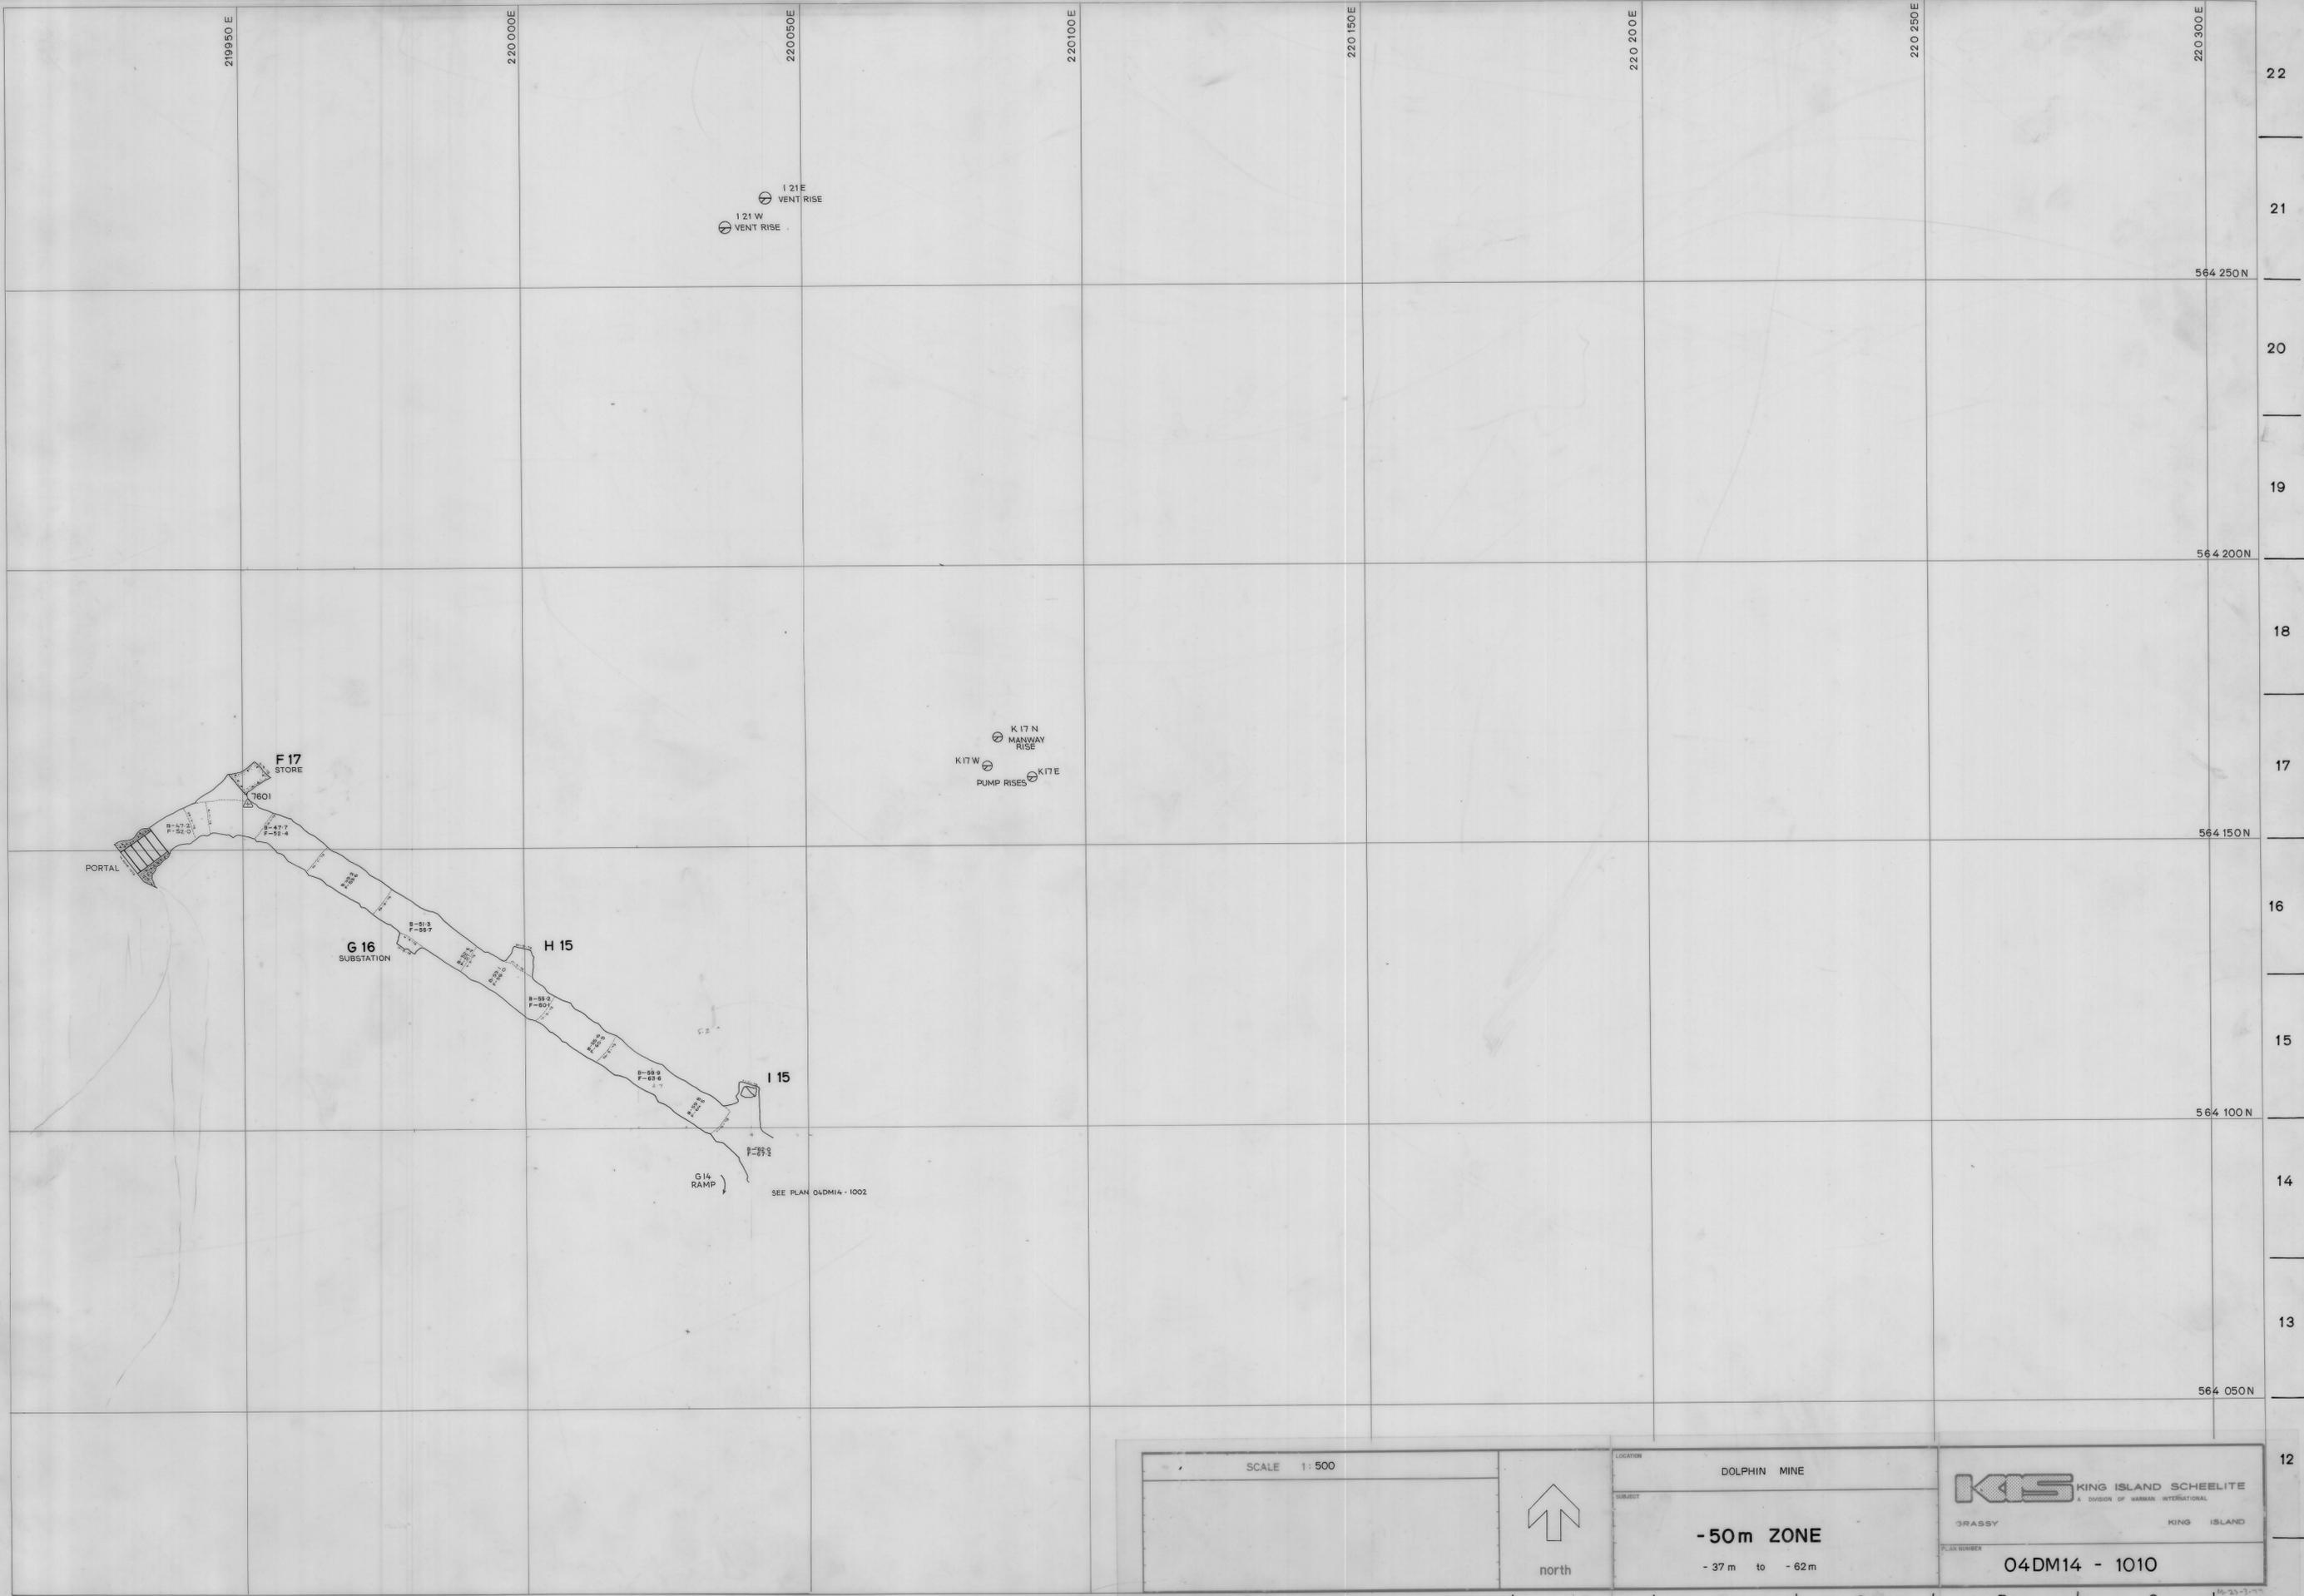

D | E | F | G | H | I | J | K | L | M | N | O | P | Q | R | S

SCALE 1:500



north

LOCATION DOLPHIN MINE

SUBJECT -50m ZONE

-37 m to -62 m

KIS KING ISLAND SCHEELITE
A DIVISION OF WARRIOR INTERNATIONAL

GRASSY KING ISLAND

PLAN NUMBER 04DM14 - 1010

10-23-11