


03 BH 06-3001


1-5-128
Bold Head
972 m RL Sump
Layout.

0374_4102

5 cm

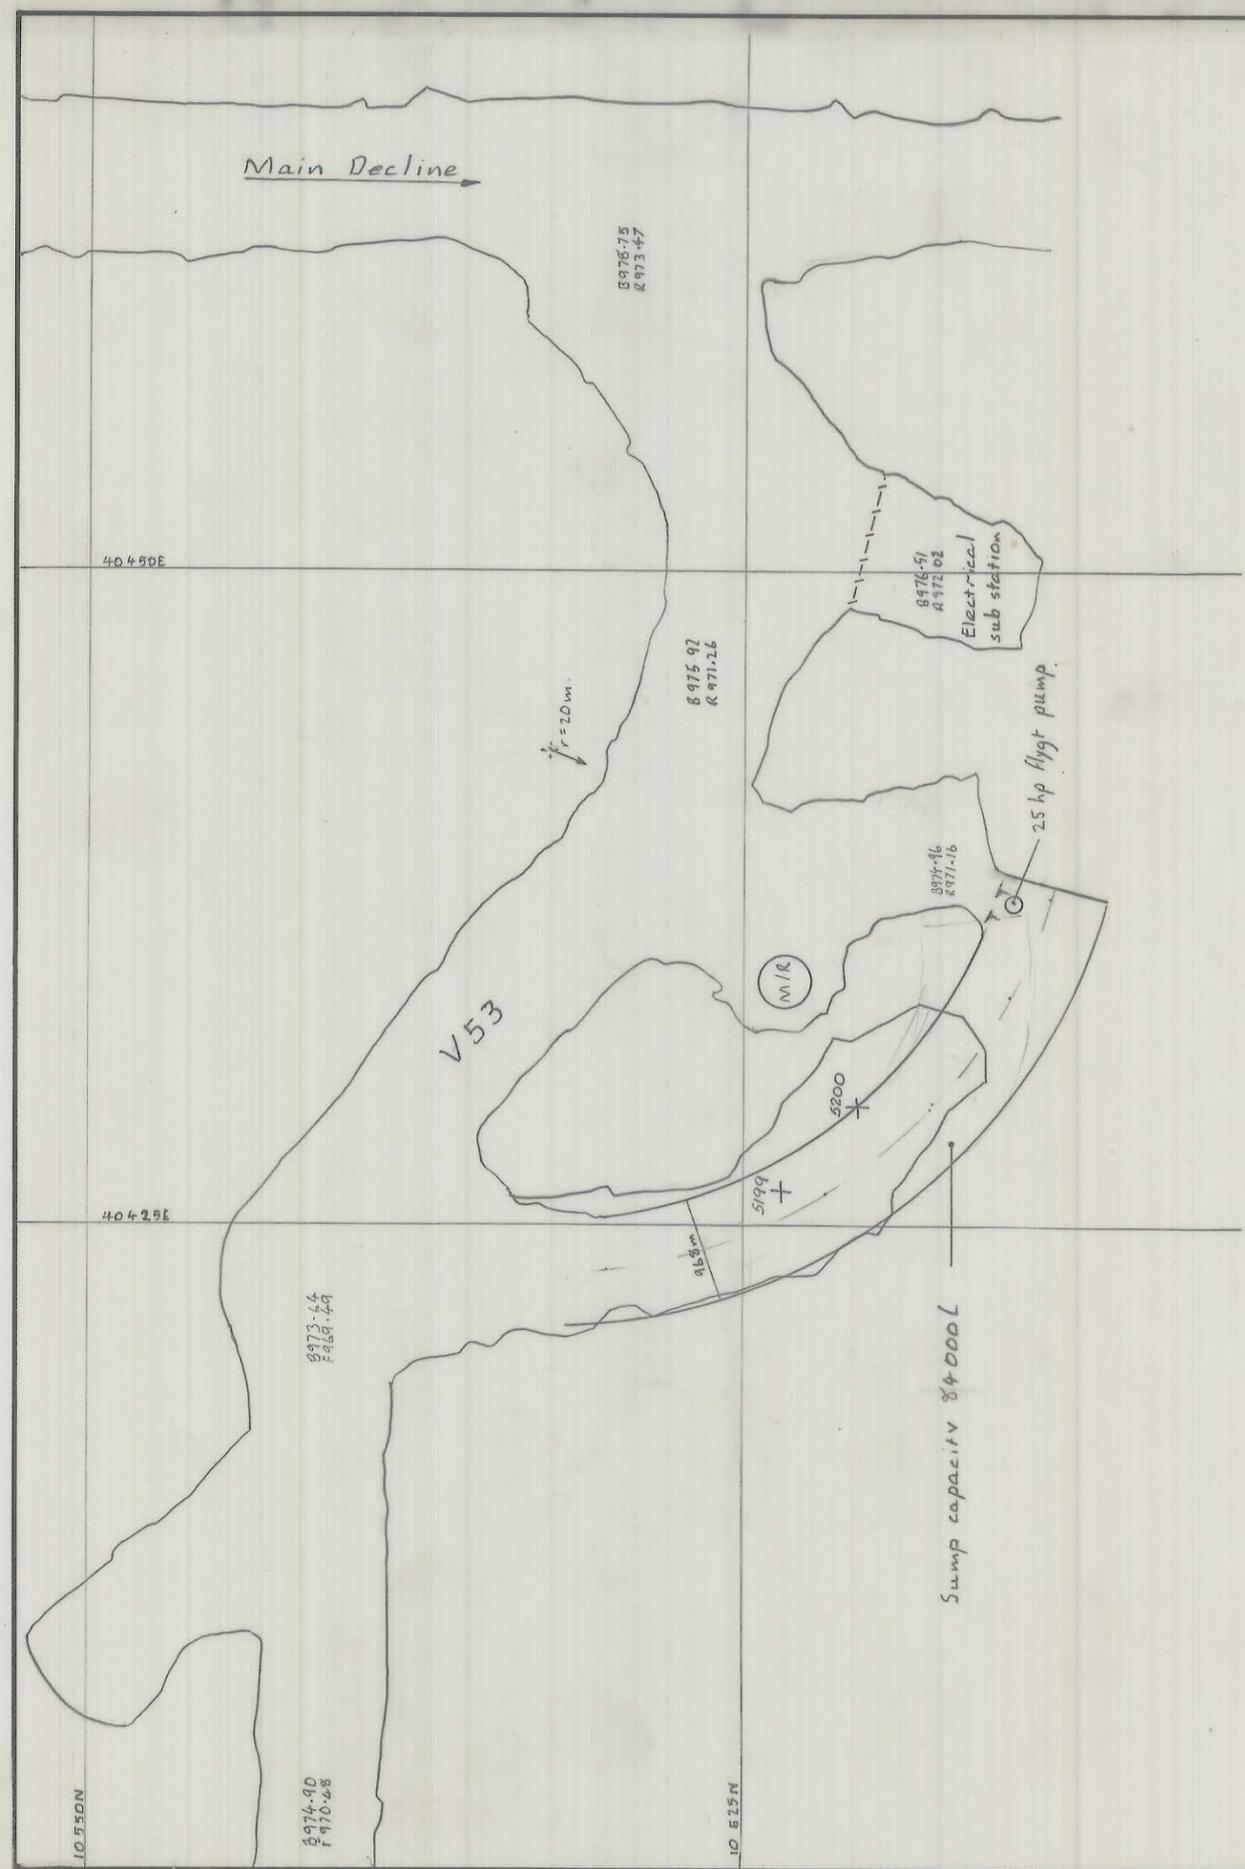

PLAN

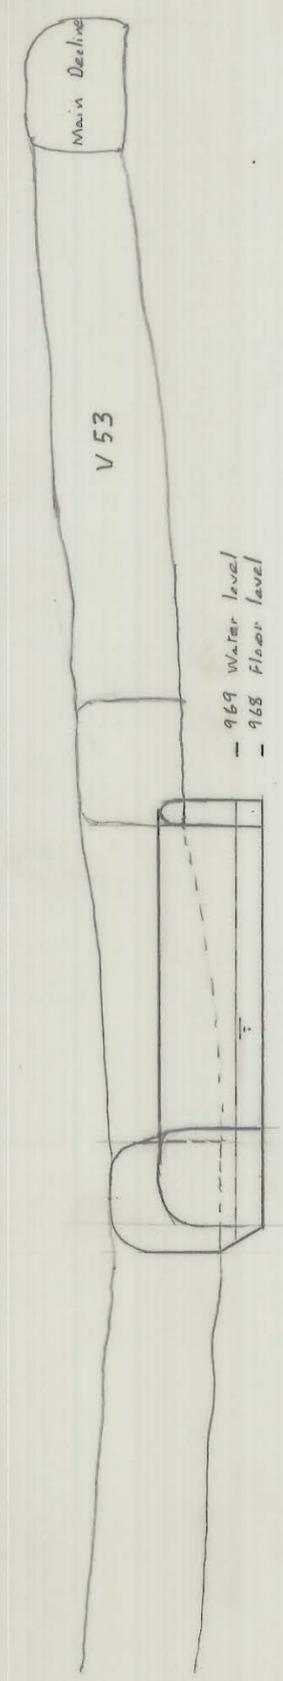

SECTION

KING ISLAND SCHEELITE

DATE: 17/2/76 SCALE: 1:250
MINE: BOLD HEAD DWG/NO.: 1-5-128

972 m RL. Sump Layout

HLR

PRELIMINARY	FINAL		
-------------	-------	--	--