


03 BHOX-2001

0374_4103

11250
BOLD HEAD
MAIN SUMP AND B-
LENS ACCESS AT
971 AND 975
1-5-117

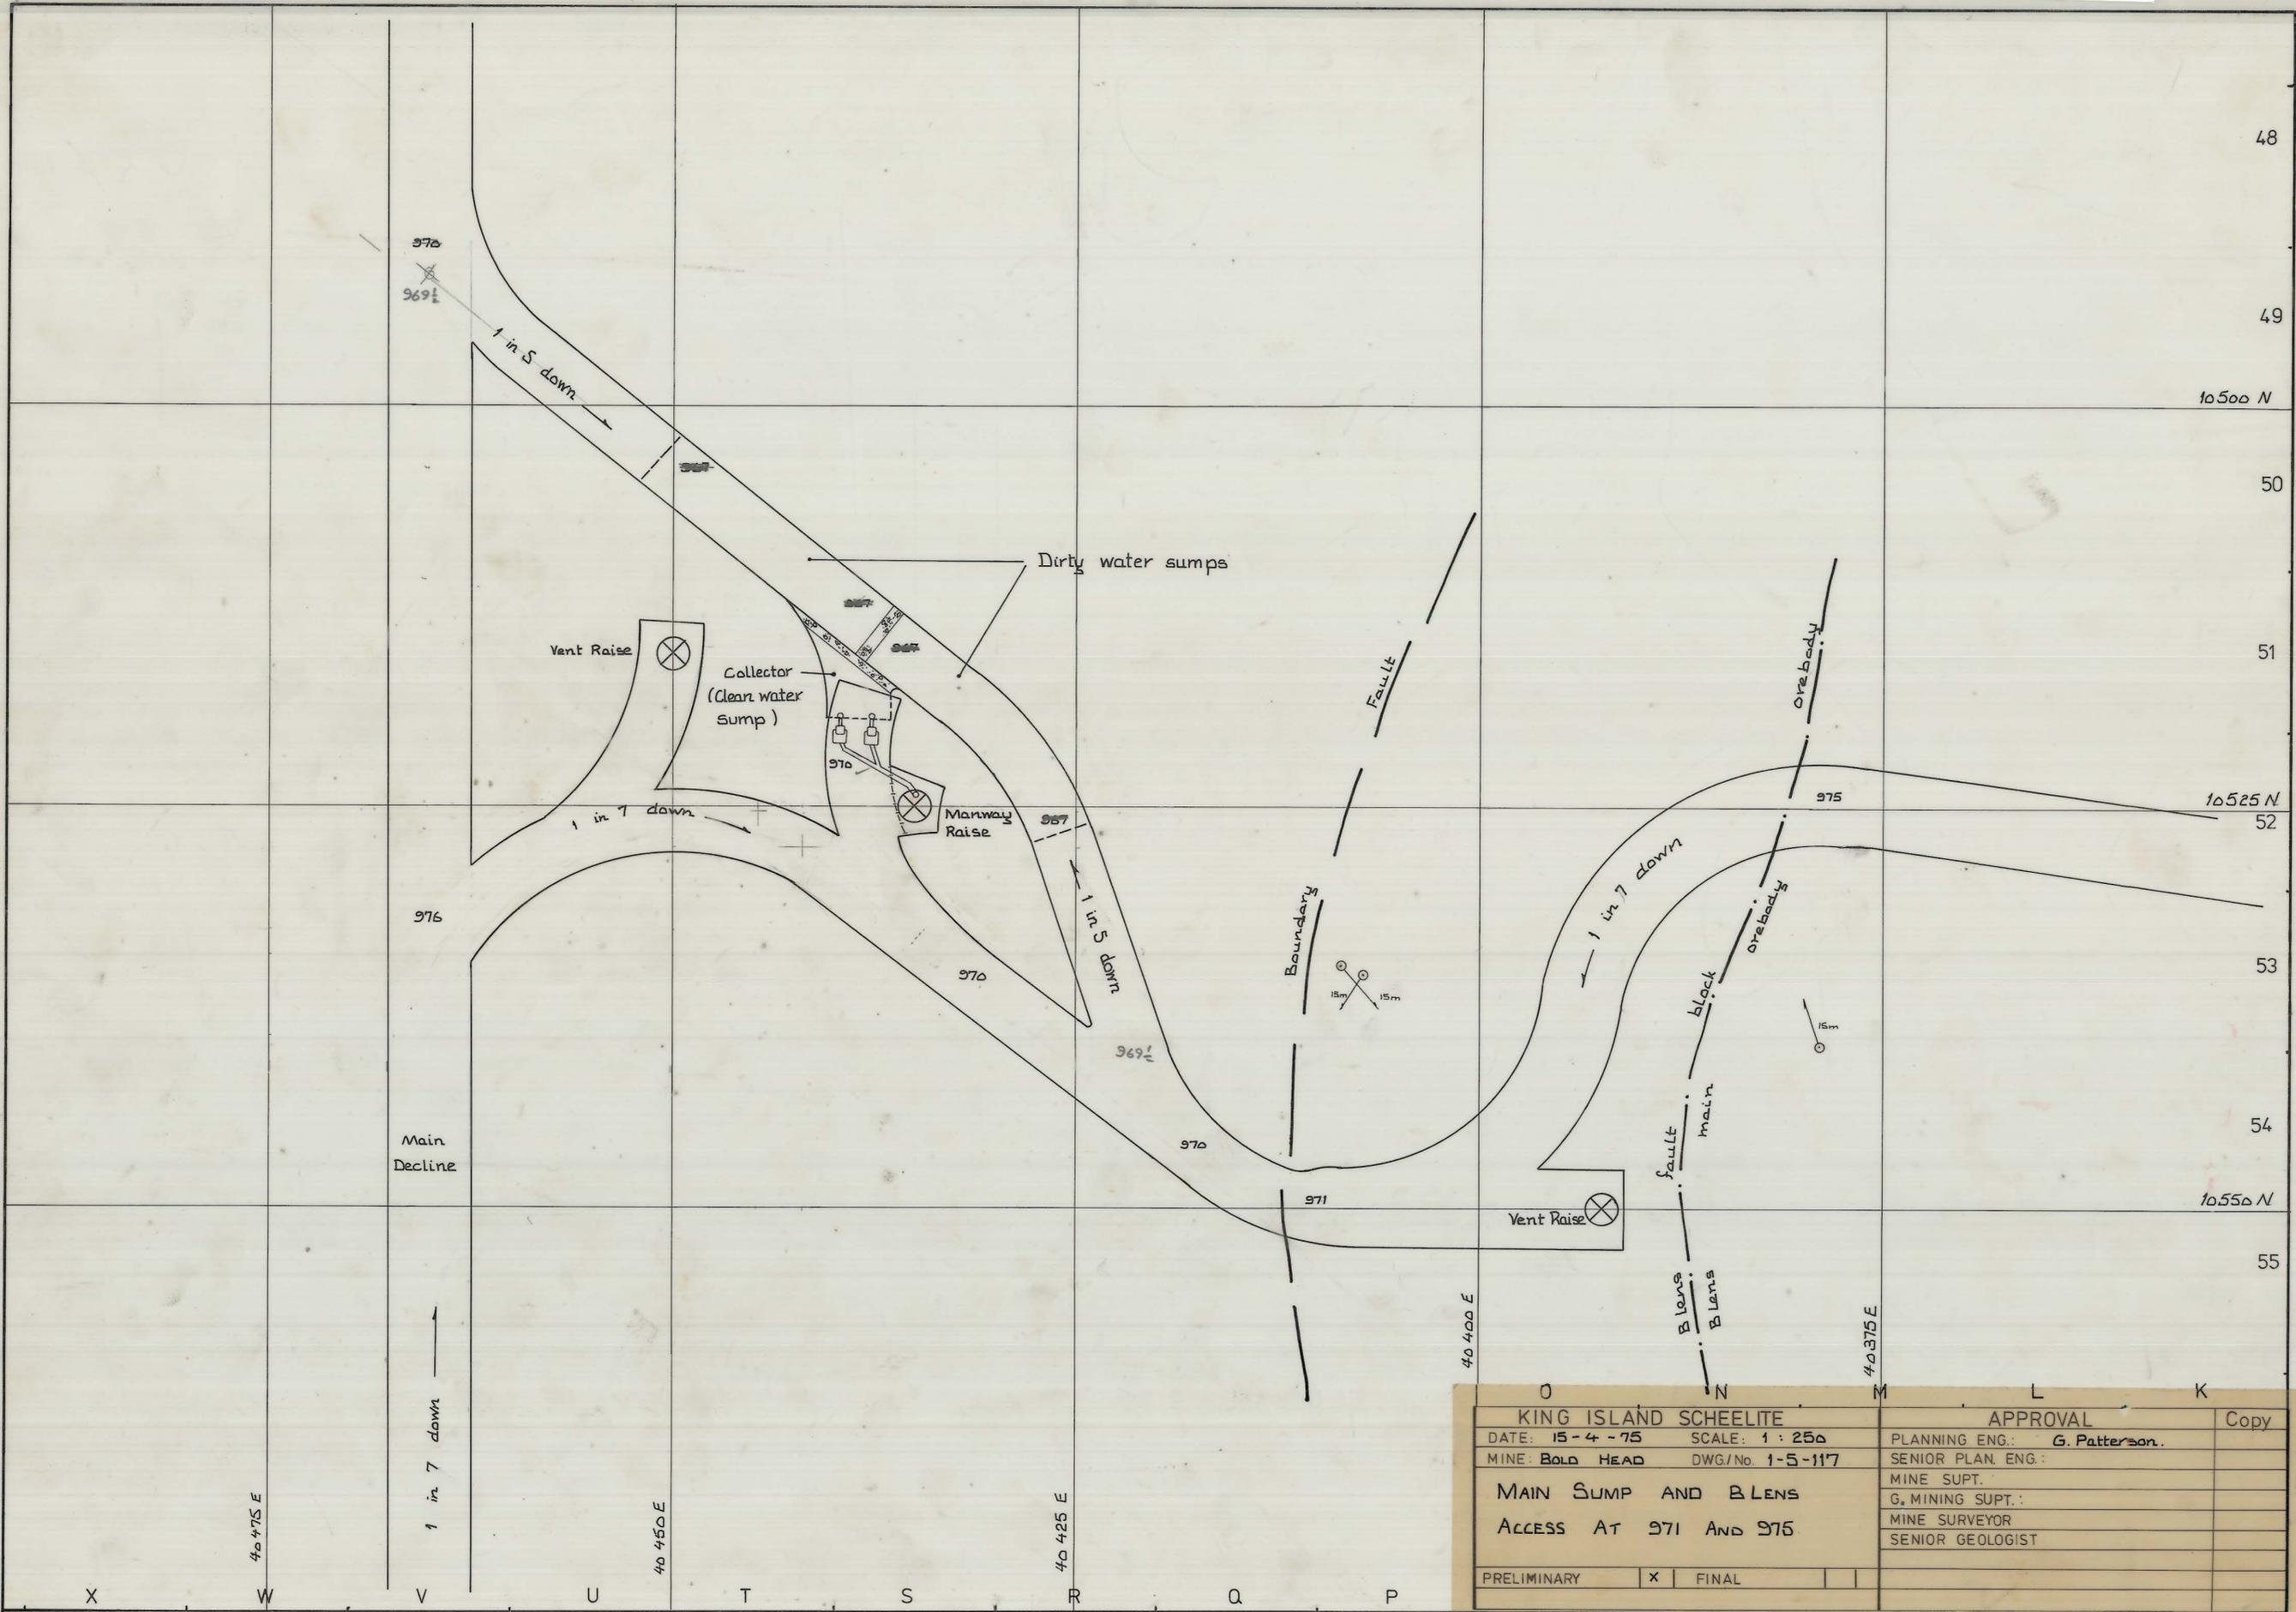

KING ISLAND SCHEELITE		APPROVAL		Copy
DATE: 15-4-75	SCALE: 1:250	PLANNING ENG.: G. Patterson.		
MINE: BOLD HEAD	DWG./No. 1-5-117	SENIOR PLAN. ENG.:		
MAIN SUMP AND B LENS		MINE SUPT.:		
ACCESS AT 971 AND 975		G. MINING SUPT.:		
		MINE SURVEYOR		
		SENIOR GEOLOGIST		
PRELIMINARY	X	FINAL		