


27 JUN 1981

0374_4108

5 cm

03 BH 03 3002

REVISIONS NO	DATE	DESCRIPTION	INITIALS
1	7/9/78	Change in Decline beyond 906 RL A RL's in 059	<i>[Signature]</i> 7/9/78

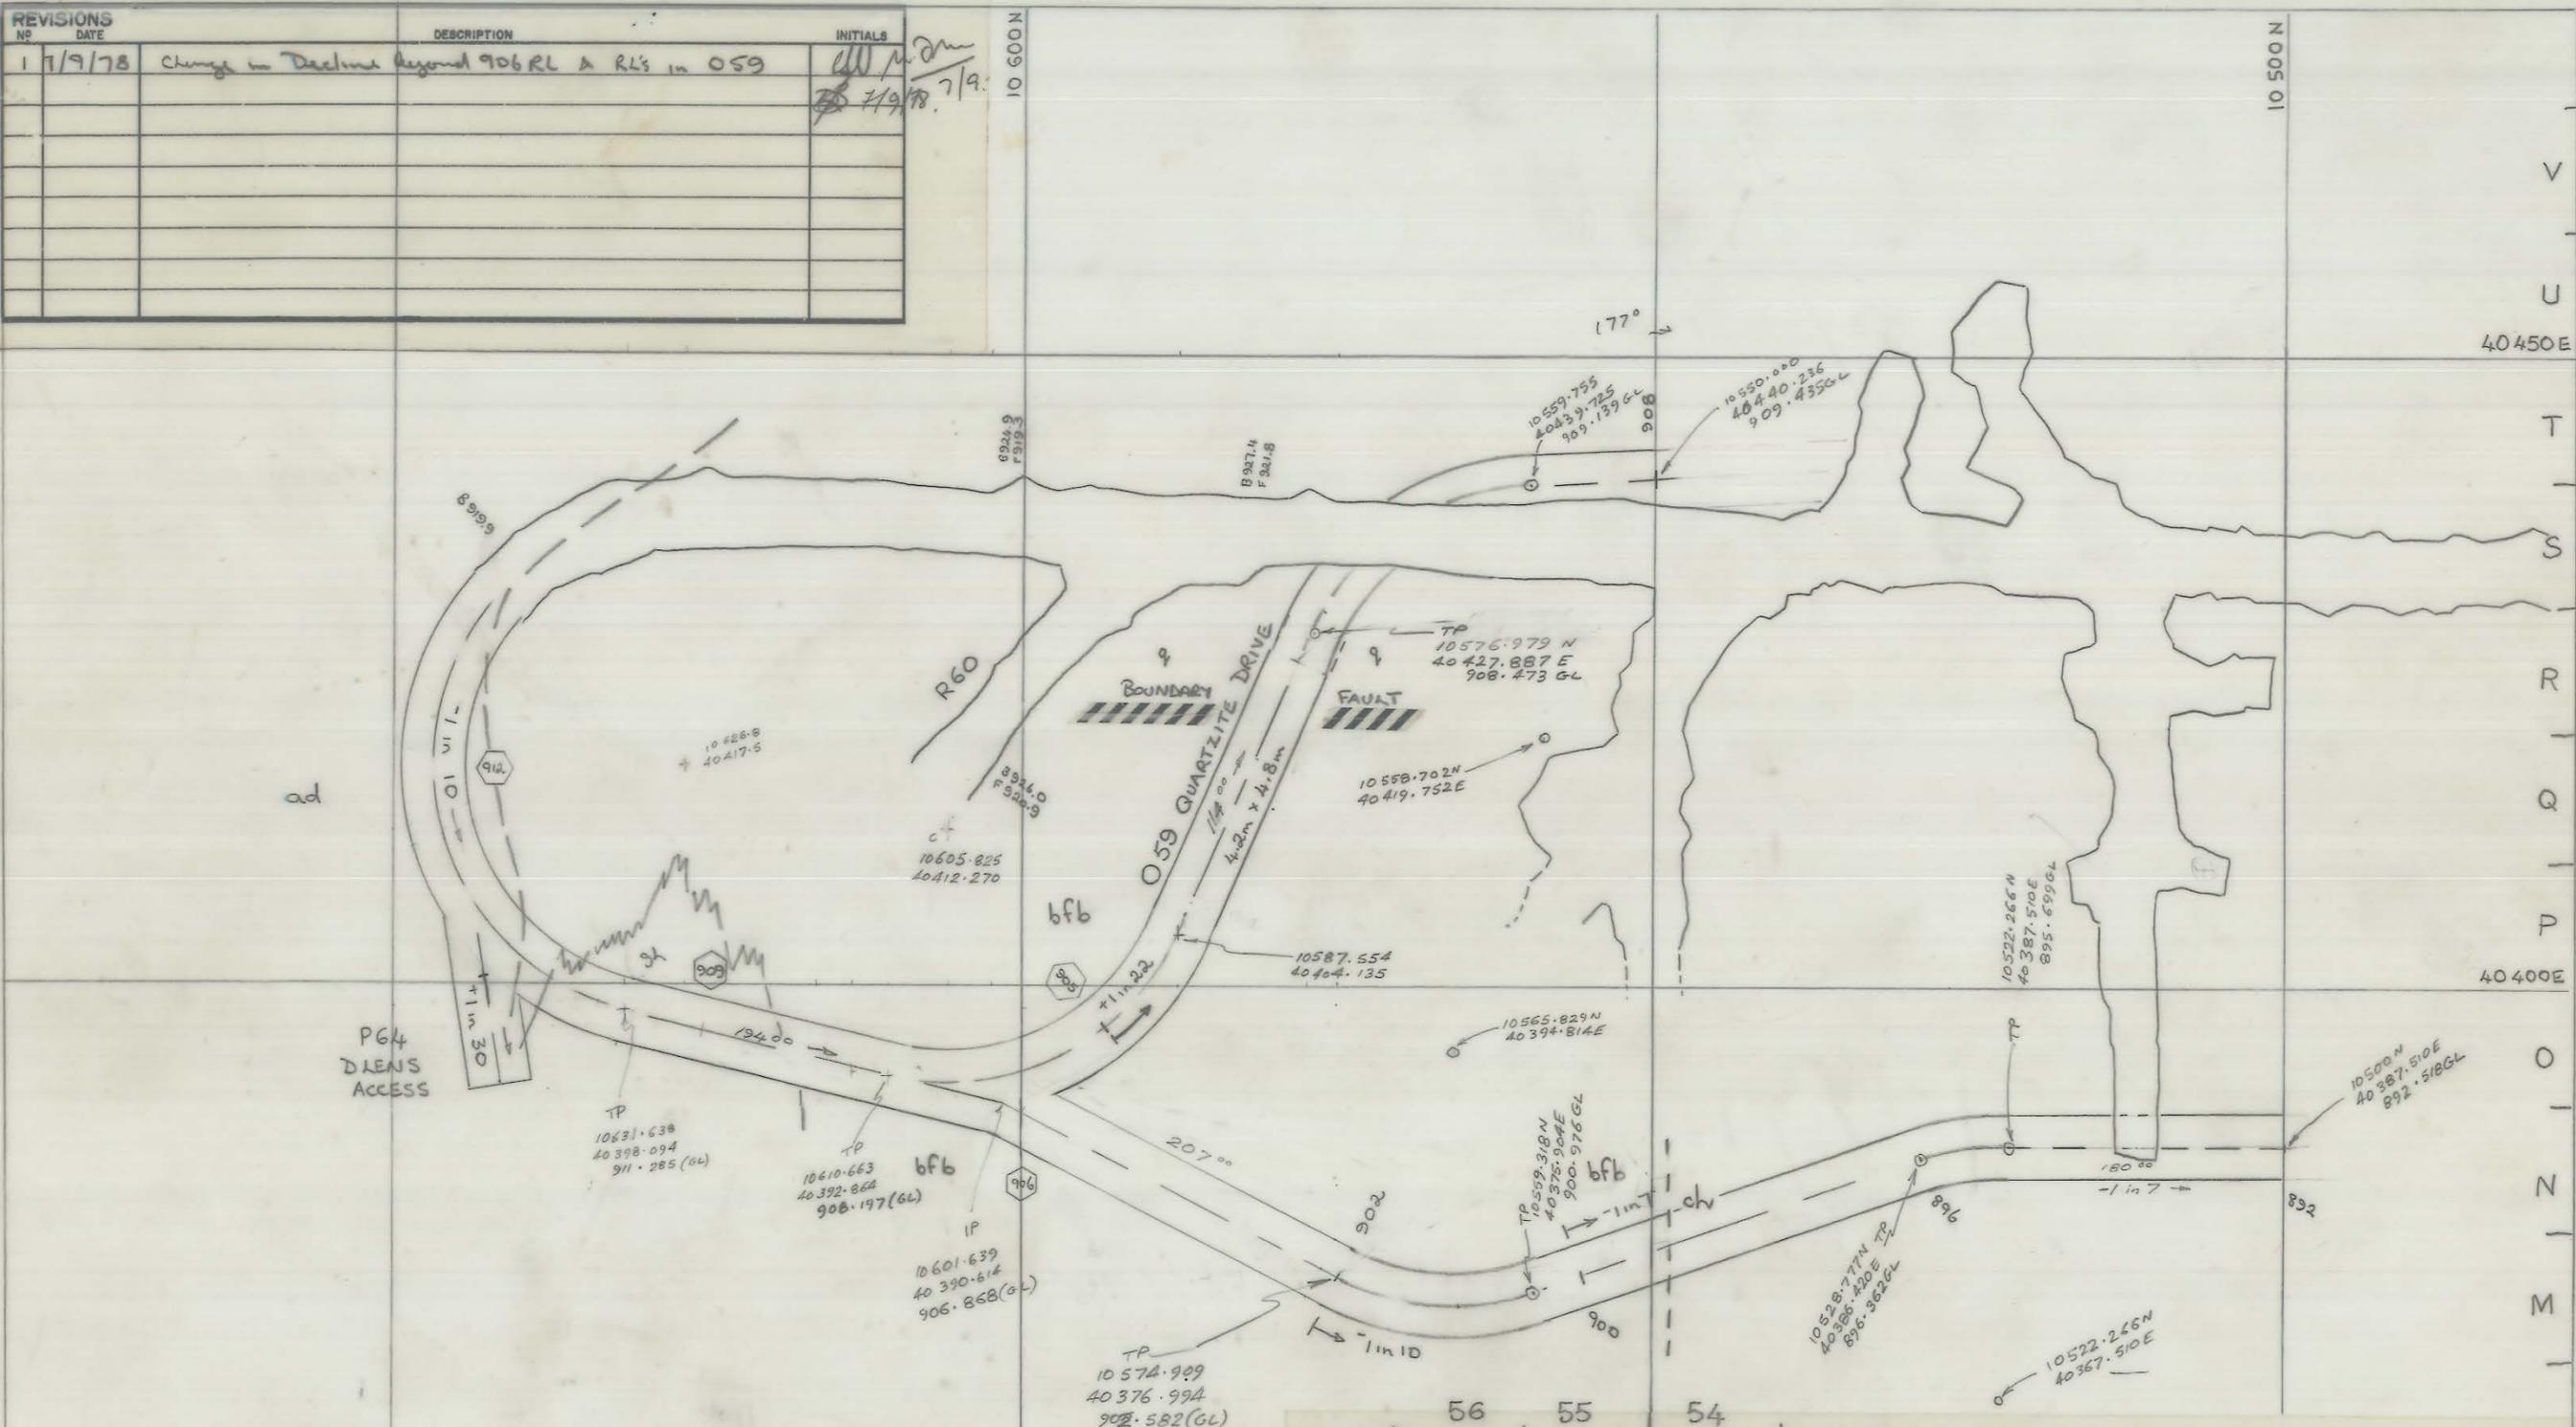

STRAIGHT: 4.2m x 4.8m
1 in 7 Gradient

CURVE: 4.2m x 5.2m, 20m RADIUS
1 in 10 Gradient

KING ISLAND SCHEELITE		APPROVAL	COPY
DATE: 22 JUNE 1978	SCALE: 1:500	PLANNING ENG.:	
MINE: BOLD HEAD	DWG/NO.: 03 BH 03 3002	SENIOR PLAN. ENG.:	
<u>MAIN DECLINE to 903 m RL</u>		MINE SUPT.:	
		G. MINING SUPT.:	
<u>QUARTZITE DRIVE (059)</u>		SENIOR SURV'R.:	
		SENIOR GEOLOGIST:	
PRELIMINARY	FINAL	SURVEYOR: <i>[Signature]</i>	
		<i>[Signature]</i> 7/9/78	
		7/9/78	

67 66 65 64 63 62 61 60 59 58