


0374_4109

5 cm

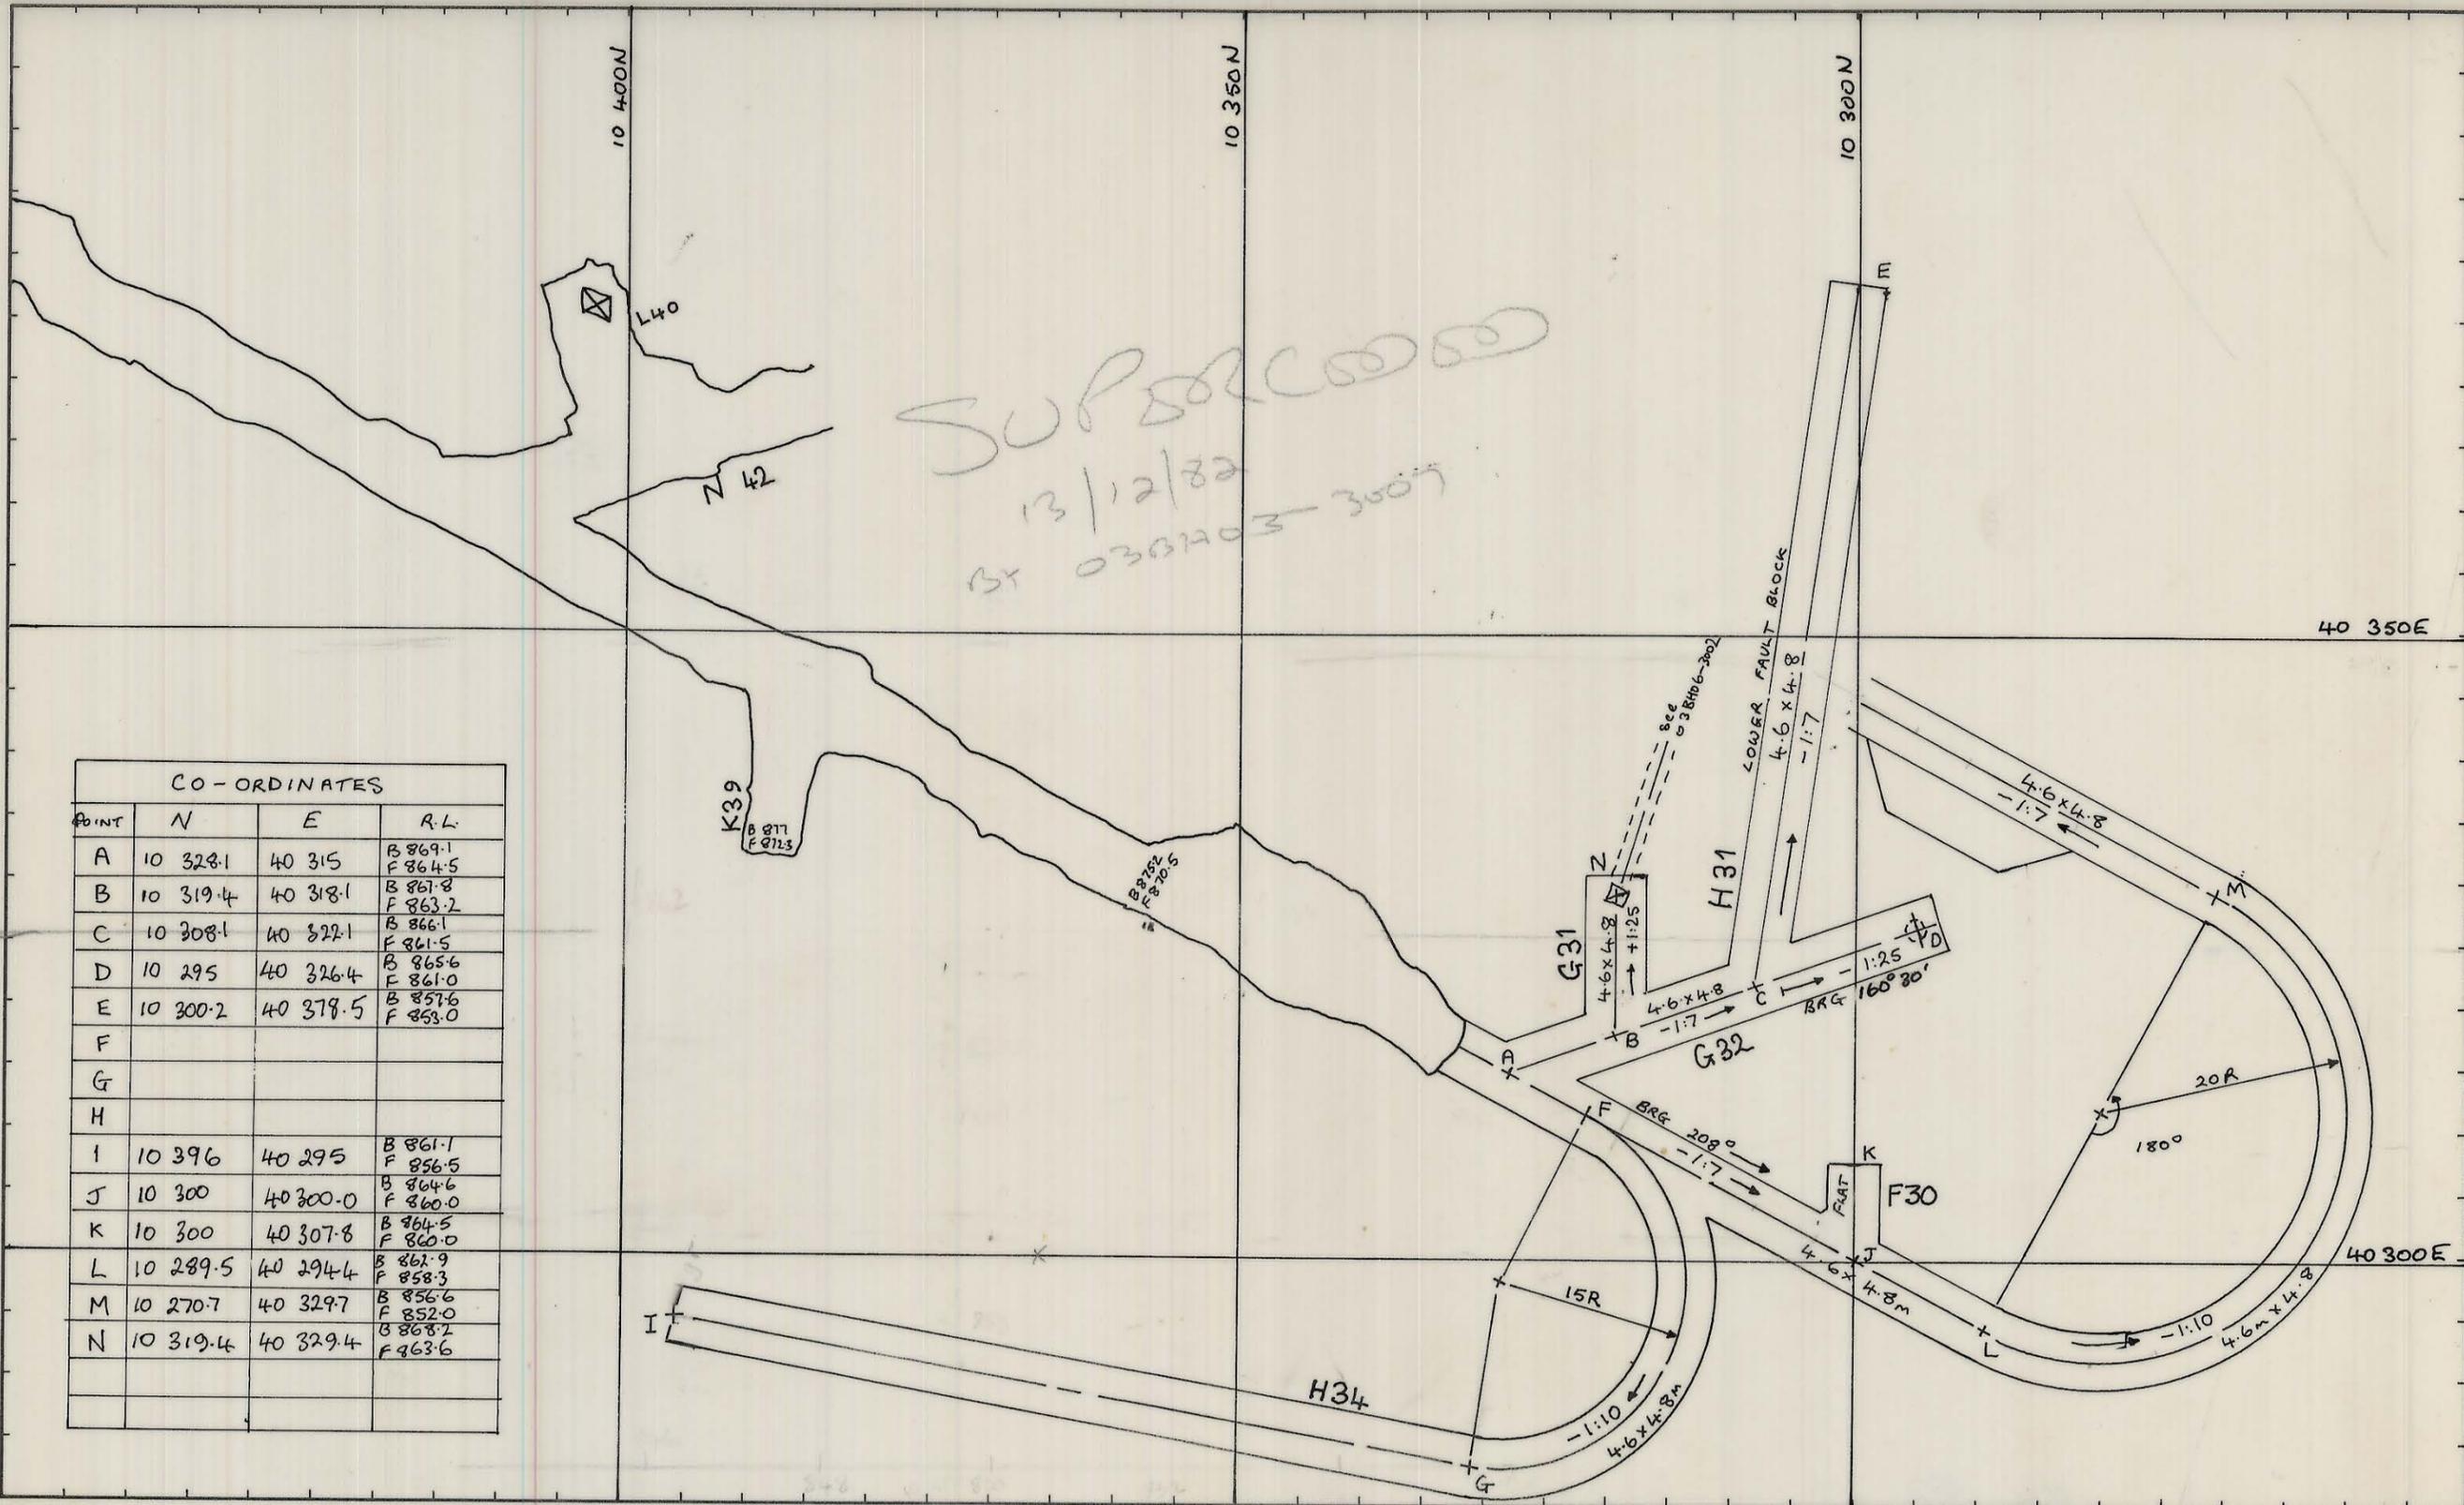

CO-ORDINATES			
POINT	N	E	R.L.
A	10 328.1	40 315	B 869.1 F 864.5
B	10 319.4	40 318.1	B 867.8 F 863.2
C	10 308.1	40 322.1	B 866.1 F 861.5
D	10 295	40 326.4	B 865.6 F 861.0
E	10 300.2	40 318.5	B 857.6 F 853.0
F			
G			
H			
I	10 396	40 295	B 861.1 F 856.5
J	10 300	40 300.0	B 864.6 F 860.0
K	10 300	40 307.8	B 864.5 F 860.0
L	10 289.5	40 294.4	B 862.9 F 858.3
M	10 270.7	40 329.7	B 856.6 F 852.0
N	10 319.4	40 329.4	B 868.2 F 863.6

REF PLAN 03 BH03 - 3003

Revision to 03 BH03 - 3003
 H34 moved to accommodate
 poor ground conditions
 in decline at original
 planned position. All other
 accesses unchanged.

GEOLOGY		
SURVEY		
PLANNING	A-DJ	4-1-82
ROCK MEC.		
GRADE CON.		
DRAFTING		
T.S.S.		

SCALE 1:500

KIS KING ISLAND SCHEELITE
GRASSY KING ISLAND

BOLD HEAD

MAIN DECLINE.

DRAWING NUMBER

03 BH03 - 3003