


27 JUN 1981


0374\_4110

03BH03 - 3004.

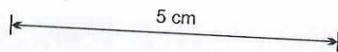

SUPRECESSOR  
03BH03  
13/12/82

CO-ORDINATES			
POINT	N	E	R.L.
17	10 313.7	40 352.5	B 843.6 F 845
18	10 361	40 340	B 842.6 F 838
19	10 338.4	40 365.6	B 845.6 F 841
20	10 324.4	40 392	B 840.9 F 836.3
21	10 365.6	40 387.2	B 839.6 F 835.0
22	10 379	40 325.3	B 837.1 F 832.5
23	10 363.6	40 330	B 835.6 F 831
24	10 366.7	40 312.9	B 835.1 F 830.5
25	10 354.3	40 306.3	B 833.1 F 828.5
26	10 312	40 330.4	B 826.1 F 821.5
27	10 305	40 280	B 825.1 F 820.5
28	10 281.1	40 323.9	B 817.6 F 813
29	10 299.6	40 333.8	B 814.6 F 810
30	10 307	40 352.3	B 813.6 F 809

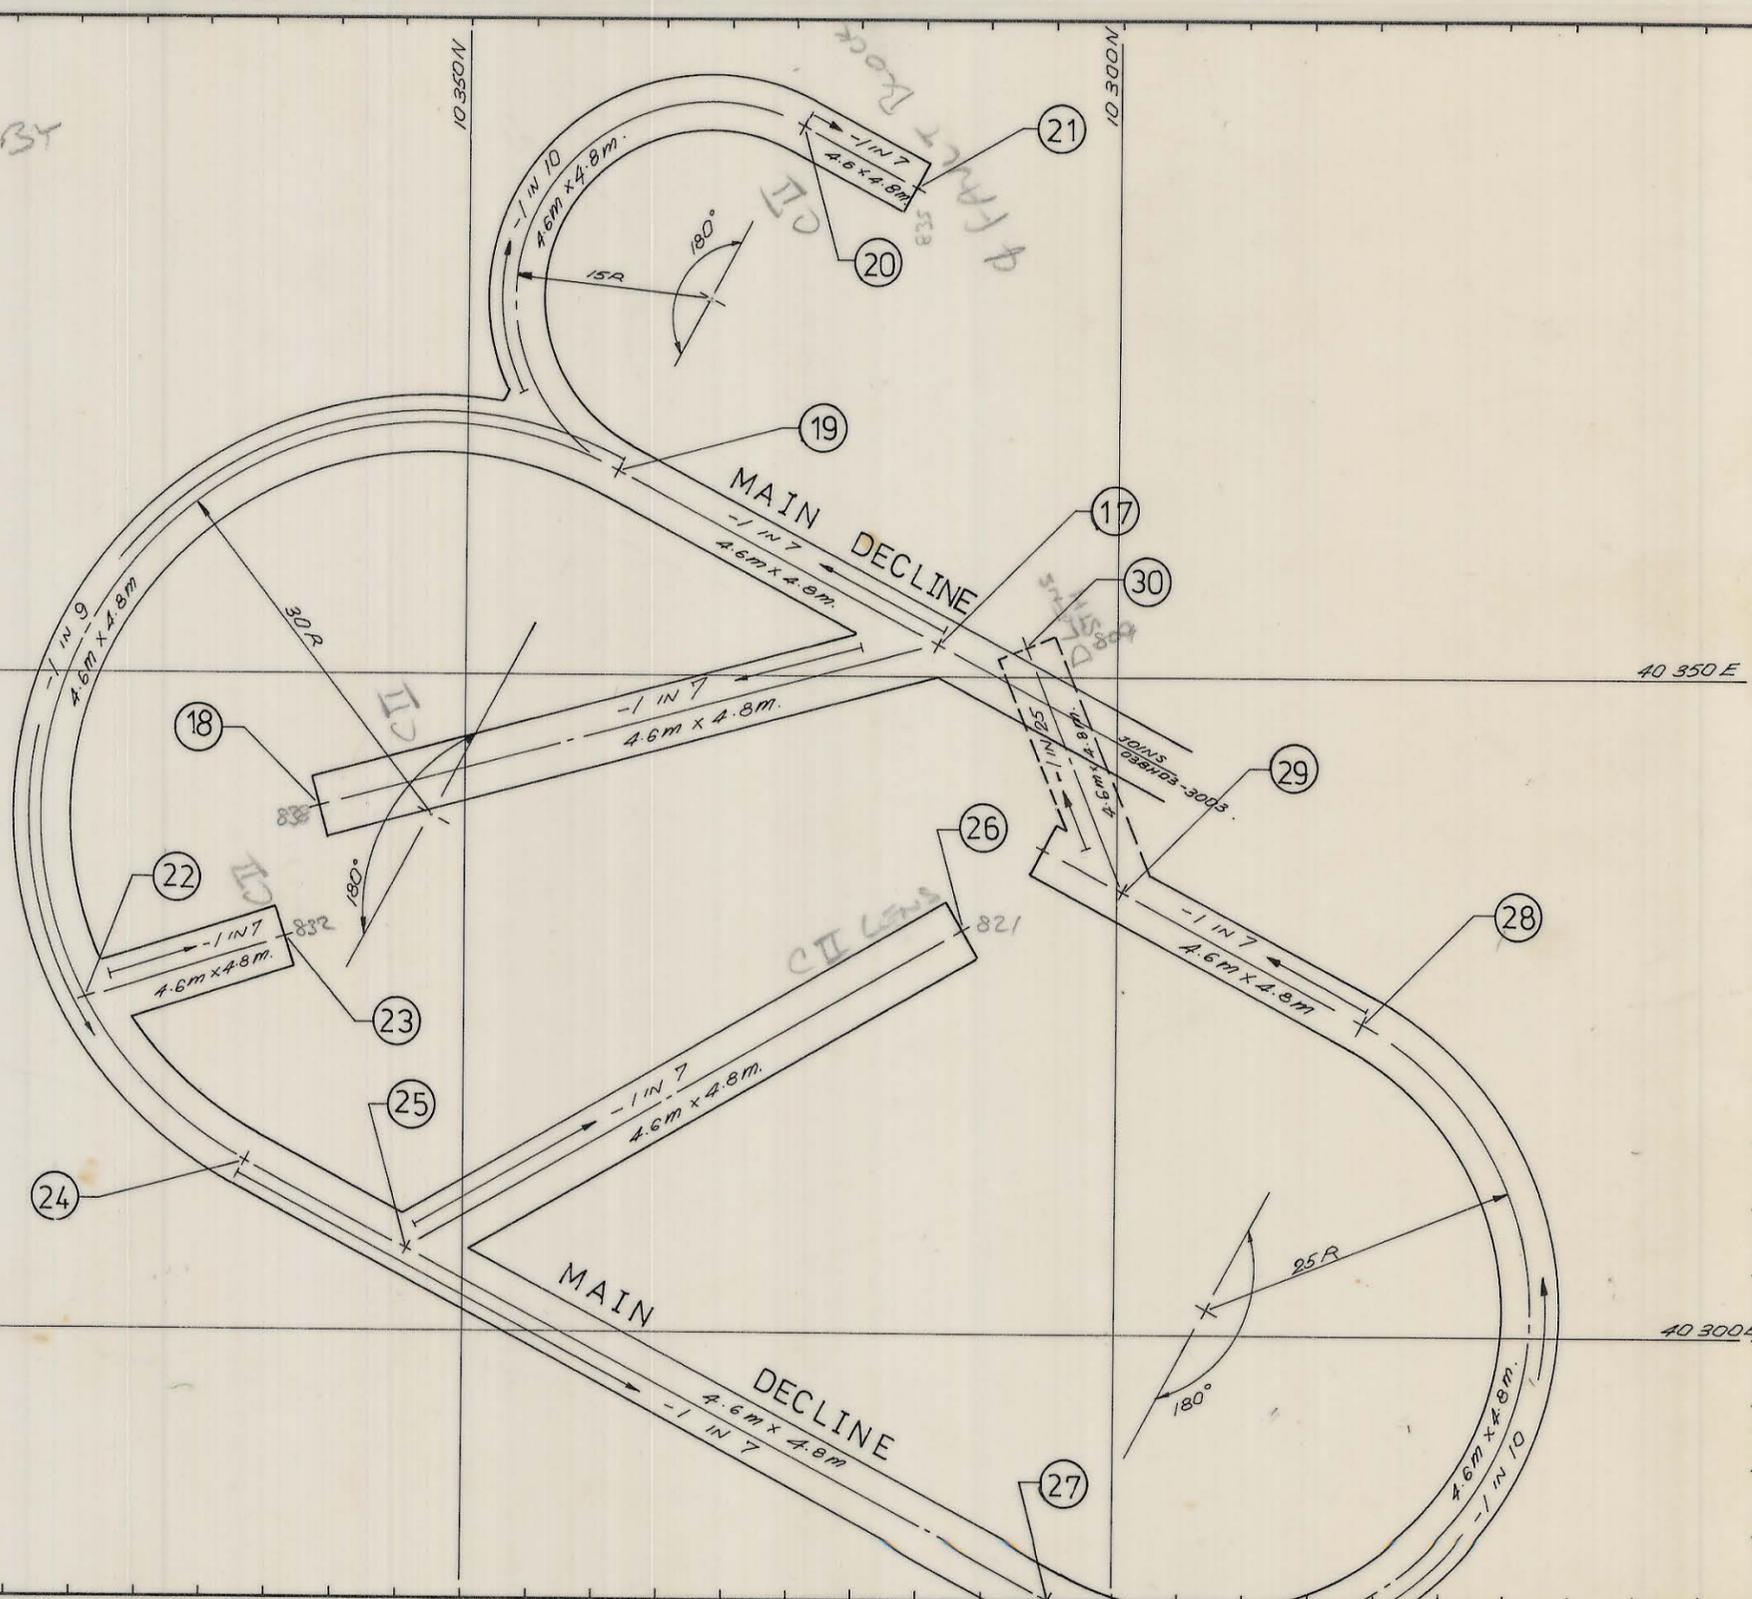

REF PLAN

GEOLOGY

SURVEY

PLANNING

ROCK MEC.

GRADE CON.

DRAFTING

T.S.S.

SCALE 1:

500

**KIS** KING ISLAND SCHEELITE  
GRASSY KING ISLAND

BOLD HEAD MINE.  
MAIN DECLINE.

DRAWING NUMBER

03BH03 - 3004