


0374_4111

5 cm

03BH03-3006

| POINT NO | EAST | NORTH | FLOOR RL |
|----------|---------|---------|----------|
| 1 | 40327.0 | 10370.2 | 871.8 |
| 2 | 40315.8 | 10402.5 | 861.5 |
| 3 | 40338.6 | 10367.8 | 871.8 |
| 4 | 40382.0 | 10332.0 | 865.0 |

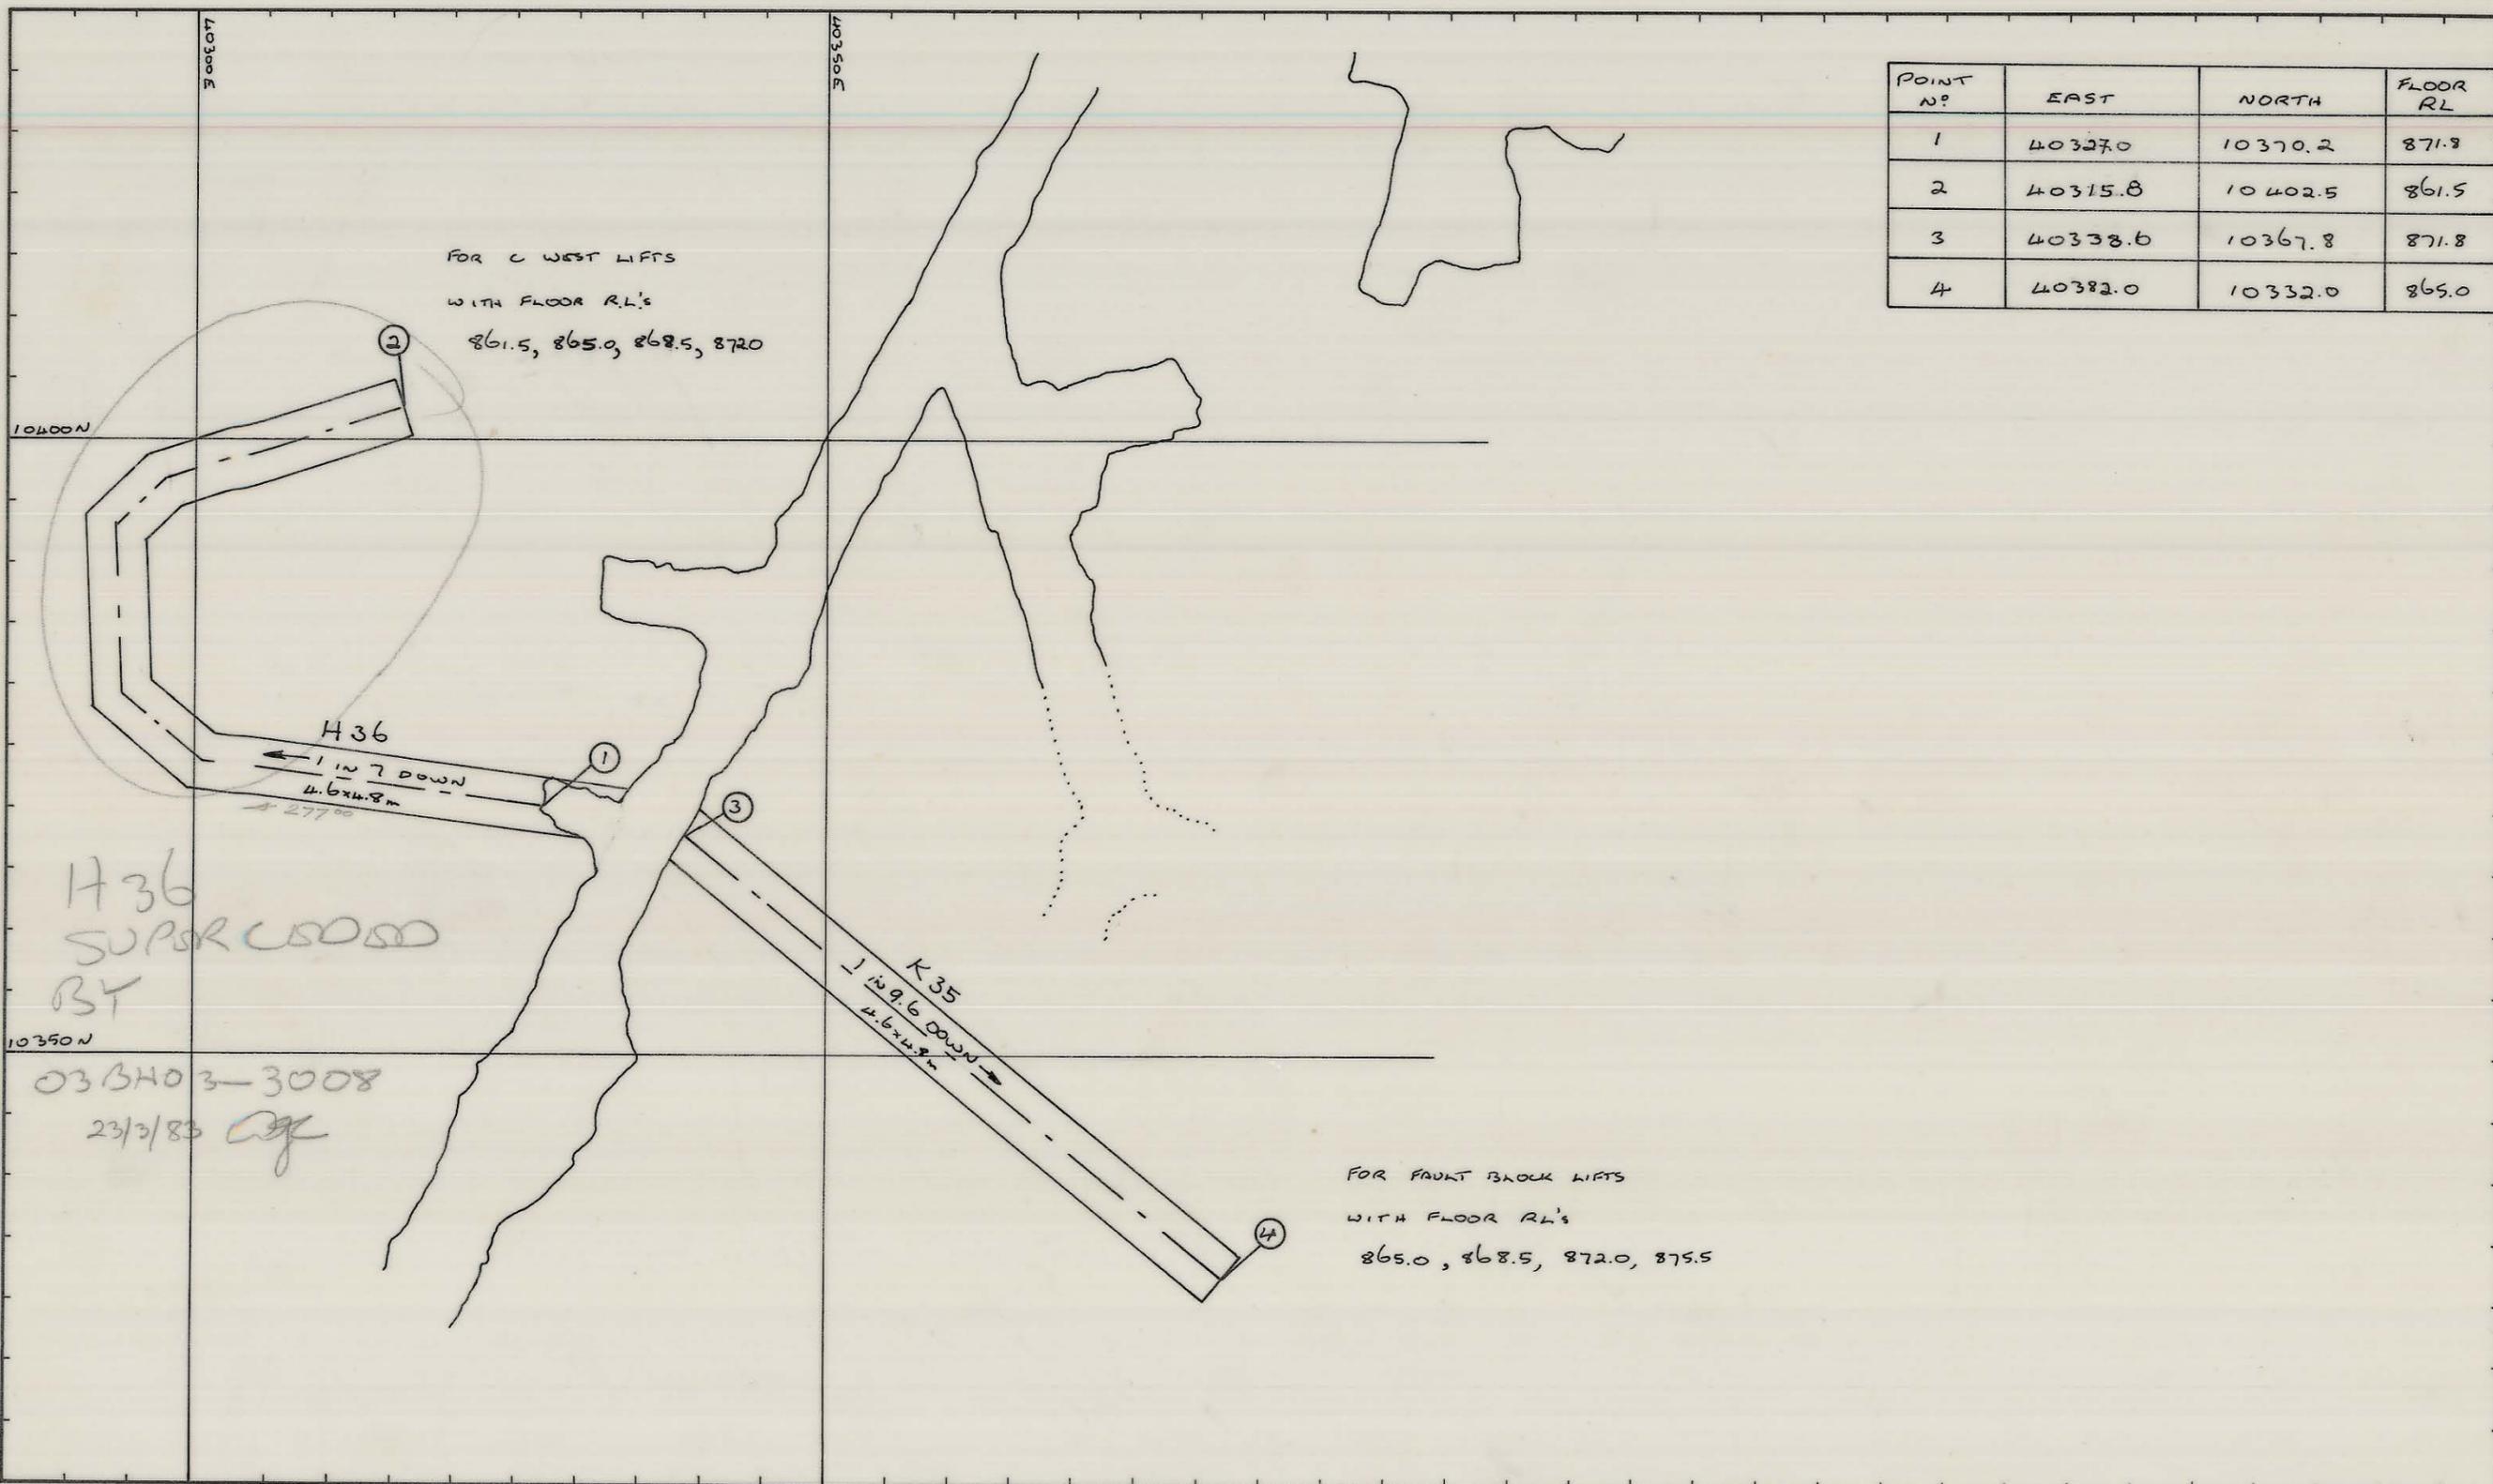

REF PLAN

| | | |
|------------|------------|---------|
| GEOLOGY | | |
| SURVEY | | |
| PLANNING | | |
| ROCK MEC. | | |
| GRADE CON. | | |
| DRAFTING | | |
| T.S.S. | <i>agc</i> | 8/12/82 |

SCALE 1:500

KIS KING ISLAND SCHEELITE
GRASSY KING ISLAND

BOLD HEAD MINE
ACCESS TO C WEST AND
FAULT BLOCK

DRAWING NUMBER

03BH03-3006