
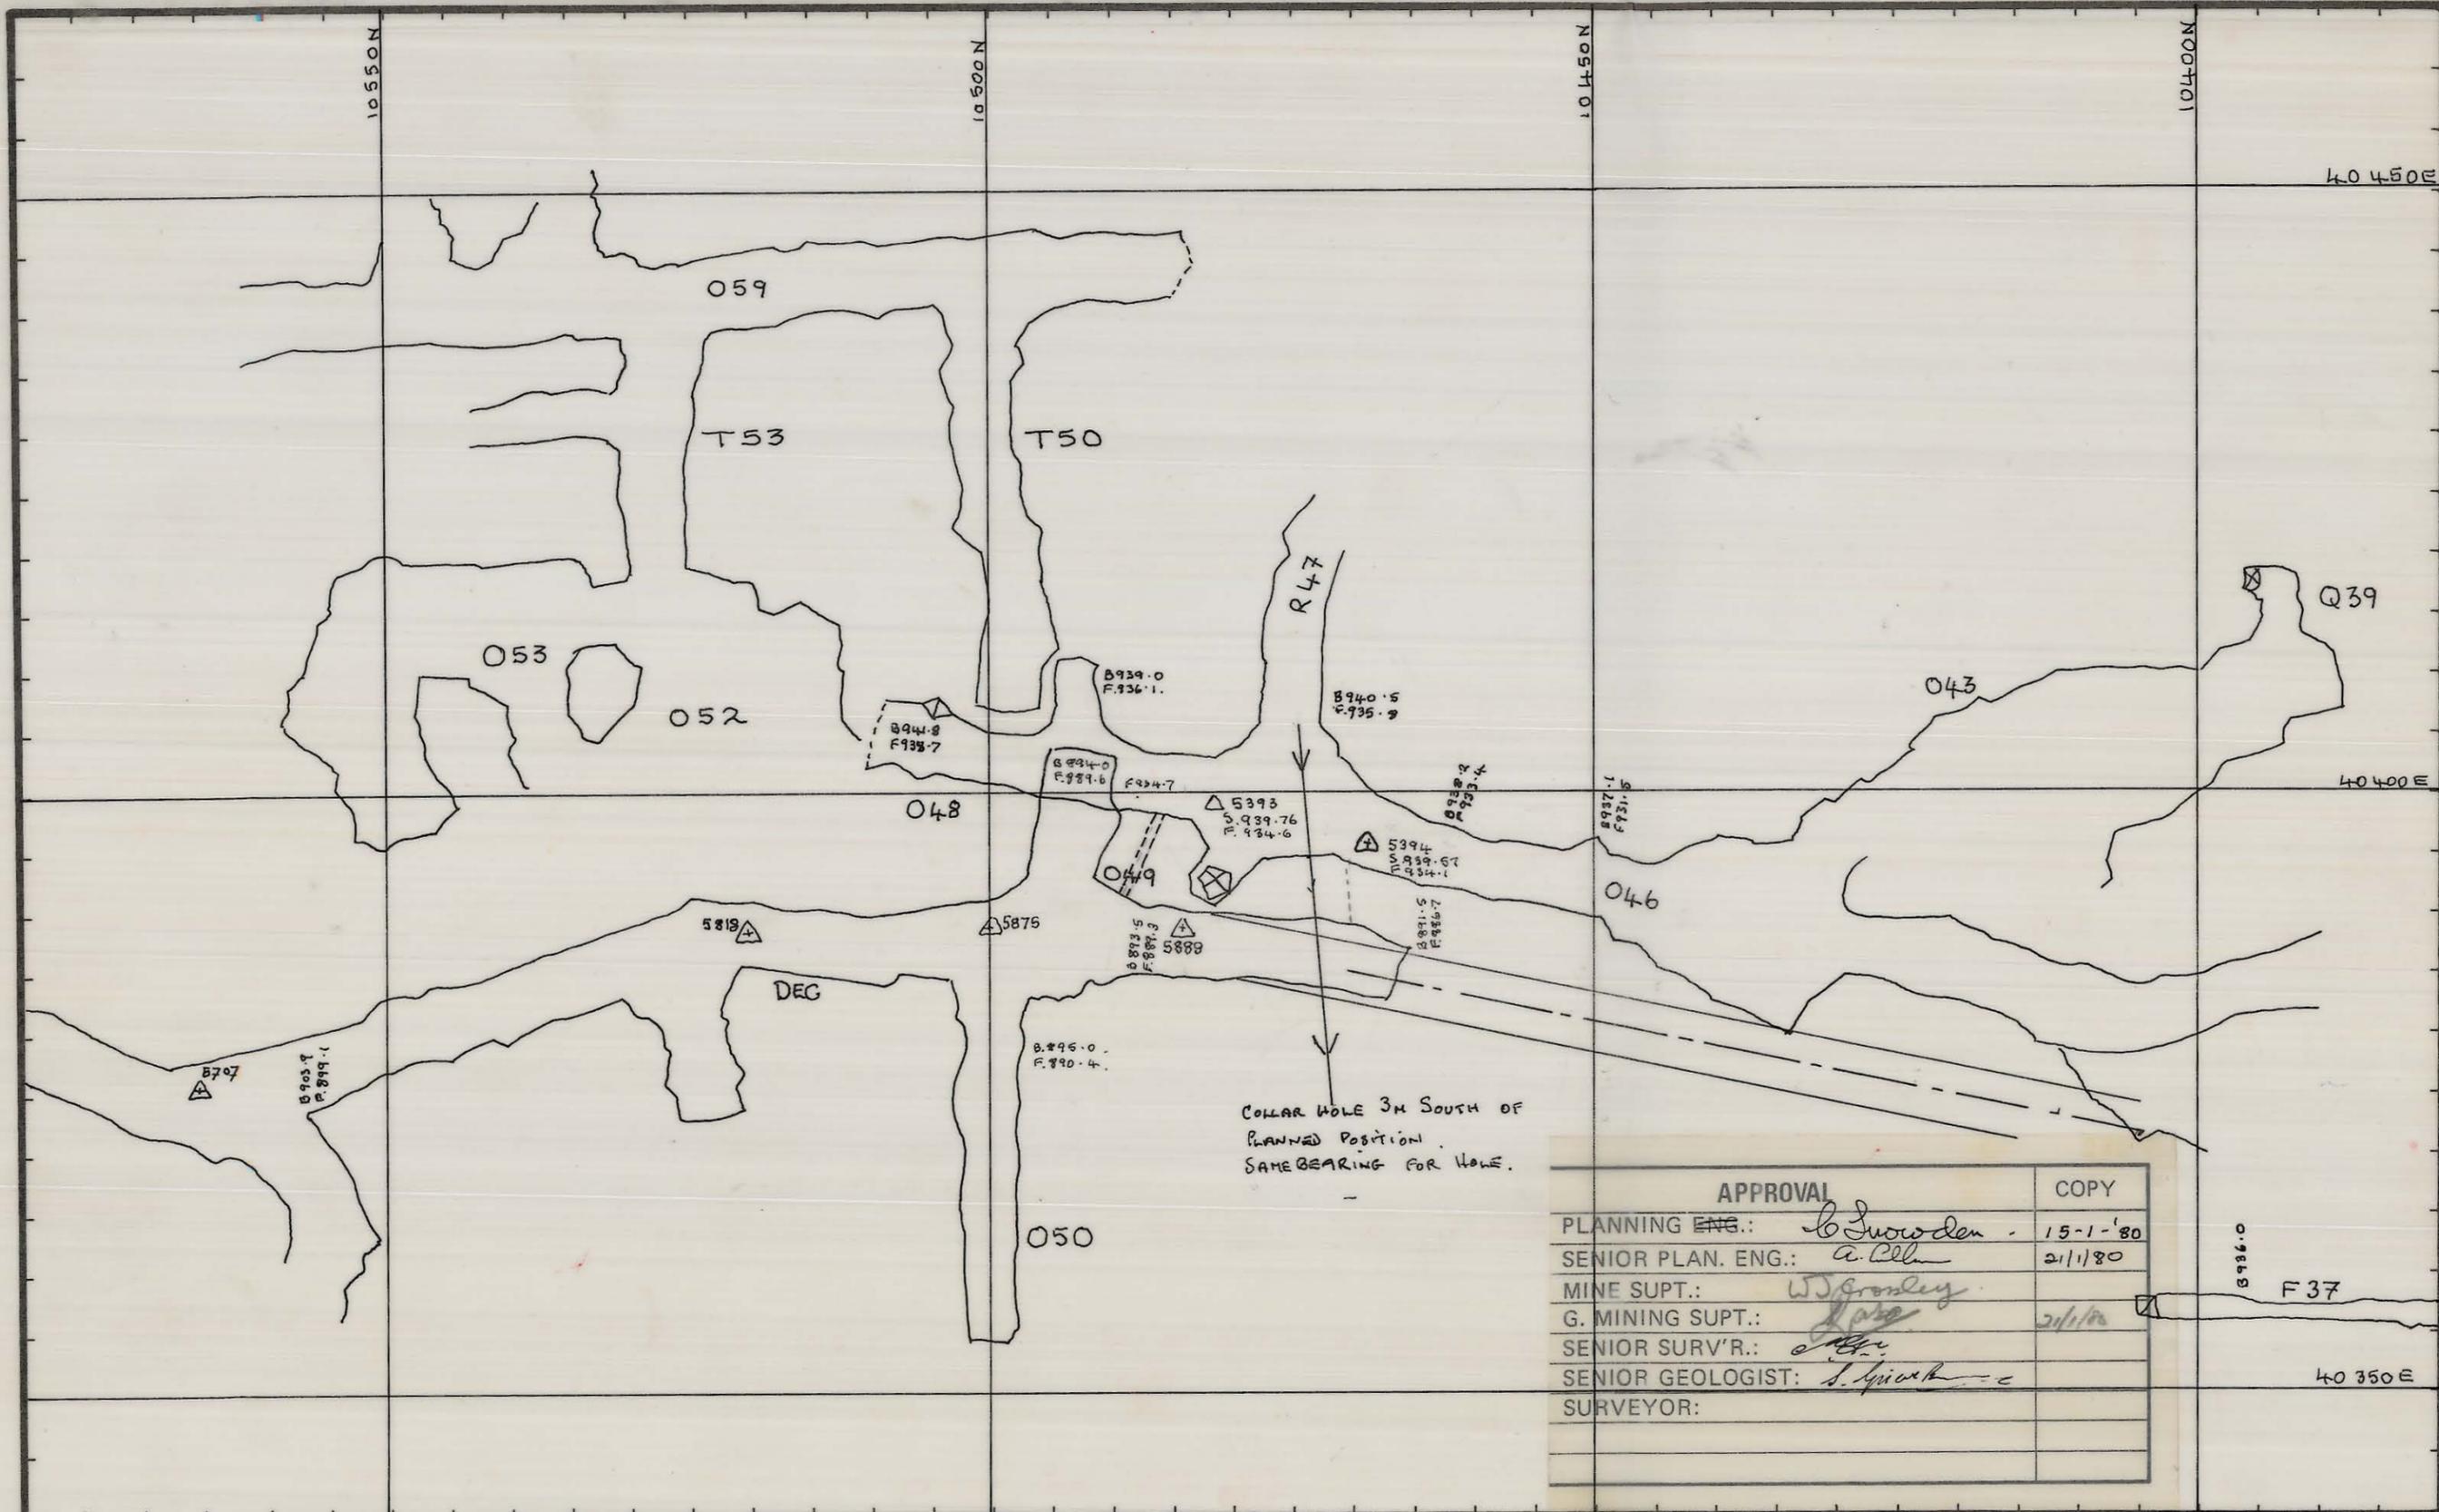



0374_4121

03BH08-4003

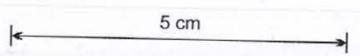

COLLAR HOLE 3M SOUTH OF PLANNED POSITION. SAME BEARING FOR HOLE.

APPROVAL	COPY
PLANNING ENG.: <i>B. Snowden</i>	15-1-'80
SENIOR PLAN. ENG.: <i>A. Bell</i>	21/1/80
MINE SUPT.: <i>W. J. Granley</i>	
G. MINING SUPT.: <i>[Signature]</i>	21/1/80
SENIOR SURV'R.: <i>[Signature]</i>	
SENIOR GEOLOGIST: <i>[Signature]</i>	
SURVEYOR:	

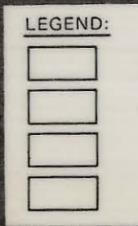

TARGET IS PLANNED TO BARK INTO DECLINE 3.5M FROM FLOOR.

ANNEXED HOLE.

S.P.	N 10	486	E 40	398.0
TARG.	N 10	489	E 40	391.5
HOLE LENGTH	42.7M			
ANGLE	81° 14'			

HOLE LENGTH 43.29M.

ANGLE 83° - 22' - 03"

GO-ORDS.

S.P.	N 10	473.5	E 40	394.5
TG.	N 10	473.0	E 40	389.5
BEARING.	264° 17'			

Scale: _____ NO K4003

DATE: 15-1-80

GEOLOGIST: _____

DWN: _____

CHKD: _____

FAULT BLOCK DRAINAGE FROM O48 TO DECLINE APPROX. R/Ls, 934 TO 896.