


0374\_4127

5 cm

03BH03-3003

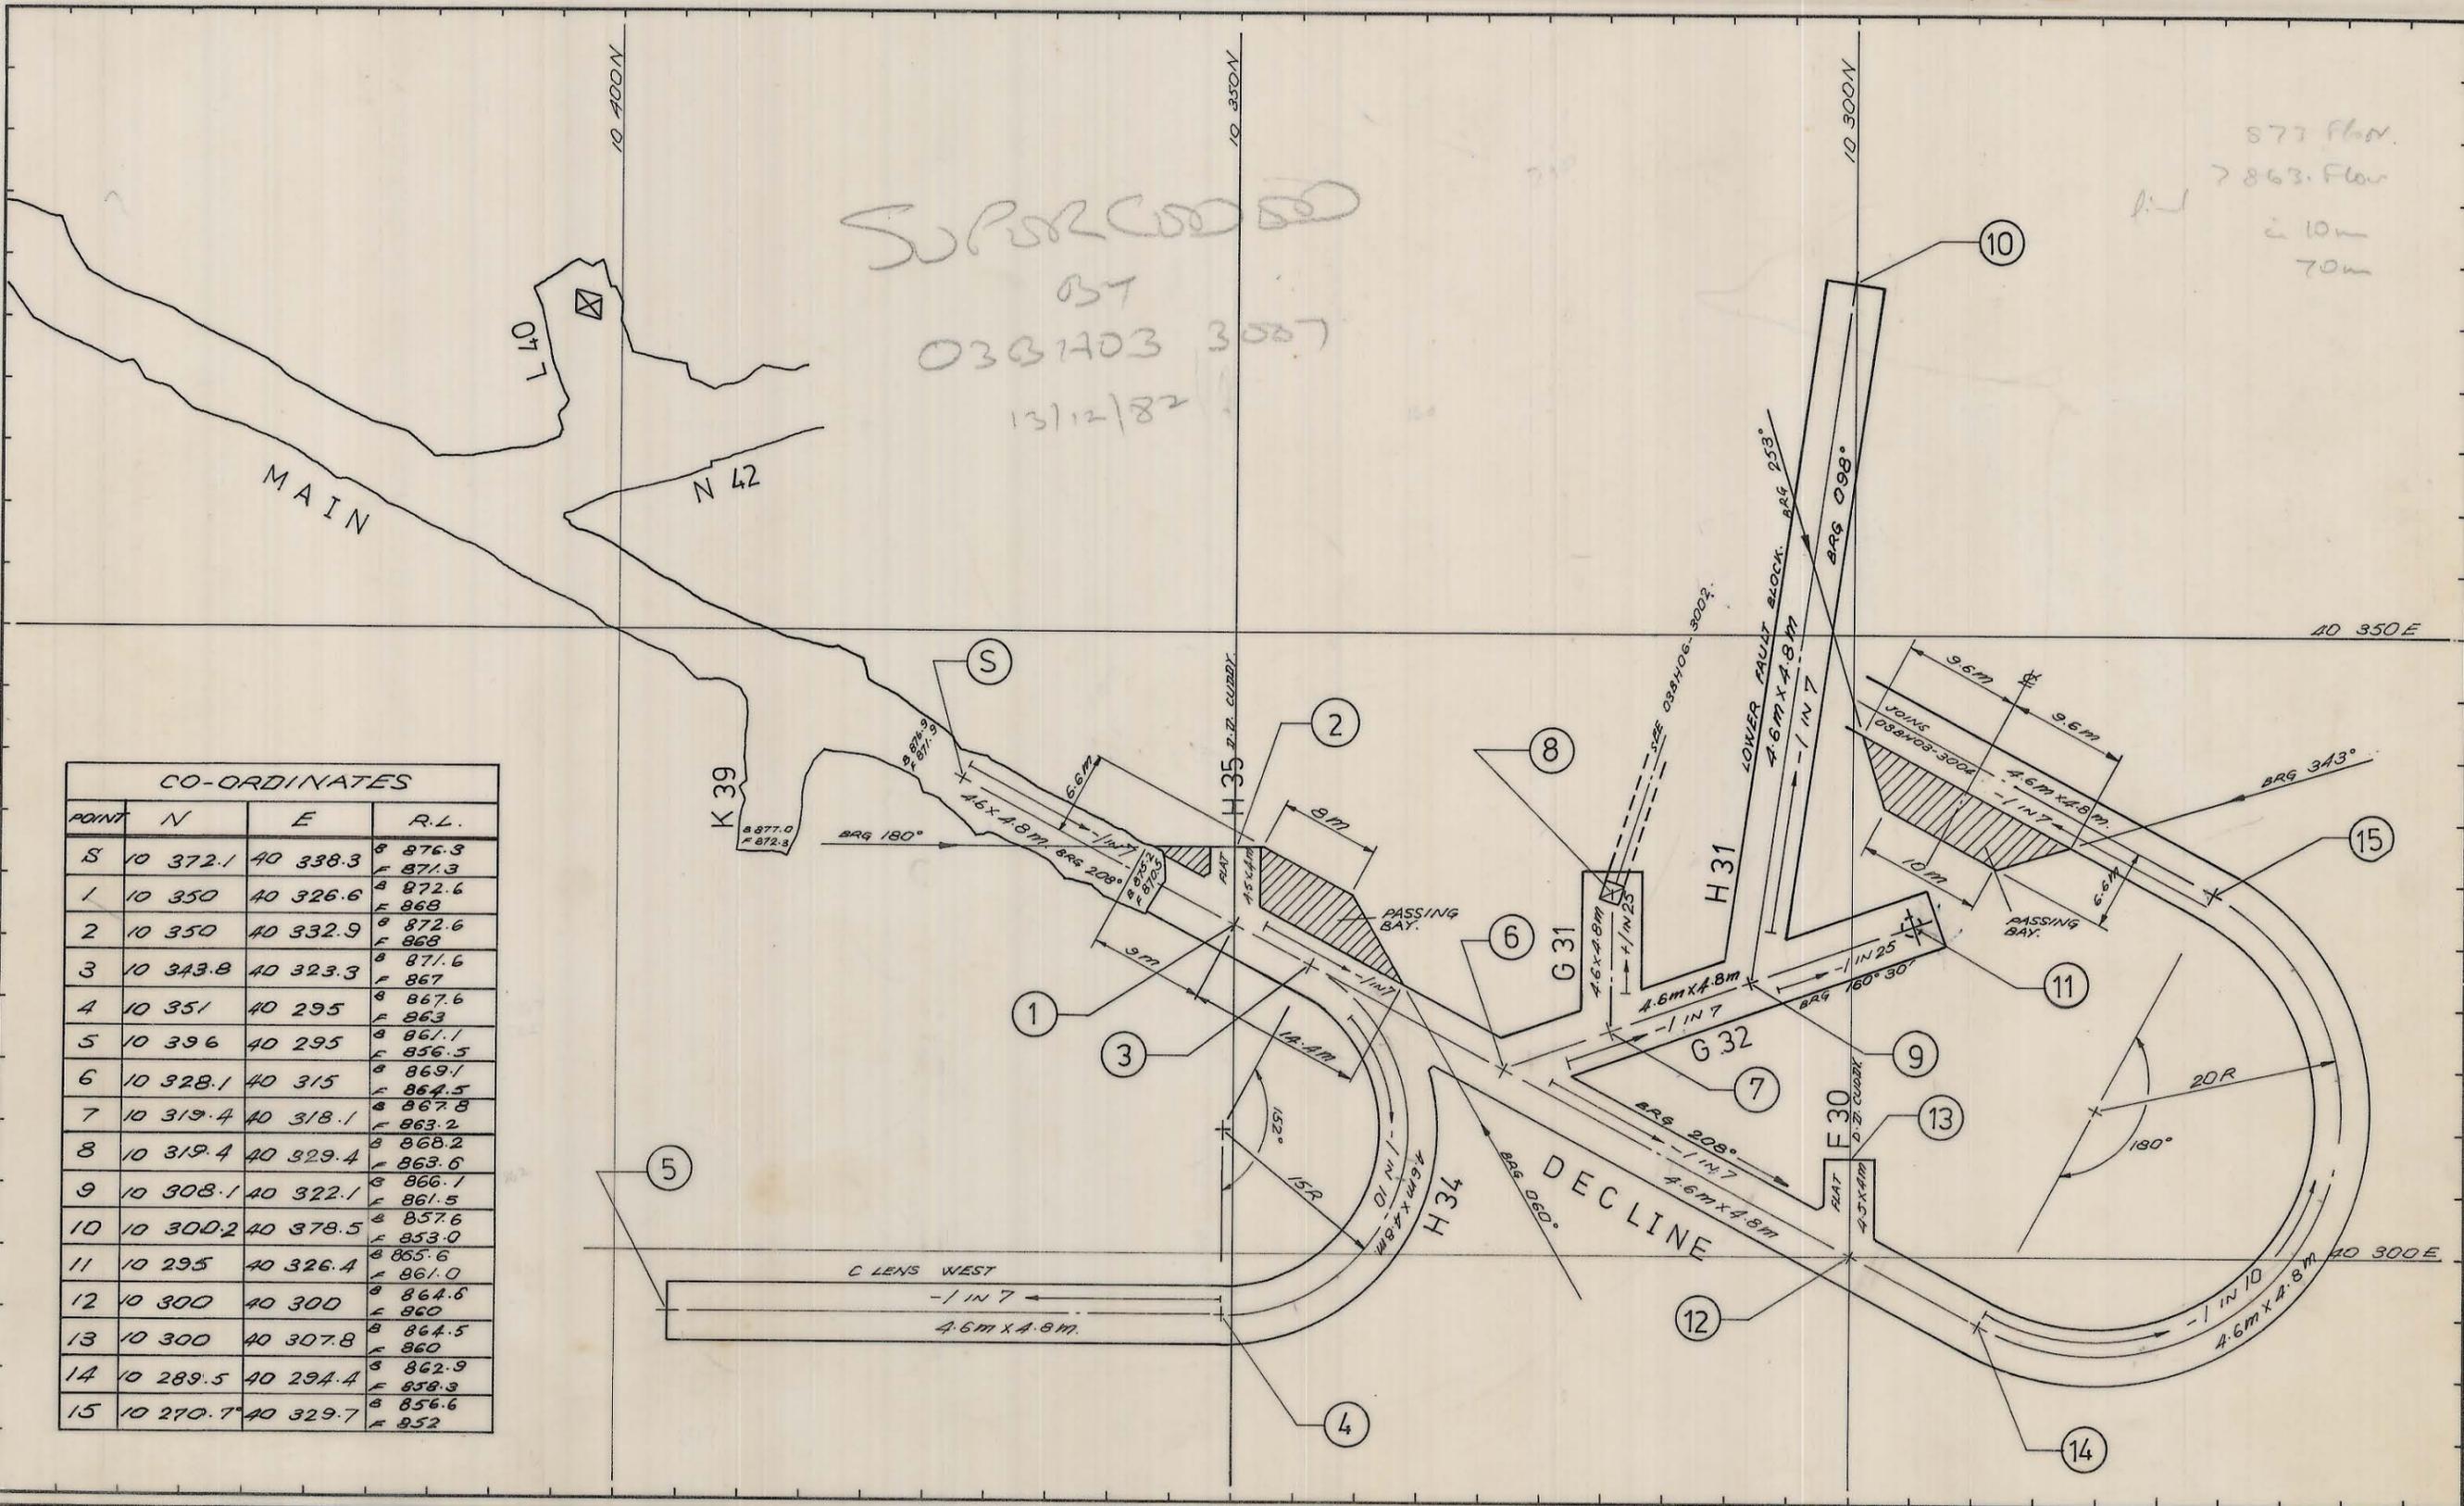

N.B. ALL DIMENSIONS ARE IN METRES.

REF. PLAN 04BH14-1014

GEOLOGY	Terry F. P. 3 <sup>rd</sup> 11/81
SURVEY	7/5/81
PLANNING	P. 11/5/81
ROCK MEC.	11/5/81
MINE SUPT.	11/5/81
G.M.S.	11/5/81
T.S.S.	15/5/81

SCALE 1:500

KIS KING ISLAND SCHEELITE GRASSY KING ISLAND

BOLD HEAD MINE  
MAIN DECLINE

DRAWING NUMBER

03BH03-3003